

# Addendum 02

DOCUMENT 00 91 00

**DATE:** April 13, 2026

**PROJECT:** Jennings County Entrance Security Renovations  
34 West Main Street  
North Vernon, Indiana 47265

**PROJECT #:** 25064.00

**OWNER:** Jennings County School Corporation  
Contact: Philip Marsh  
34 West Main Street  
North Vernon, Indiana 47265

**ARCHITECT:** Garmann Miller  
38 South Lincoln Drive  
P.O. Box 71  
Minster, Ohio 45865

**TO:** Prospective Bidders

This addendum form is a part of the Contract Documents and modifies the Construction Documents dated March 26, 2026, with amendments and additions noted below.

Acknowledge receipt of this Addendum on the Bid Form. Failure to do so may disqualify the Bidder.

This addendum consists of 2 pages, 1 specification section, and 14 re-issued drawing sheets.

## FOR INFORMATION ONLY

1. N/A

## CHANGES TO THE PROJECT MANUAL

1. Section 00 73 00 AIA A201 Supplementary Conditions
  - a. Add Article 8 Section 8.4.3 in its entirety.



## CHANGES TO THE DRAWINGS

1. Sheets BC-A6.1, EC-A6.1, GC-A6.1, HS-A6.1, MS-A6.1, S-A6.1, SC-A6.1
  - a. Revise hardware set numbers to reflect hardware specification, as shown on Door Schedule and Details Drawing Sheets.
2. Sheets H-M2.1 and H-ET2.1
  - a. Revised to show existing electric unit heater to remain in H104 and demolition of the electric unit heater in H106.
3. Sheet H-A1.1
  - a. Revised stud wall types.
  - b. Added keynotes 02 41 00.I21 to remove vinyl wallcovering to Demolition Plan.
4. Sheet H-A9.1
  - a. Update flooring product name from LVT2 to LVT8 and flooring product information on the finish plan.
  - b. Addition of keynote 09 91 23.B4 to Finish Plan.
5. Sheet HS-A1.1
  - a. Added room tags to drawing 2.
  - b. Added resilient flooring and wall base demolition scope to rooms HS103-HS109 Demolition Plan.
  - c. Added demolition keynotes 02 41 00.J2 and 02 41 00.L7.
6. Sheet HS-A9.1
  - a. Moved Reflected Ceiling plan from sheet HS-A1.1 to HS-A9.1, detail 2.
  - b. Update Finish Material Tags in rooms HS103-HS109 on detail 1.
  - c. Update product information for LVT4, and add product information for RB10 to Finish Material Schedule
7. SC-A9.1
  - a. Update LVT4 product information on the Finish Material Schedule.

## ATTACHMENTS

The following attachments are included and are part of this addendum:

Specification Sections: 00 73 00

Drawing Sheets: BC-A6.1, EC-A6.1, GC-A6.1, HS-A6.1, MS-A6.1, S-A6.1, SC-A6.1, H-M2.1, H-ET2.1, H-A1.1, H-A9.1, HS-A1.1, HS-A9.1, SC-A9.1

## END OF ADDENDUM



## **SECTION 00 73 00 - SUPPLEMENTARY CONDITIONS**

### **MODIFICATIONS TO AIA**

These Supplementary Conditions amend or supplement the General conditions of the Contract for Construction (AIA Document A201, 2017 edition) and other provisions of the Contract Documents as indicated below. All provisions which are not so amended or supplemental remain in full force and effect.

The terms used in these Supplementary Conditions which are defined in the General Conditions of the Contract of Construction (AIA Document A201, 2017 Edition) have the meanings assigned to them in the General Conditions.

### **ARTICLE 1 - GENERAL PROVISIONS**

Paragraph 1.1 Basic Definitions: Add the following paragraphs

1.1.9 Furnish: The term 'furnish' shall mean to purchase and deliver product to the site ready for installation.

1.1.10 Install: The term 'install' shall mean to take furnished product and assemble, erect, secure in place, connect in operation as applicable.

1.1.11 Provide: The term 'provide' shall mean to furnish and install.

Paragraph 1.2 Correlation and Intent of the Contract Documents:

Add the following paragraph 1.2.1.1

1.2.1.1 In the event of inconsistencies within or between the Contract Documents, the Contractor shall provide the better quality or greater quantity of Work and shall comply with the stricter requirements.

### **ARTICLE 2 - OWNER**

Paragraph 2.1.2.1; Add the following:

The Owner shall prepare a Notice of Commencement for the Project and provide a copy to the Contractor.

Add paragraph 2.1.3

2.1.3 The Owner shall mean:

Jennings County School Corporation  
Administration Office, 34 West Main Street  
North Vernon, Indiana 47265

Paragraph 2.3.4: Modify to read

2.3.4 The owner shall not be responsible for furnishing surveys or other information as to the physical characteristics, legal limitations, or utility locations for the Project site, except as included in the Contract Documents. The Contractor shall confirm the location of each utility.

### **ARTICLE 3 - CONTRACTOR**

Article 3.2 Review of Contract Documents and Field Conditions by Contractor.

Add the following paragraph 3.2.2.1

3.2.2.1 If the contractor finds any perceived conflict, error, omission or discrepancy on, or between the drawings, specifications, or any of the contract documents, the contractors, before proceeding with the work, shall submit a request to the architect for an interpretation or clarification, the contractor shall be responsible for the prompt delivery of such request.

The architect shall respond to the requests for interpretation of the contract documents within three (3) business days.

3.2.2.2 Any interpretation of the Contract Documents made by any party other than the architect or in any manner other than writing, shall not be binding and the contractor shall not rely upon any such interpretation.

Article 3.4 Labor and Material

Paragraph 3.4.2 add the following at the end of the paragraph:

See Substitution Procedures in Section 01 60 00 - Product Requirements for additional requirements.

Add Paragraph 3.4.4

Article 3.5 Warranty

Add the following to paragraph 3.5.1

The contractor shall warranty and guarantee that all work is in conformity with the Contract Documents and free from defects in workmanship, materials and equipment for a period of one (1) year in addition to other warranties and guarantees specified in the Contract Documents. The performance bond will remain in effect during the warranty period

The warranty and guarantee time period shall commence on the date that the Certificate of Substantial Completion is issued by the architect unless otherwise provided in writing.

The warranty and guarantee provided in this article shall be in addition to and not limitation of any other warranty and guarantee or remedy provided by law or by the Contract Documents.

Should defects in the work become apparent within the warranty and guarantee period, the owner shall promptly notify the contractor in writing and provide a copy of the notice to the architect. Within ten (10) days of receipt of the notice, the contractor shall visit the project in the company of the owner to determine the extent of the defects and shall promptly repair or replace the defective work, including adjacent work damaged as a result of such defects and as a result of remedying the defects whether or not such adjacent work was originally provided by the contractor. The contractor shall be responsible for the cost of temporary materials or equipment required during the repair or replacement of the defective work.

If the defective work is considered by the Owner to be an emergency, the owner may require the contractor to visit the project within one (1) day of receipt of the notice.

Work which is repaired or replaced by the contractor shall be inspected and accepted by the Owner. The repaired and replaced work shall be guaranteed by the contractor for one (1) year from the date of acceptance by the owner.

Article 3.6 Taxes

Add the following:

The Contractor acknowledges that the Owner is a political subdivision of the State of Indiana or tax exempt organization and is exempt from state sales, use and commercial activity taxes. Upon written request, the Owner will provide the Contractor with an applicable certificate of exemption.

Article 3.7 Permits, Fees and Notices

Omit paragraph 3.7.1 and add the following:

3.7.1 The Owner shall secure and pay for the Certificate of Plan Approval and Plumbing Approval as required by the Indiana Building Code. The owner will pay for the sprinkler and fire alarm fees as required by the Indiana Building Code with the sprinkler contractor and the fire alarm contractor submitting drawings and calculations required (seven sets minimum) to the architect. The contractor shall secure and pay for all other building permits, tap fees, user fees, and governmental fees, licenses and inspections.

The contractor is to verify the exact cost of permits, fees, licenses and inspections. No additional cost or change orders will be permitted because of causal or approximated fees or escalation of fees occurring after award of contract.

**Article 3.11 Documents and Samples at the Site**

Add the following paragraph 3.11.1

3.11.1 The Contractor shall maintain readily accessible to the authorities having jurisdiction, the Architect, and the Owner drawings, project manual and related documents approved by appropriate building departments and authorities having jurisdiction.

**Article 3.12 Shop Drawings, Product Data and Samples**

Add the following paragraph 3.12.11

3.12.11 Refer to Section 01 30 00 Administrative Requirements for additional requirements.

**Article 3.13 Use of the Site**

Add the following paragraphs

3.13.1 Damage to road, features, or the grounds, resulting from hauling, storage of materials, or other activities connected with the work shall be repaired by the contractor at his expense to the satisfaction of the Architect.

3.13.2 The contractor and any entity for whom the contractor is responsible shall not erect any sign at the project site without the consent of the owner.

**Article 3.16 Access to Work**

Add the following to paragraph 3.16

The contractor shall provide proper facilities for such access and observation.

Add the following paragraph 3.16.1

3.16.1 The Contractor shall provide access to the work in preparation and progress as required for special inspection required by the building department or authority having jurisdiction.

**ARTICLE 4 - ARCHITECT**

**Article 4.1.1**

Add the following paragraph 4.1.1.1

4.1.1.1 Architect shall mean: Garmann/Miller and Associates, Inc., 38 South Lincoln Drive, Minster, Ohio 45865

**ARTICLE 8 - TIME**

Add the following to Article 8.4

**8.4.Liquidated Damages**

8.4.1 Upon Failure to have all work substantially completed within the time period stated, or failure to have the applicable portion of the work substantially complete upon any milestone date, the Owner shall be entitled to retain or recover from the Contractor, as Liquidated Damages, and not as a penalty, the applicable amount set forth in the following table for each and every calendar day thereafter until Contract Completion, unless an extension of time is granted in accordance with the Contract Documents.

Dollars per Day:

Contract Amount	Dollars per Day
less than \$50,000.00	\$300.00
More than \$50,000.00 to \$150,000.00	\$500.00
More than \$150,000.00 to \$500,000.00	\$1000,00

More than \$500,000.00 to \$2,000,000.00	\$2,000.00
More than \$2,000,000.00 to \$5,000,000.00	\$3,000.00
More than \$5,000,000.00	\$4,000.00

8.4.2 The amount of Liquidated Damages is agreed upon by and between the Contractor and the Owner because of the impracticality and extreme difficulty of ascertaining the actual amount of damage the Owner would sustain.

8.4.3 The preferred schedule is for all project locations to be completed by the substantial completion date. Should construction need to extend beyond this date, work is only permitted to occur when school is not in session (during breaks and summer of 2027.) Liquidated damages apply to any construction extending into the school year without prior written approval/coordination with the owner.

**ARTICLE 9 PAYMENT AND COMPLETION**

**ARTICLE 9.3 - Applications for Payment**

Add the following to Article 9.3.1

9.3.1.3 The form of Application for Payment will be a notarized AIA Document G702, Application and Certificate for Payment with AIA Document G703, Continuation Sheet. Applications for payment shall be made at approximately 30 day intervals. The contractor shall submit in triplicate the Application for Payment and Continuation Sheet. The Continuation Sheet (G703) shall be prepared the same as the Schedule of Values.

9.3.1.4 Contractor shall submit with each Application for Payment a notarized affidavit that payroll, bills for equipment, material and any other indebtedness connected with the work for which the previous Applications for Payment submitted and the owner might any way be responsible, have been paid. Also, submit release of liens arising out of the contract from each subcontractor, supplier, material person and laborer of the contract.

9.3.1.5 Schedule of Values (AIA Form G703 - Application and Certificate for Payment Continuation Sheet) shall utilize the table of contents of the Project Manual to identify each line item with title and number of the specification Section. Each line item including subcontracted work shall be shown with separate amounts for labor and material.

9.3.1.5.1 Identify on separate line items; Bonds, Insurance, Permits, Allowances, Site Mobilization, and Project Closeout (punch list, attic stock, project record drawings, training, final cleaning).

9.3.1.5.2 If the project is of sufficient size or nature, the Schedule of Values various items shall be subdivided into areas or units when requested by the Architect.

9.3.1.5.3 The architect reserves the right to use the approved Schedule of Values to determine the cost or credit resulting from any changes to the Work.

9.3.1.6 Labor Payments - Partial payments for labor performed under lump sum contract shall be made at the rate of 92 percent of the amount invoiced through the Application for Payment which shows the total contract completion at 50 percent or greater. After the contract is 50 percent complete, as evidenced by payments in the amount at least 50 percent of the labor contract price to the contractor, no additional funds will be retained. Retained funds will be deposited accordance to Paragraph

9.3.1.8

9.3.1.7 Material Payments - Partial payments for materials delivered on the site, or other point in the vicinity of the Project, or otherwise stored, as approved by the

Architect, under lump sum contract shall be made at the rate of 92 percent of the amount invoiced. Payment for material incorporated into the project shall be made at the rate of 100 percent of scheduled value. Retained funds will be deposited accordance to Paragraph 9.3.1.8. The balance such invoiced cost shall be paid when such material is incorporated into and becomes part of the Project.

9.3.1.8 All funds retained shall be deposited in an escrow account with a bank in the state in accordance with the term as, and conditions provided in an escrow agreement executed by the contractor, the Owner and the applicable bank.

9.3.1.9 When the project is complete and there exists no other reason to withhold retainage, the retained percentages held in connection with such portions shall, upon request of the contractor, be released from escrow and paid to the contractor, withholding that amount necessary to assure completion. The amount of fund retained to assure completion of the work shall not be less than two (2) times the value of the work as determined by the Architect and Owner.

Add the following to paragraph 9.3.2

9.3.2.1 Where it is to the owner's best interest, materials stored off site will receive payment provided the contractor furnished to the owner with the monthly application for payment the following:

A list of the materials consigned to the project giving the place of storage, together with copies of invoices and reasons why materials cannot be delivered to the site.

Certification that all items are tagged for delivery to the project and that they will not be used for any other purpose.

Evidence of adequate insurance covering the material stored naming the owner as additionally insured.

The owner and architect shall have the right to inspect all materials stored.

When payment is allowed on account of material delivered on the site of the work or in the vicinity thereof or under the possession and control of the contractor but not yet incorporated therein, such material shall become the property of the owner, but if such material is stolen, destroyed, or damaged by casualty before being used, the contractor will be required to replace it at the contractor's expense

Add the following to paragraph 9.3.3

9.3.3.1 No materials or supplies for the work shall be purchased by the contractor or any subcontractor subject to any chattel mortgage, under conditional sale contract or other agreement by which an interest is retained by the seller.

## **ARTICLE 11 INSURANCE AND BONDS**

### **11.1 - Contractor's Insurance and Bonds**

Add the following to Article 11.1.1:

11.1.1.1 A commercial general liability policy and business automobile liability policy, separately or combined, shall be maintained to provide insurance as set forth in paragraph 11.1.1.

11.1.1.2 Such commercial general liability and business automobile liability insurance may be either combined single limits or split limits as provided below. An umbrella or excess liability policy may be used in combination with the commercial general liability and business automobile insurance to meet such limits:

Contracts in the maximum of \$100,000 or less shall require coverage in the amount of not less than \$1 million general aggregate and per occurrence.

Contracts in excess of \$100,000 but not more than \$5 million shall require coverage in the amount of not less than \$3 million general aggregate and per occurrence.

Such policies shall be endorsed to provide that the general aggregate limit applies separately to each of the insured contractor's projects.

11.1.1.3 If commercial general liability and business automobile liability insurance is written with split limits, the following minimum limits shall be provided:

Contracts in the amount of \$100,000 or less shall require coverage in the amount of not less than \$500,000 for injuries, including death, to one person, and \$1 million per occurrence and \$500,000 property damage.

Contracts in excess of \$100,000 but not more than \$5 million shall require coverage in the amount of not less than \$1 million for injuries, including death, to one person, and \$1 million per occurrence and \$1 million property damage, together with an umbrella or excess liability policy of not less than \$2 million per occurrence.

11.1.1.4 For any demolition, blasting, excavating, tunneling, shoring or similar operations, the contractor shall provide and maintain property damage liability insurance with a limit of liability equal to such limit as specified in the application sections of paragraphs 11.1.1.2 and 11.1.1.3.

11.1.1.5 Insurance policies shall be written on an occurrence basis only.

11.1.1.6 Products and completed operation coverage shall commence with the certification of final Certificate of Payment to the Contractor and extend for not less than two years beyond that date.

11.1.1.7 The Owner shall be provided a copy of the policy and named as a certificate holder on the policies of insurance which are maintained by the Contractor. The Owner shall be notified of any change in policy coverage.

Omit paragraph 11.1.2 and substitute the following:

11.1.2 The contractor shall furnish surety bonds covering faithful performance of the contract and payment of obligations arising there under. Cost of surety bonds shall be included in contract sum. The amount of each bond shall be equal to one hundred percent (100%) of the contract sum.

11.1.2.1 If at any time the owner for justifiable cause shall be dissatisfied with a surety, or sureties, the contractor shall within five (5) days after notice from the owner, substitute an acceptable bond (or bonds) in such form and sum by another surety or sureties as may be satisfactory to the owner. The premiums on such bond shall be paid by the contractor. No further payments shall be deemed due nor shall be made until the new surety or sureties shall have furnished a acceptable bond to the owner.

11.2 Owners Insurance

11.2.1.1 - Owners Property Insurance Policy (Builders Risk): The Owner shall provide and maintain, during the progress of the work and until the execution of the certificate of substantial completion by the architect, a Property (builder's risk) Insurance Policy to cover all work in the course of construction including falsework, temporary buildings and structures, and materials used in the construction process that are stored on site. Such insurance shall be on a "Risk of Direct Physical Loss" form policy and shall insure against the perils of fire and extended coverage and physical loss or damage including, but not limited to, theft, vandalism, malicious mischief, earthquake, tornado, lightning, explosion, breakage of glass, flood, collapse and water damage. It shall also include debris removal, demolition occasioned by enforcement of an applicable legal requirement, and shall cover reasonable compensation for the state's services and expenses required to limit further loss.

11.2.1.2 - Coverage must include provision to pay the reasonable extra costs of expediting temporary and/or permanent repairs to, or permanent replacement of damaged property. This shall include overtime wages and the extra cost of "express" or other means for rapidly transporting materials and supplies necessary to such repair or replacement.

11.2.1.4 - Coverage for other perils may be required if specified in the special conditions.

Unless otherwise specified in the contract documents, the builder's risk policy shall be written in the amount equal to 100 percent of the contract price, including landscaping, paving and other site work.

11.2.1.5 - The builder's risk policy shall specifically permit and allow for partial occupancy by the owner prior to acceptance of the project by the architect.

11.2.1.6 Property insurance provided by the Owner shall not cover any tools, apparatus machinery, scaffolding, hoist, forms, staging, shoring, and other similar items commonly referred to construction equipment that may be on site and the capital value of which is not included in the Work, nor shall such insurance cover any material or equipment before these materials and equipment are incorporated into the Work. The contractor shall make its own arrangements for any insurance it may require for such construction equipment, materials, and equipment.

## **ARTICLE 15 - ARBITRATION**

15.4 Arbitration: Delete this article. Arbitration is not an acceptable form of binding dispute resolution for this project.

## **GENERAL NOTES**

### **CONDITIONS PRECEDENT FOR EXECUTION OF AGREEMENT**

THE FOLLOWING ITEMS SHALL BE FURNISHED ELECTRONICALLY:

Declaration of Insurance, including property insurance (builders risk)

Indiana Workers Compensation Certificate

A Contract Cost Breakdown Showing itemized Labor & Material amounts for the Total Contract Price

Performance and Payment Bond, Power of Attorney for the bonding agent.

A Certificate of Compliance issued by the Department of Insurance showing the Bonding Co. is licensed to do business in the State of Indiana.

Financial Statement of Bonding Co.

### **DOCUMENTS REQUIRED AFTER ISSUANCE OF NOTICE TO PROCEED**

The architect shall issue a notice to proceed which shall establish the date for commencement of the project time. The contractor will, within 10 days of the date of the Notice to Proceed, furnish the architect ELECTRONICALLY:

A Schedule of Values (AIA Document G703, Continuation Sheet)

A Time Schedule of the Work.

A list of proposed Sub-contractors.

A list of Material Suppliers.

An estimated schedule of monthly payments.

### **DISCRIMINATION AND INTIMIDATION**

The prohibition against discrimination and intimidation on account of race, creed, or color, and the provisions as to forfeitures to be applied in the event of violation of contract regarding same, shall apply to all contracts entered into in conjunction with the work.


## **END OF SECTION**

25064.00 Jennings County  
School Corporation Entrance  
Security Renovations  
Construction Documents -  
Addendum #02


SUPPLEMENTARY  
CONDITIONS

00 73 00 - 7  
April 13, 2026


DOOR/OPENING SCHEDULE																
NUMBER	DOOR				FRAME				HARDWARE	ROOM KEY	FUNCTION	LABEL (MIN)	NOTES			
	SIZE	THK	MATL	TYPE	GLASS	DEPTH	MATL	TYPE						GLASS		
									DETAIL NUMBER							
									HEAD	JAMB	SILL					
BC101A	3'-0" x 7'-0"	1 3/4"	HM	EXIST	EXIST	5 3/4"	HM	EXIST	EXIST	-	-	-	049	Exterior	-	1
BC101B	3'-0" x 7'-0"	1 3/4"	HM	EXIST	EXIST	5 3/4"	HM	EXIST	EXIST	-	-	-	004	Interior	-	1
BC102	3'-0" x 7'-0"	1 3/4"	WD	EXIST	EXIST	5 3/4"	HM	EXIST	EXIST	-	-	-	027	Interior	-	1
BC103A	3'-0" x 7'-0"	1 3/4"	WD	EXIST	EXIST	5 3/4"	HM	EXIST	EXIST	-	-	-	046	Interior	-	1
BC103B	3'-0" x 7'-0"	1 3/4"	WD	EXIST	EXIST	5 3/4"	HM	EXIST	EXIST	-	-	-	036	Interior	-	1
BC105	3'-0" x 7'-0"	1 3/4"	WD	NL	G1	5 3/4"	HM	1	-	1/A6.1	2/A6.1	-	028	BC105	Interior	-
BC107	3'-0" x 7'-0"	1 3/4"	WD	NL	G1	5 3/4"	HM	1	-	1/A6.1	2/A6.1	-	028	BC103	Interior	-

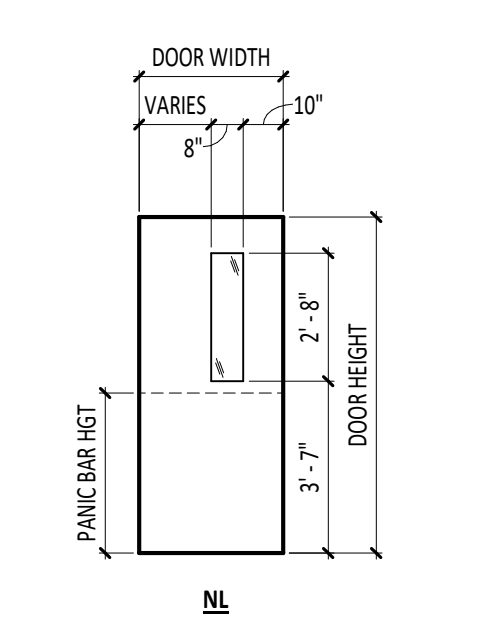


**1 DOOR TYPES**  
NTS  
BC-A6.1

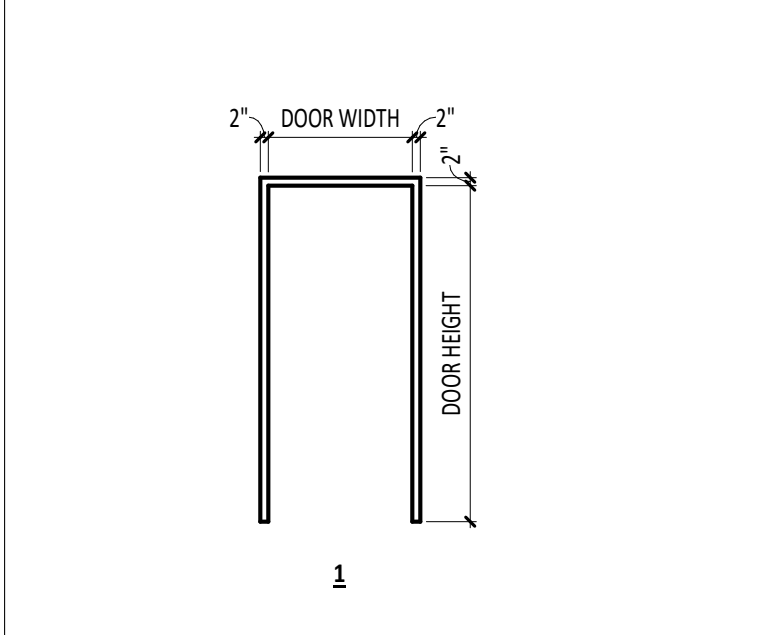


**2 HOLLOW METAL DOOR FRAME TYPES**  
NTS  
BC-A6.1

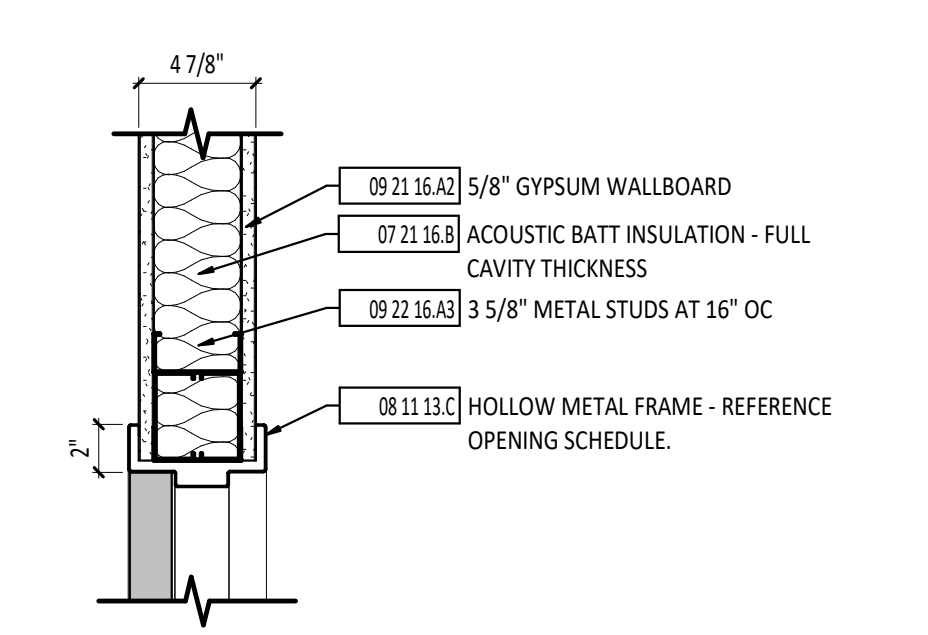


**3 HEAD DETAIL - INTERIOR**  
1 1/2" x 1'-0"  
BC-A6.1

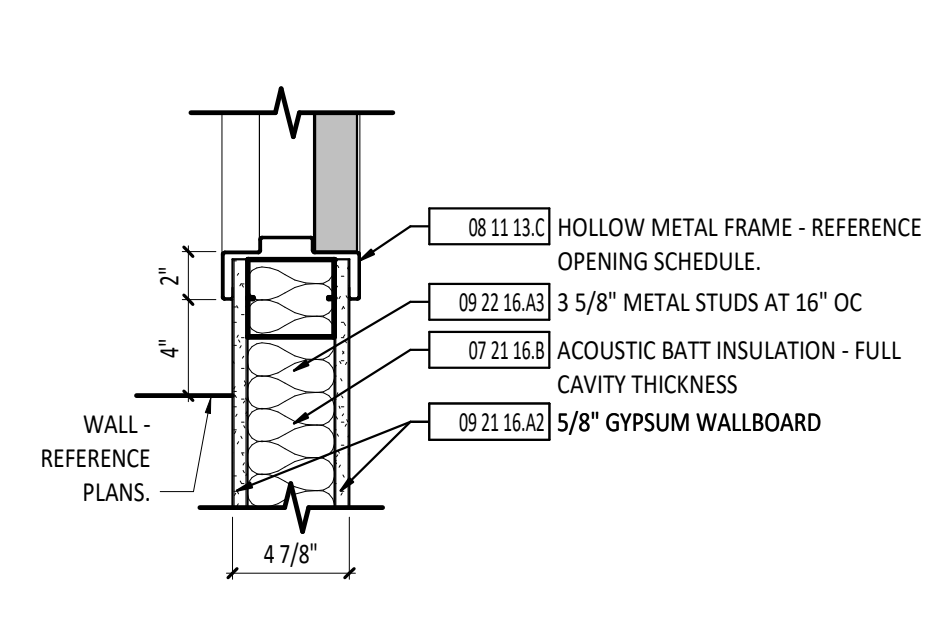

**4 JAMB DETAIL - INTERIOR**  
1 1/2" x 1'-0"  
BC-A6.1

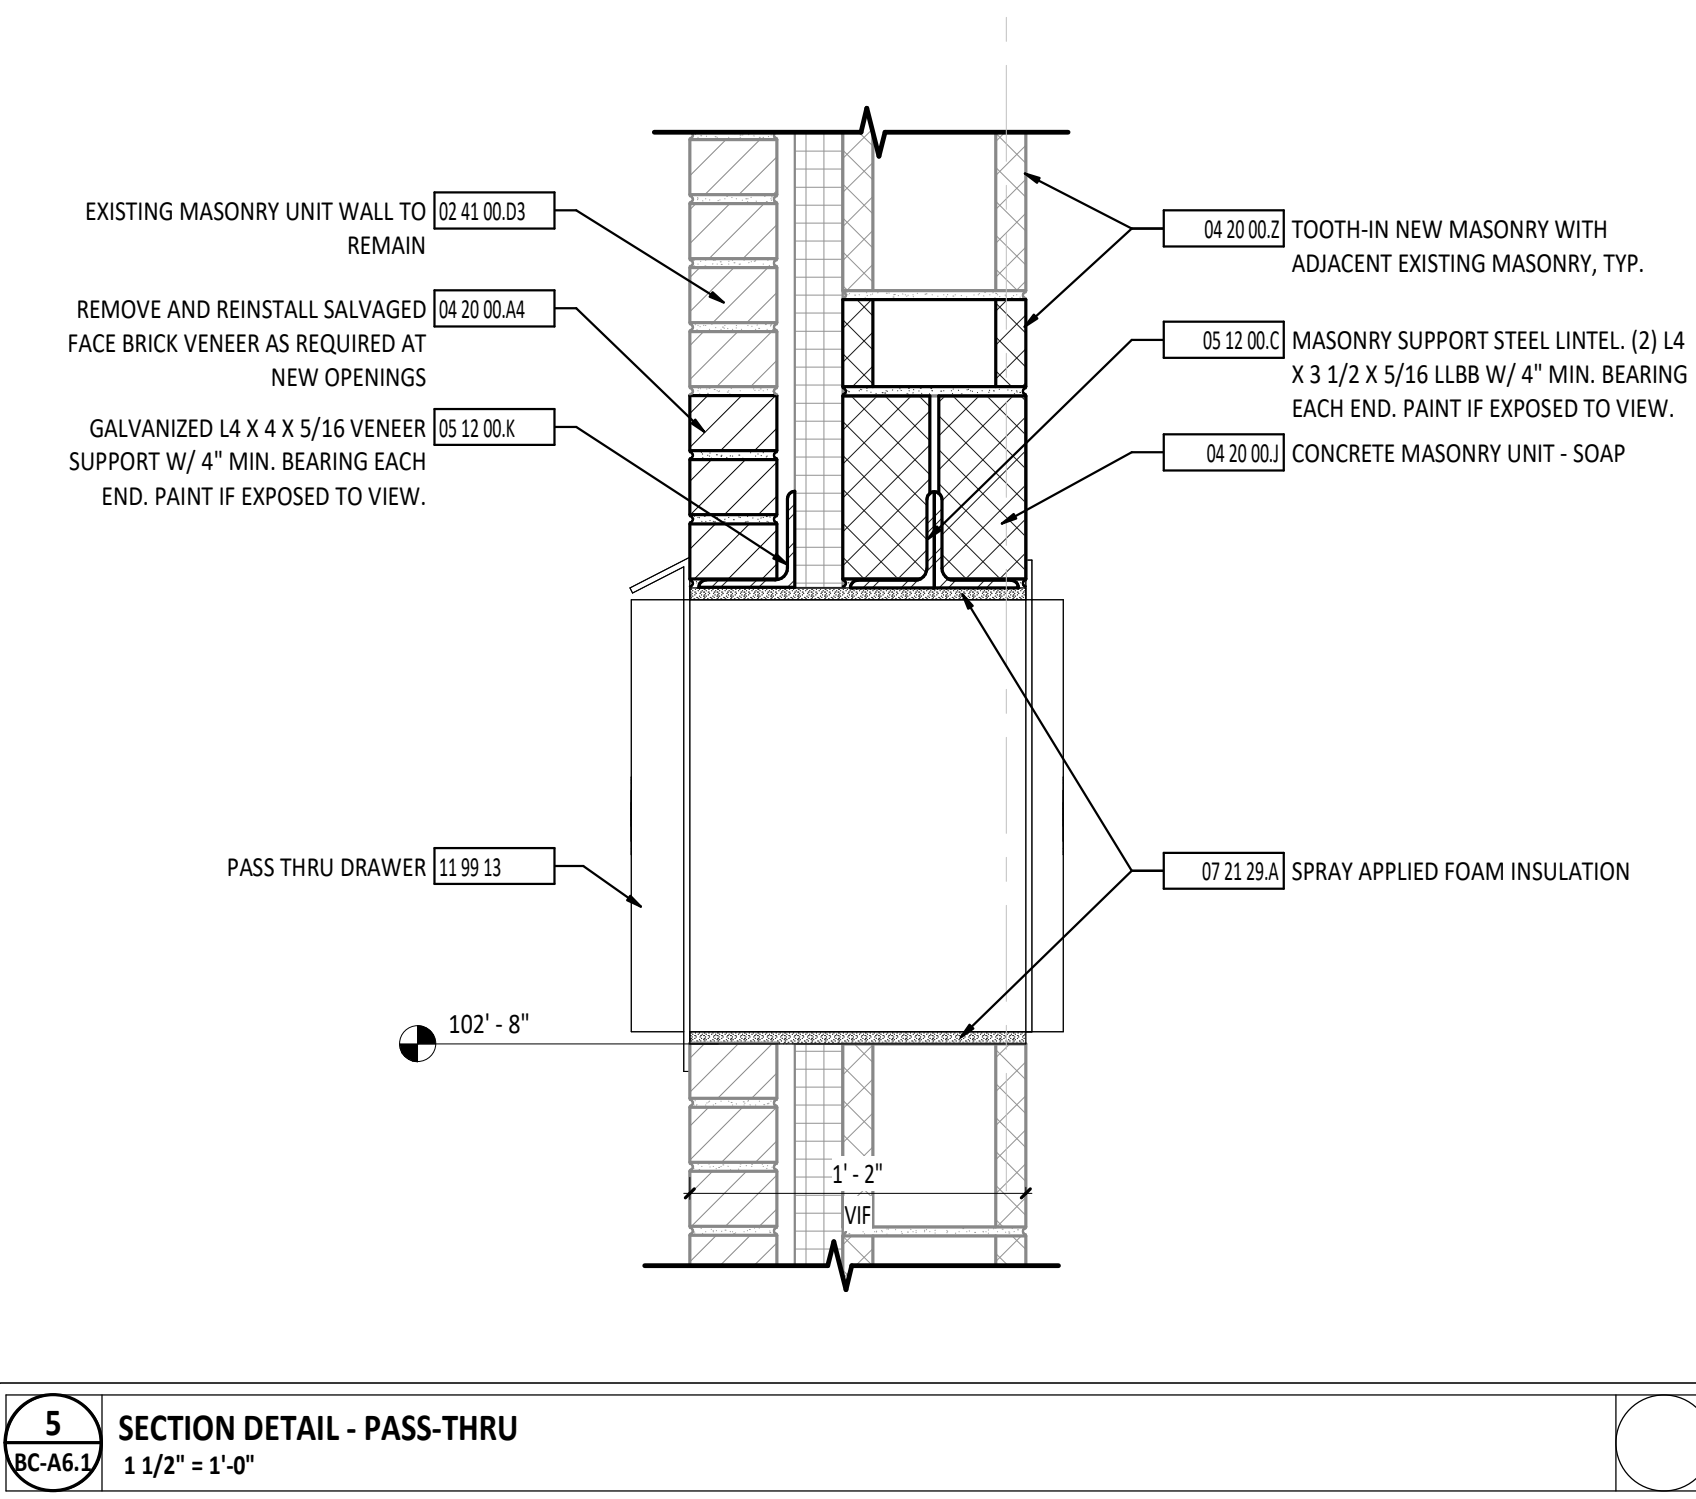

**5 SECTION DETAIL - PASS-THRU**  
1 1/2" x 1'-0"  
BC-A6.1

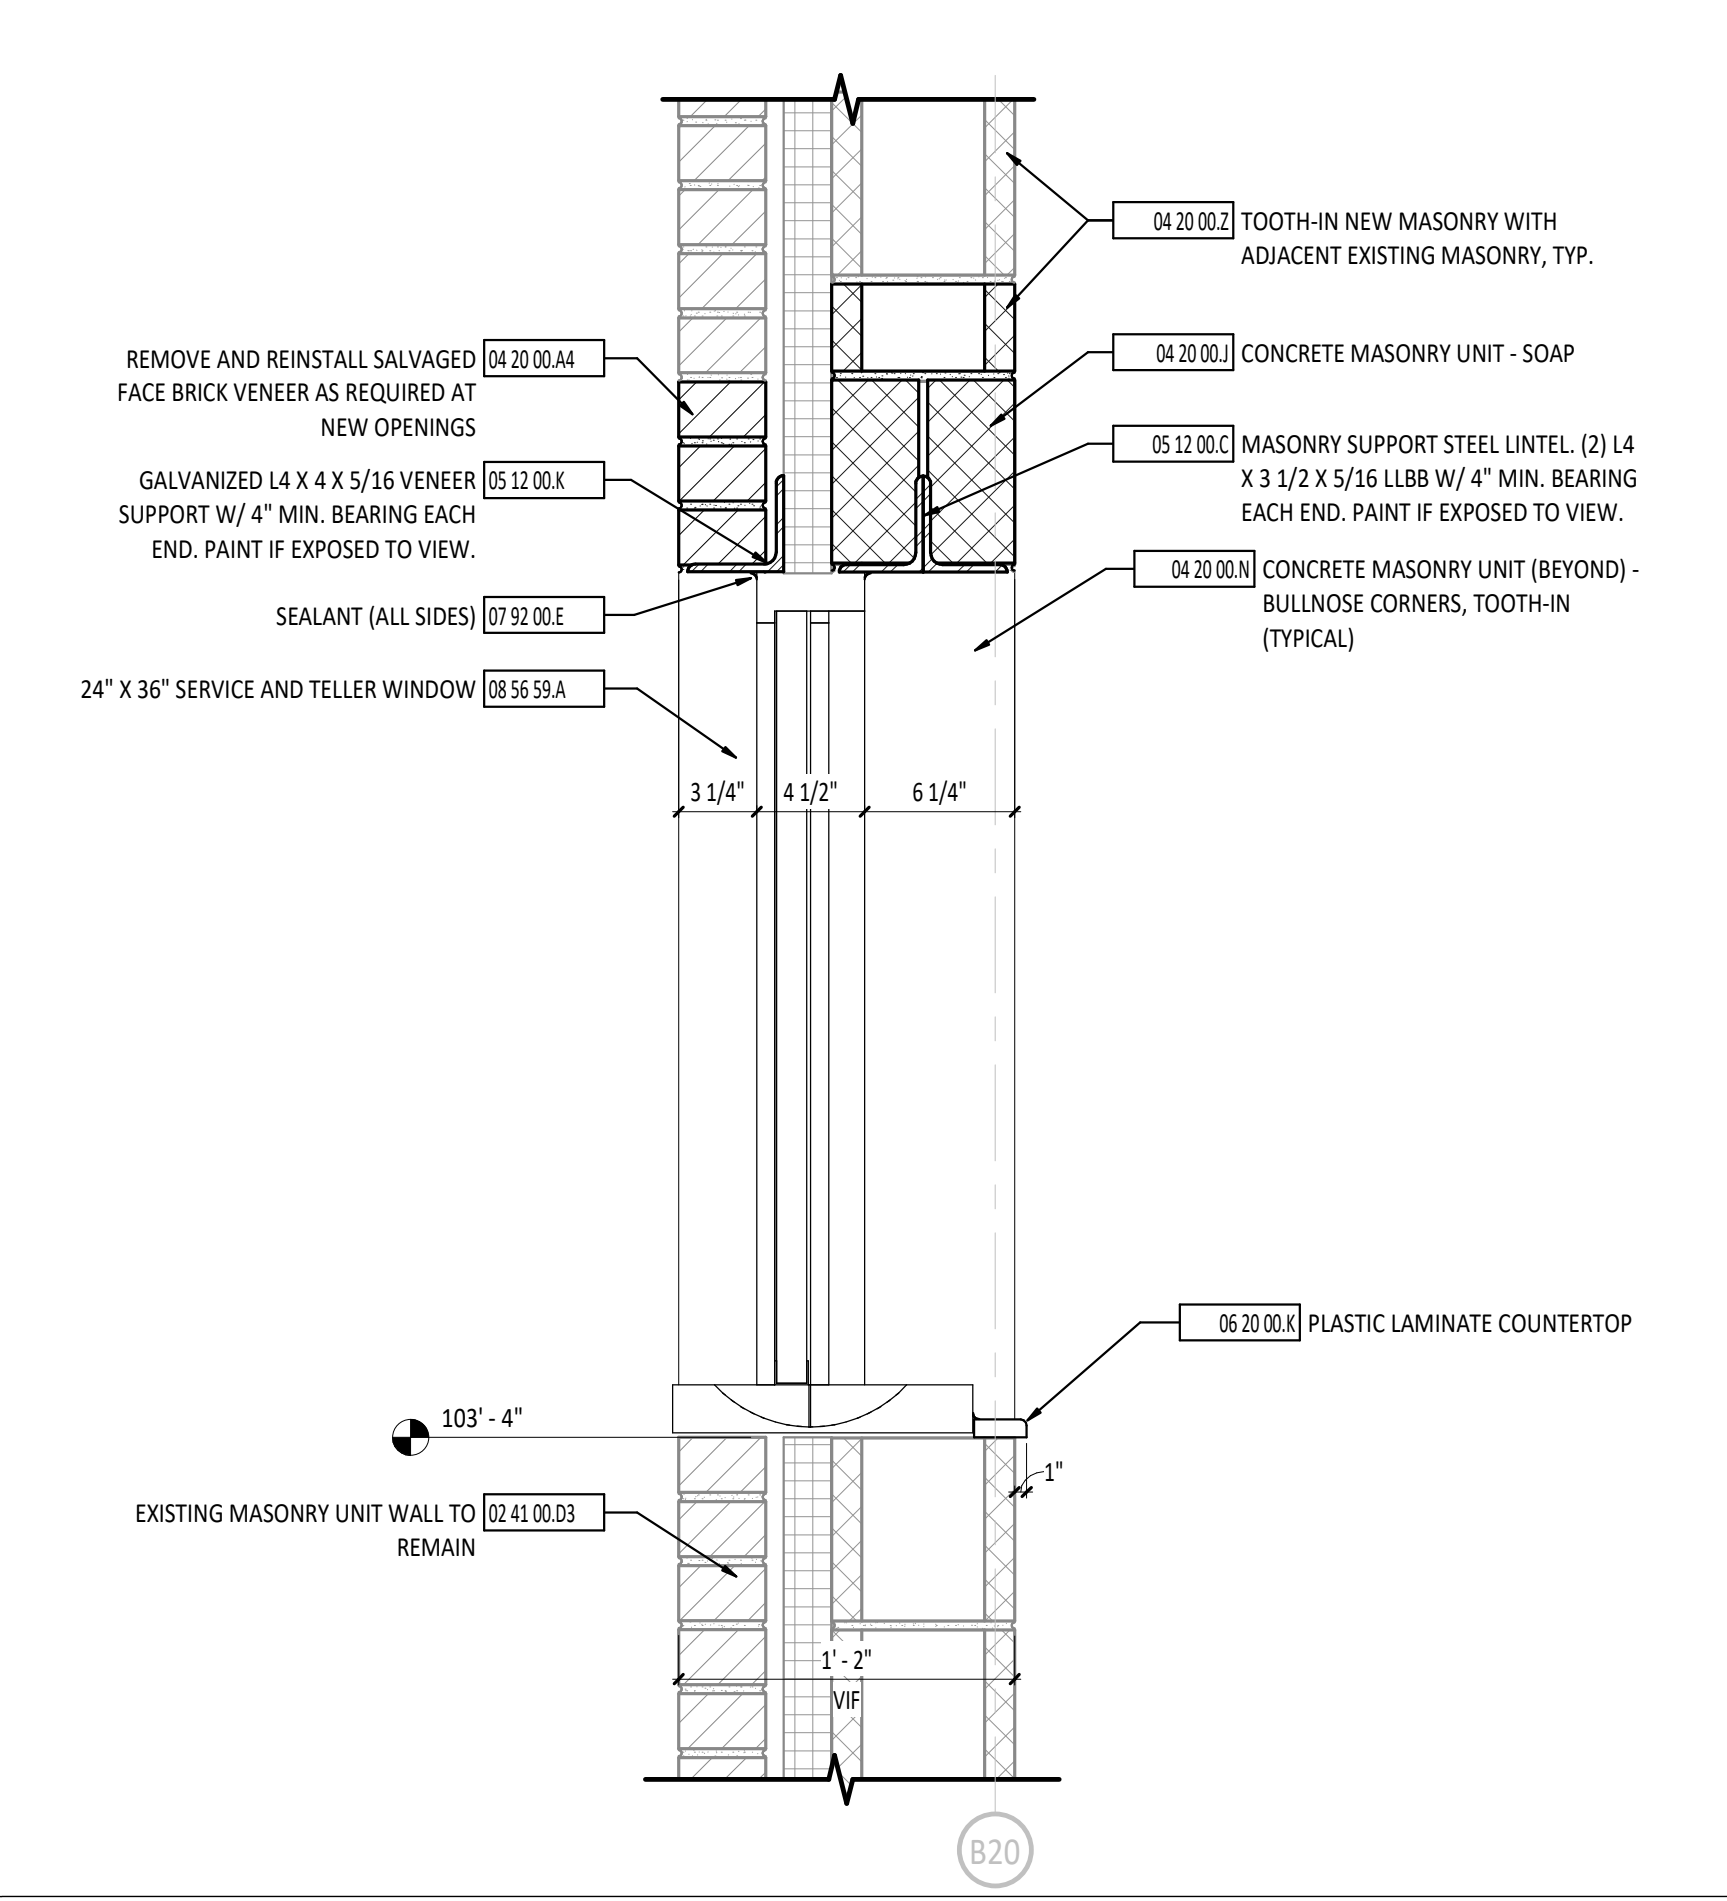

**6 SECTION DETAIL - SERVICE WINDOW**  
1 1/2" x 1'-0"  
BC-A6.1

**DOOR GENERAL NOTES**

B REFERENCE SPECIFICATION SECTION 08 71 00 FOR HARDWARE SETS.

**DOOR/OPENING SCHEDULE ABBREVIATIONS**

**SYMBOL DESCRIPTION**


- F FLUSH
- FG FULL GLASS
- HM HOLLOW METAL
- NL NARROW LITE
- WD WOOD

**DOOR/OPENING SCHEDULE NOTES**

1. EXISTING DOOR TO REMAIN. MODIFY DOOR AS REQUIRED TO RECEIVE NEW SCHEDULED HARDWARE.

**GLAZING TYPES**

- G1 - 1/4" TEMPERED GLAZING
- SG1 - SECURITY GLAZING
- FG1 - 1 HOUR FIRE RATED GLAZING
- FG2 - 1 HOUR FIRE RATED SECURITY GLAZING

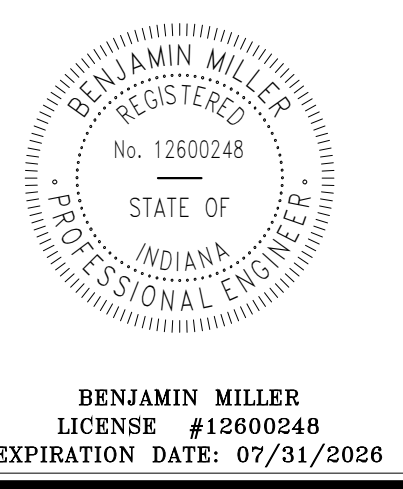

**JENNINGS COUNTY SCHOOL CORPORATION**  
**BRUSH CREEK**  
 PROJECT NUMBER: 25064  
 DRAWN BY: SRS  
 CHECKED BY: TAL  
 SHEET NUMBER: BC-A6.1



ISSUANCES/REVISIONS		
CONSTRUCTION DOCUMENTS	03/26/2025	
1 ADDENDUM #02	04/13/2025	

PROJECT NUMBER:	DRAWN BY:	CHECKED BY:
25064	SRS	TAL

SHEET TITLE:  
**DOOR SCHEDULE AND DETAILS**

SHEET NUMBER:  
**BC-A6.1**

DOOR/OPENING SCHEDULE																			
NUMBER	DOOR					FRAME									HARDWARE SET #	ROOM KEY	FUNCTION	LABEL (MIN)	NOTES
	SIZE	THK	MATL	TYPE	GLASS	DEPTH	MATL	TYPE	GLASS	DETAIL NUMBER									
										HEAD	JAMB	SILL							
EC101A	3'-0" x 7'-0"	1 3/4"	AL	EXIST	EXIST	4 1/2"	AL	EXIST	EXIST	-	-	-	035	EXT	Exterior	-	1		
EC101B	3'-0" x 7'-0"	1 3/4"	WD	EXIST	EXIST	5 3/4"	HM	EXIST	EXIST	-	-	-	035	INT	Interior	-	1		
EC102A	3'-0" x 7'-0"	1 3/4"	WD	EXIST	EXIST	8 3/4"	HM	EXIST	EXIST	-	-	-	036	INT	Interior	-	1		
EC102B	3'-0" x 7'-0"	1 3/4"	WD	EXIST	EXIST	5 3/4"	HM	EXIST	EXIST	-	-	-	036	INT	Interior	-	1		
EC104	3'-0" x 7'-0"	1 3/4"	WD	EXIST	EXIST	5 3/4"	HM	EXIST	EXIST	-	-	-	036	INT	Interior	-	1		

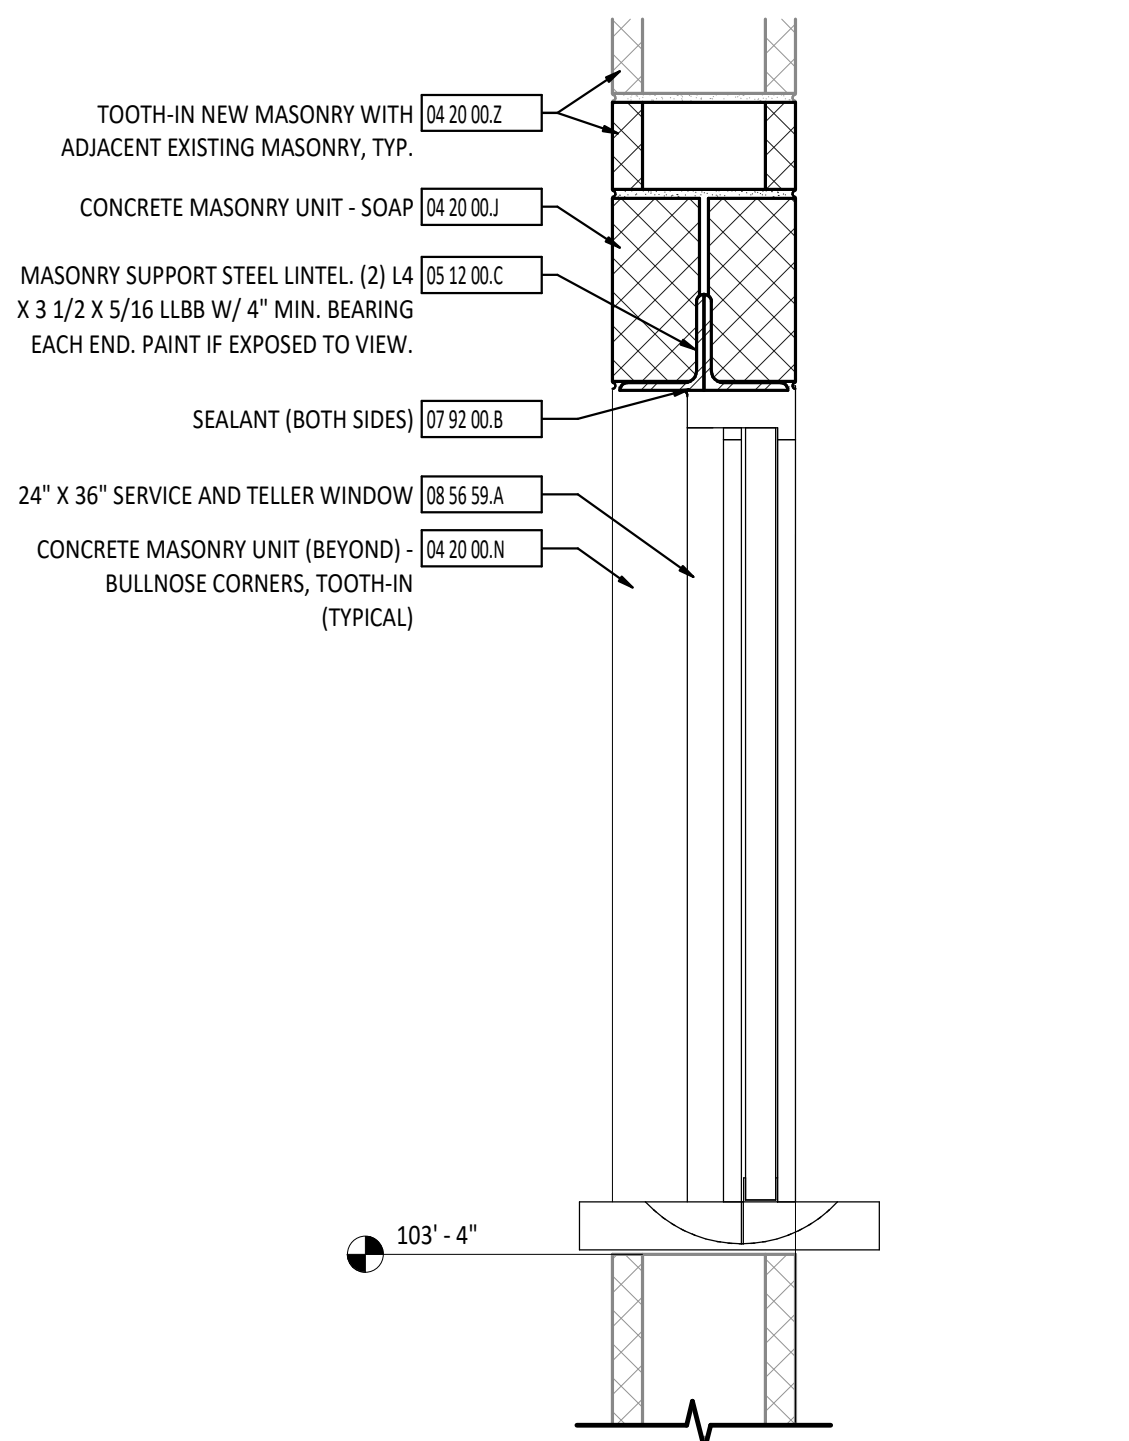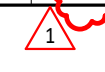

**1** DETAIL @ SERVICE WINDOW  
1 1/2" x 1'-0"

**DOOR GENERAL NOTES**

B REFERENCE SPECIFICATION SECTION 08 71 00 FOR HARDWARE SETS.


**DOOR/OPENING SCHEDULE ABBREVIATIONS**

**SYMBOL DESCRIPTION**

- AL ALUMINUM
- F FLUSH
- FG FULL GLASS
- HG HALF GLASS
- HM HOLLOW METAL
- NL NARROW LITE
- WD WOOD

**DOOR/OPENING SCHEDULE NOTES**

1. EXISTING DOOR TO REMAIN. MODIFY DOOR AS REQUIRED TO RECEIVE NEW SCHEDULED HARDWARE.

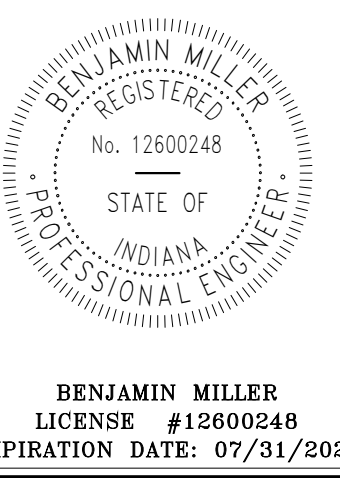

**JENNINGS COUNTY SCHOOL CORPORATIONS  
EDUCATION CENTER**

100 S. WERTER STREET, NORTHVINGTON, INDIANA 47255


ISSUANCES/REVISIONS		
CONSTRUCTION DOCUMENTS	03/26/2025	
1 ADDENDUM #02	04/13/2025	

PROJECT NUMBER:	DRAWN BY:	CHECKED BY:
25064	SRS	TAL


SHEET TITLE:  
**DOOR SCHEDULE  
AND DETAILS**

SHEET NUMBER:  
**EC-A6.1**


DOOR/OPENING SCHEDULE																	
NUMBER	DOOR					FRAME					HARDWARE SET #	ROOM KEY	FUNCTION	LABEL (MIN)	NOTES		
	SIZE	THK	MATL	TYPE	GLASS	DEPTH	MATL	TYPE	GLASS	DETAIL NUMBER							
	HEAD	JAMB	SILL	HEAD	JAMB	SILL											
GC101A	3'-0" x 7'-0"	1 3/4"	AL	FG2.1	EXST	4 1/2"	AL	EXIST	EXIST	-	-	-	001	-	Exterior	-	1
GC101B	3'-0" x 7'-0"	1 3/4"	AL	FG2.1	EXST	4 1/2"	AL	EXIST	EXIST	-	-	-	011	-	Exterior	-	1
GC101C	3'-0" x 7'-0"	1 3/4"	WD	FG	SG1	5 3/4"	HM	3	SG1	38.5/A6.1	48.6/A6.1	-	022	GC101	Interior	-	-
GC101D	3'-0" x 7'-0"	1 3/4"	WD	FG	SG1	5 3/4"	HM	3	SG1	38.5/A6.1	48.6/A6.1	-	012	GC101	Interior	-	-
GC102A	3'-0" x 7'-0"	1 3/4"	WD	FG	EXST	5 3/4"	HM	EXIST	EXIST	-	-	-	048	-	Interior	-	1
GC102B	3'-0" x 7'-0"	1 3/4"	WD	FG	EXST	5 3/4"	HM	EXIST	EXIST	-	-	-	048	-	Interior	-	1
GC103A	3'-0" x 7'-0"	1 3/4"	WD	HG	SG1	6 3/4"	HM	2	-	1/A6.1	2/A7.1	-	035	GC102	Interior	20	-
GC103B	3'-0" x 7'-0"	1 3/4"	WD	NL	EXST	5 3/4"	HM	EXIST	EXIST	-	-	-	036	-	Interior	-	1
GC104	3'-0" x 7'-0"	1 3/4"	WD	F	-	5 3/4"	HM	EXIST	EXIST	3/A6.1	4/A7.1	-	028	-	Interior	-	2
GC105	3'-0" x 7'-0"	1 3/4"	WD	F	-	5 3/4"	HM	EXIST	EXIST	3/A6.1	4/A7.1	-	028	-	Interior	-	2
GC106	3'-0" x 7'-0"	1 3/4"	WD	F	-	5 3/4"	HM	1	-	3/A6.1	4/A7.1	-	029	GC105	Interior	-	-
GC112						0"											

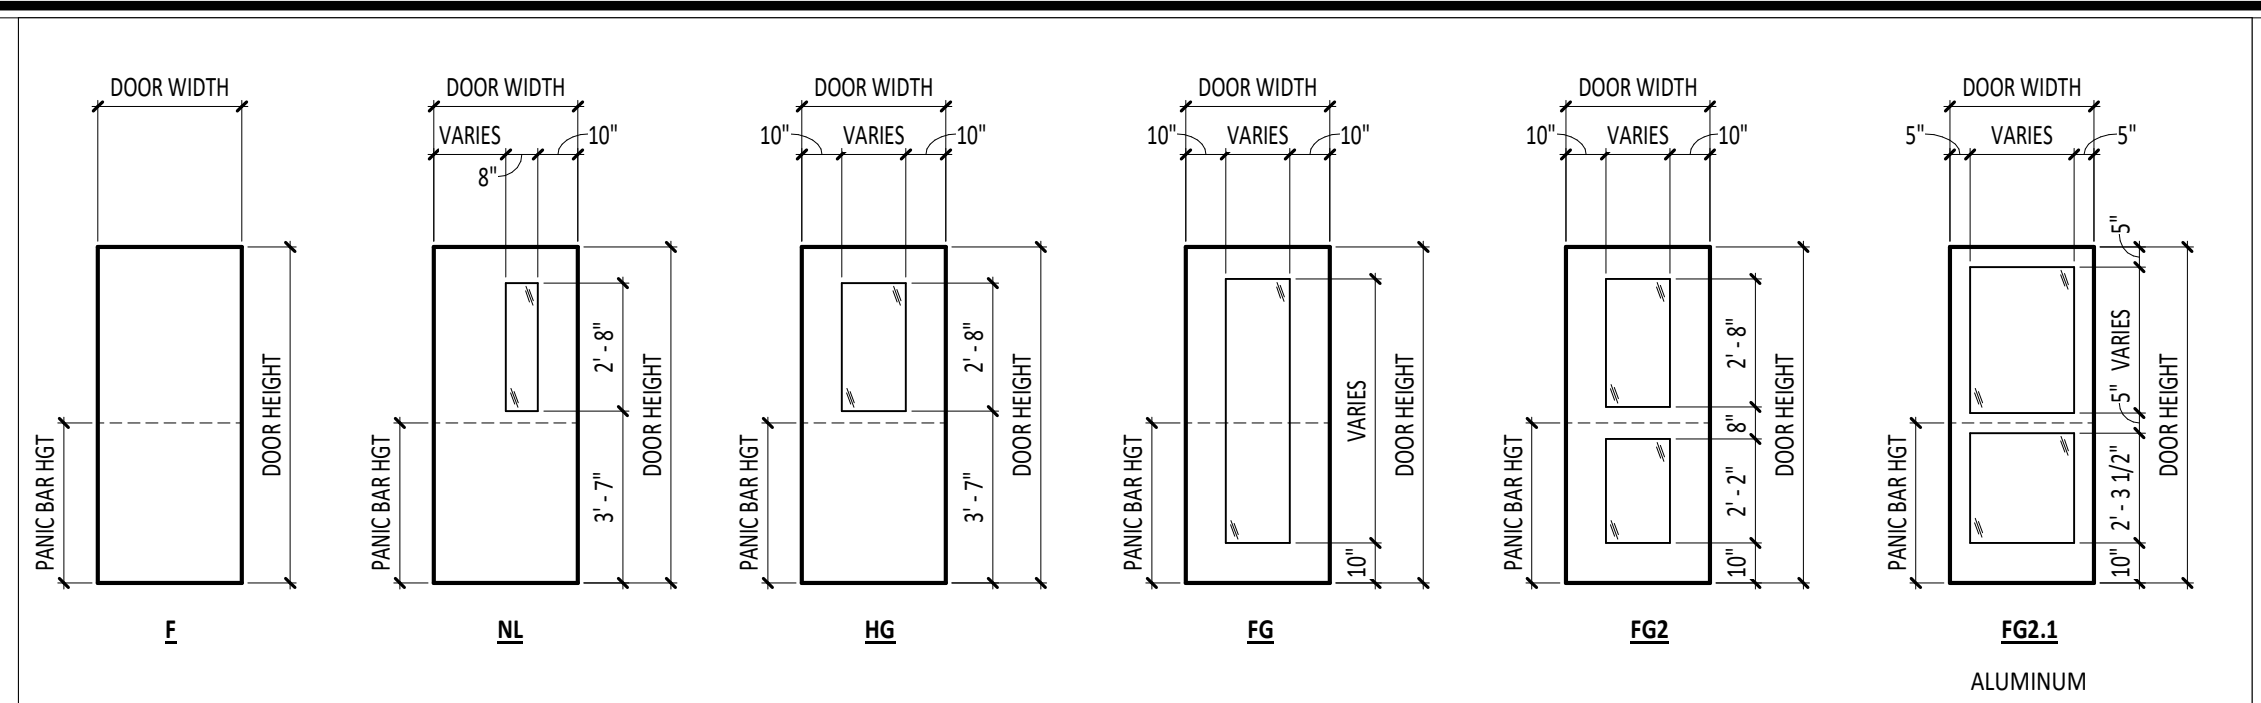


**DOOR TYPES**  
1/4" = 1'-0"

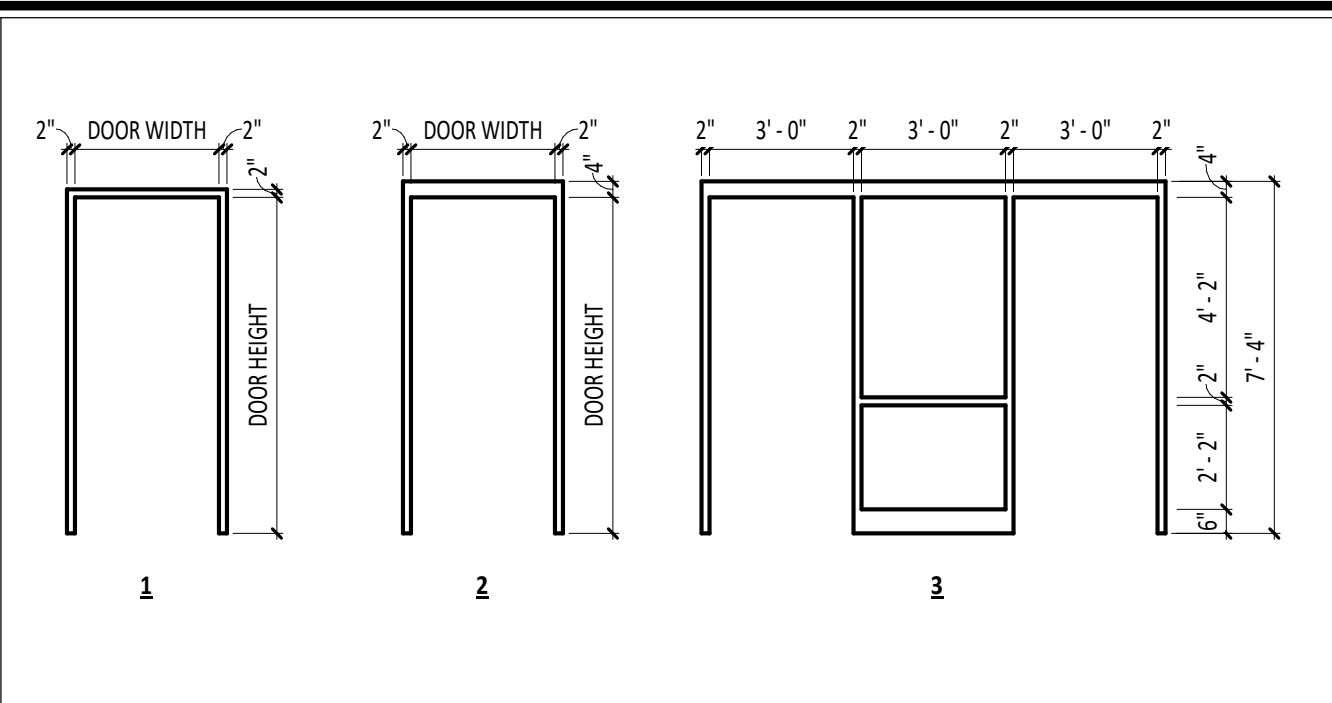


**HOLLOW METAL DOOR FRAME TYPES**  
1/4" = 1'-0"

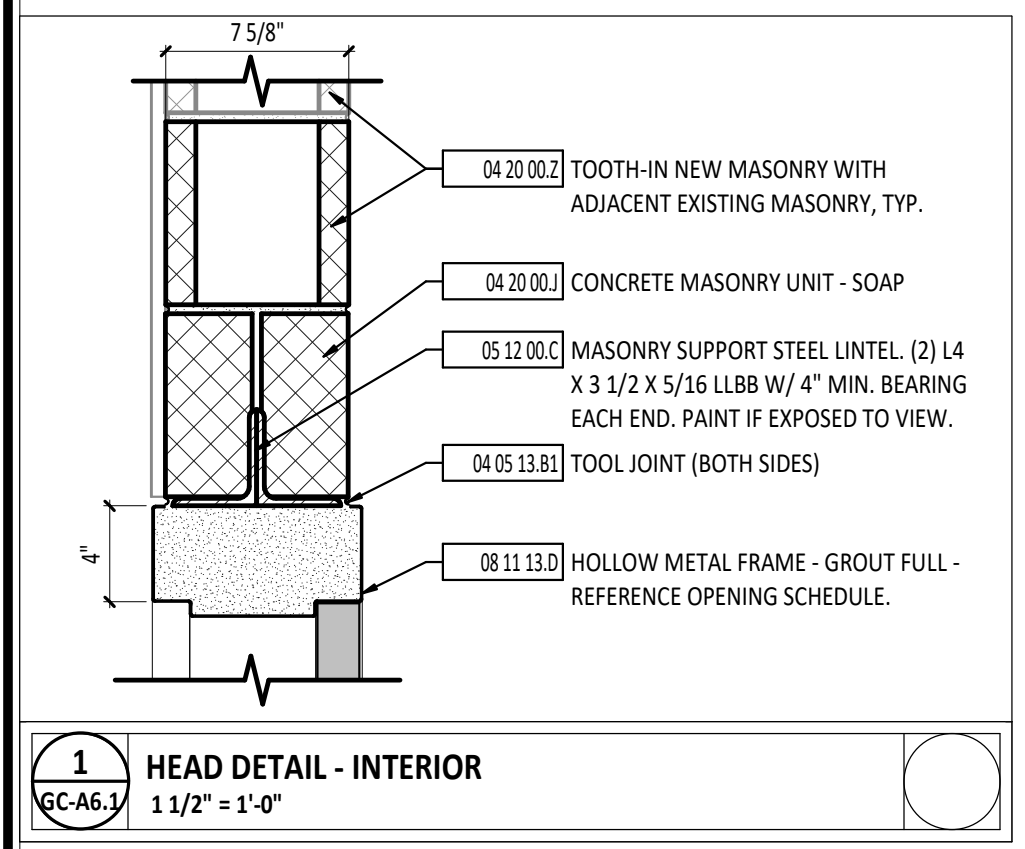


**1 HEAD DETAIL - INTERIOR**  
1 1/2" = 1'-0"

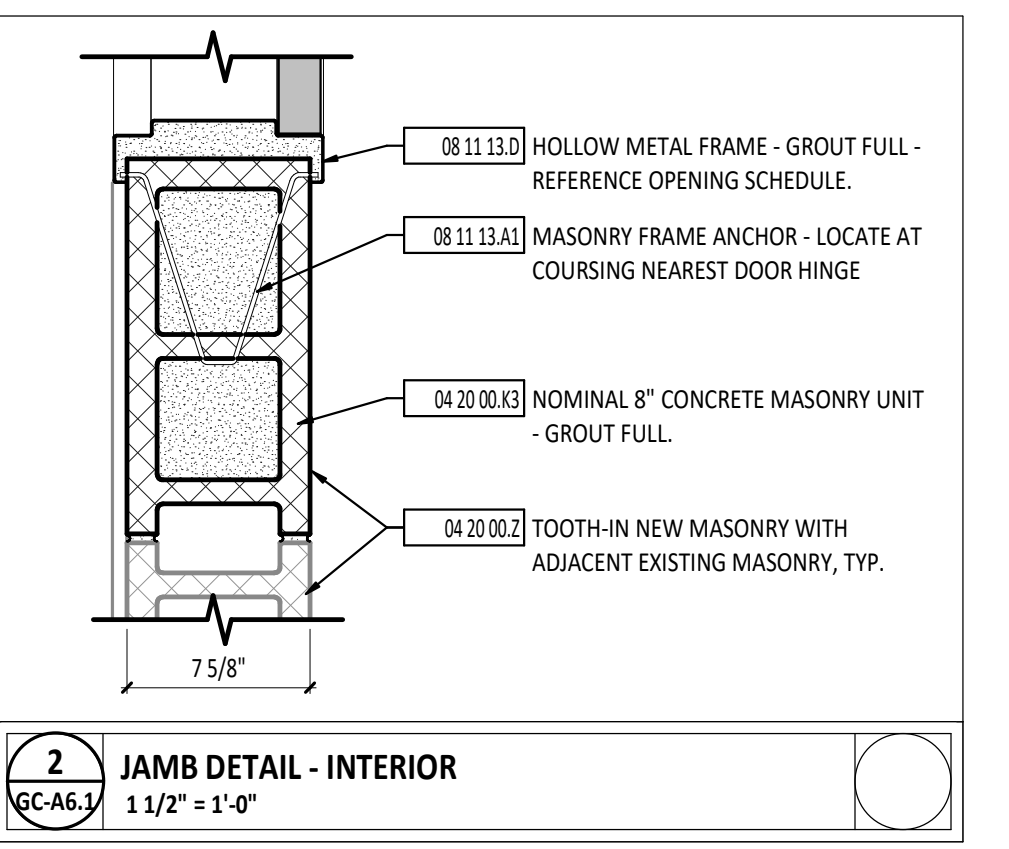


**2 JAMB DETAIL - INTERIOR**  
1 1/2" = 1'-0"

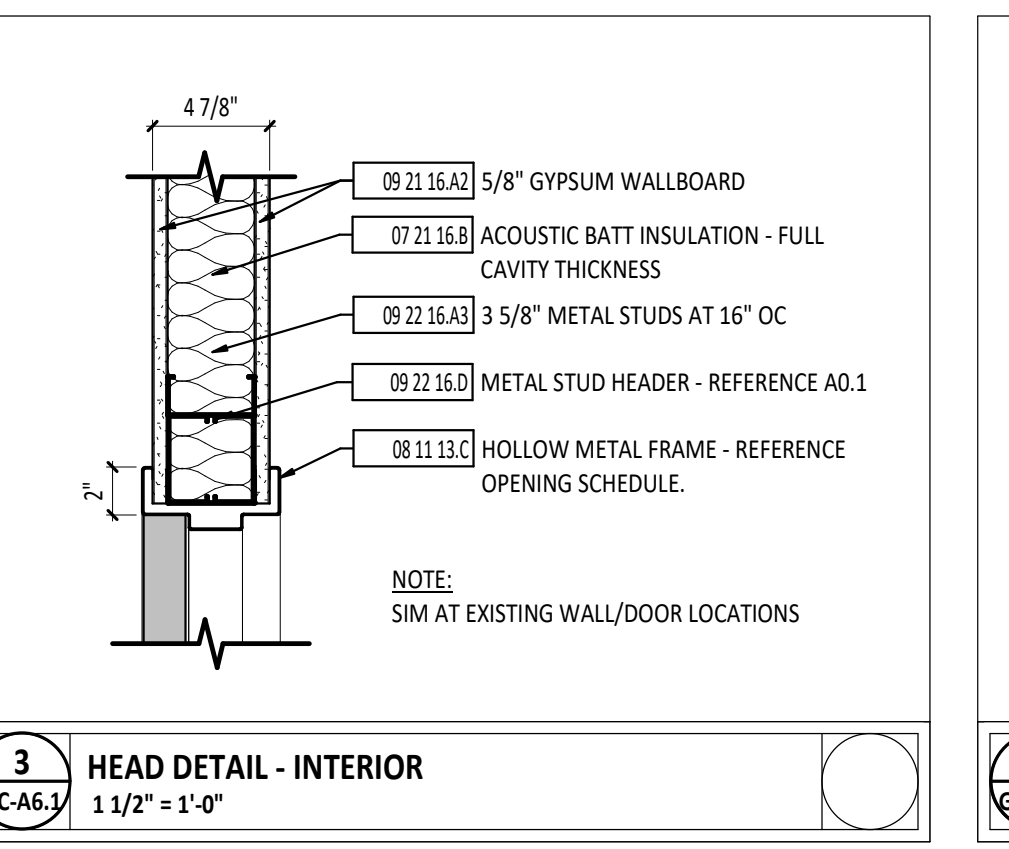


**3 HEAD DETAIL - INTERIOR**  
1 1/2" = 1'-0"

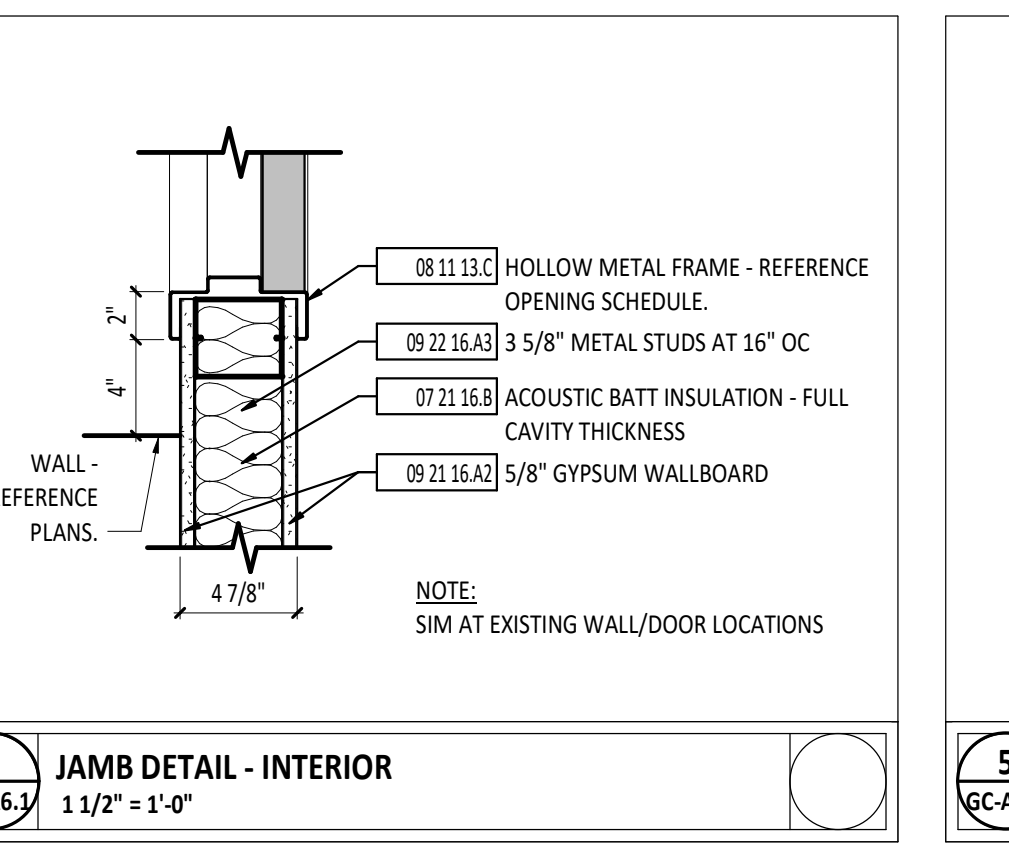


**4 JAMB DETAIL - INTERIOR**  
1 1/2" = 1'-0"

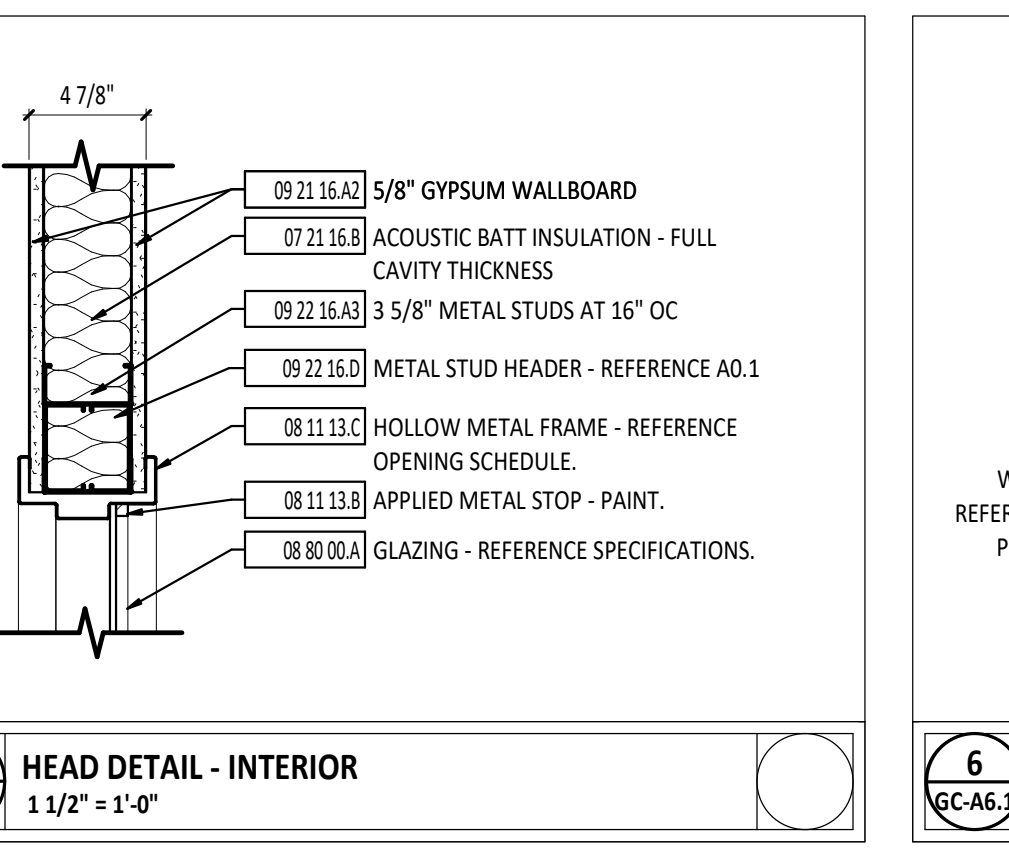


**5 HEAD DETAIL - INTERIOR**  
1 1/2" = 1'-0"

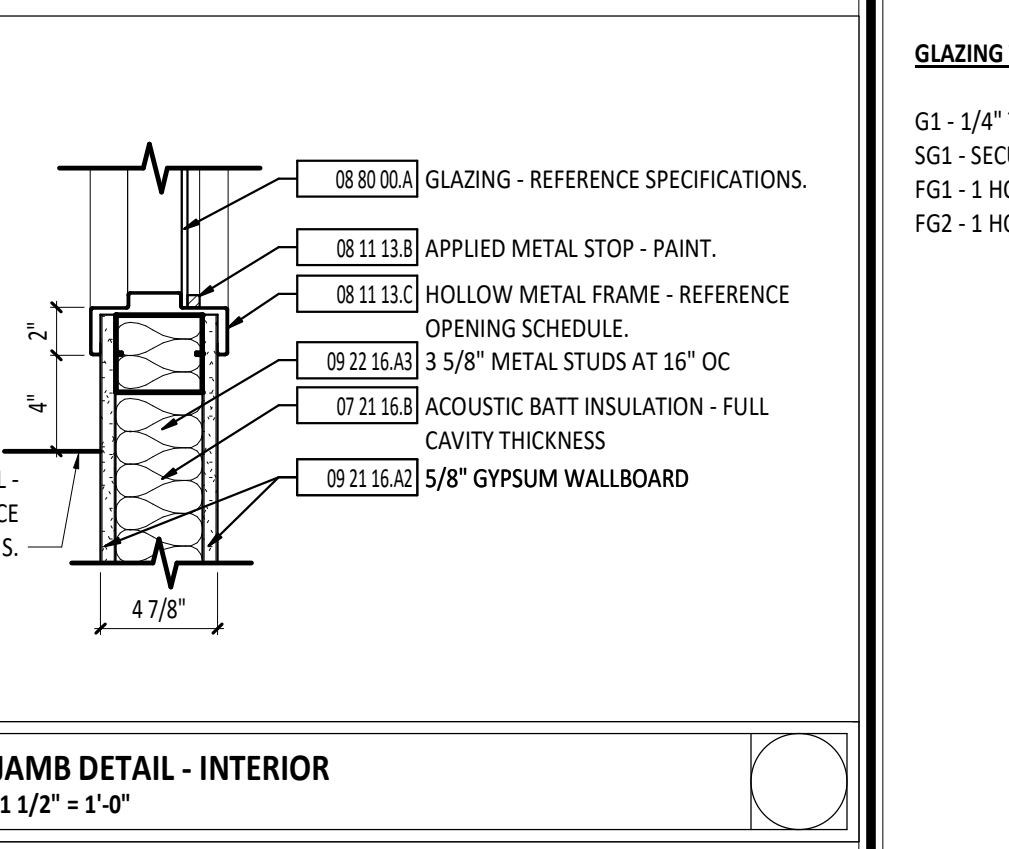

**6 JAMB DETAIL - INTERIOR**  
1 1/2" = 1'-0"

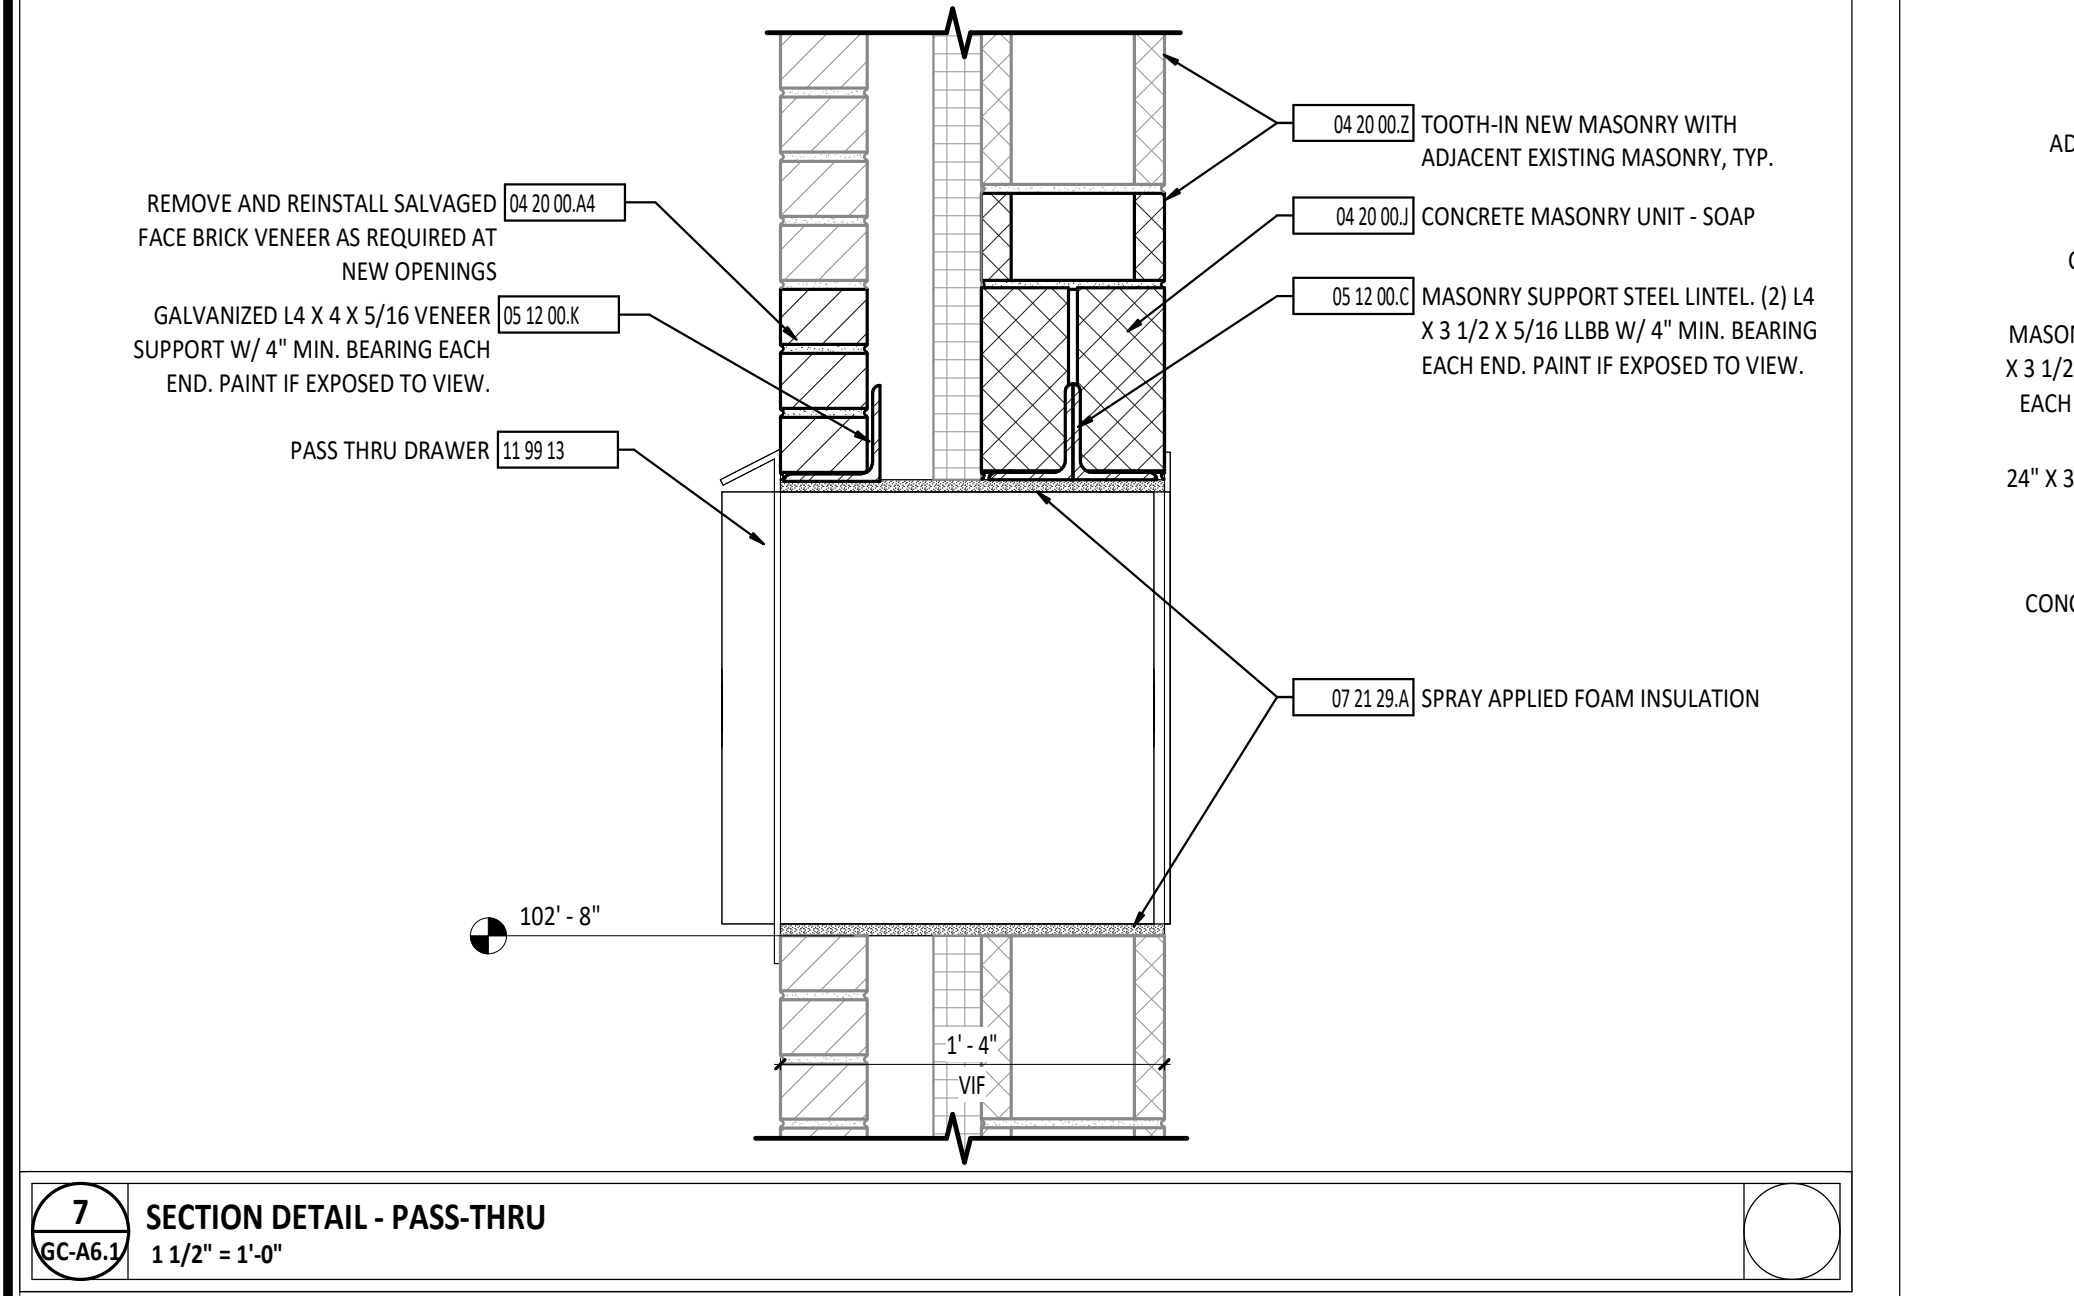

**7 SECTION DETAIL - PASS-THRU**  
1 1/2" = 1'-0"

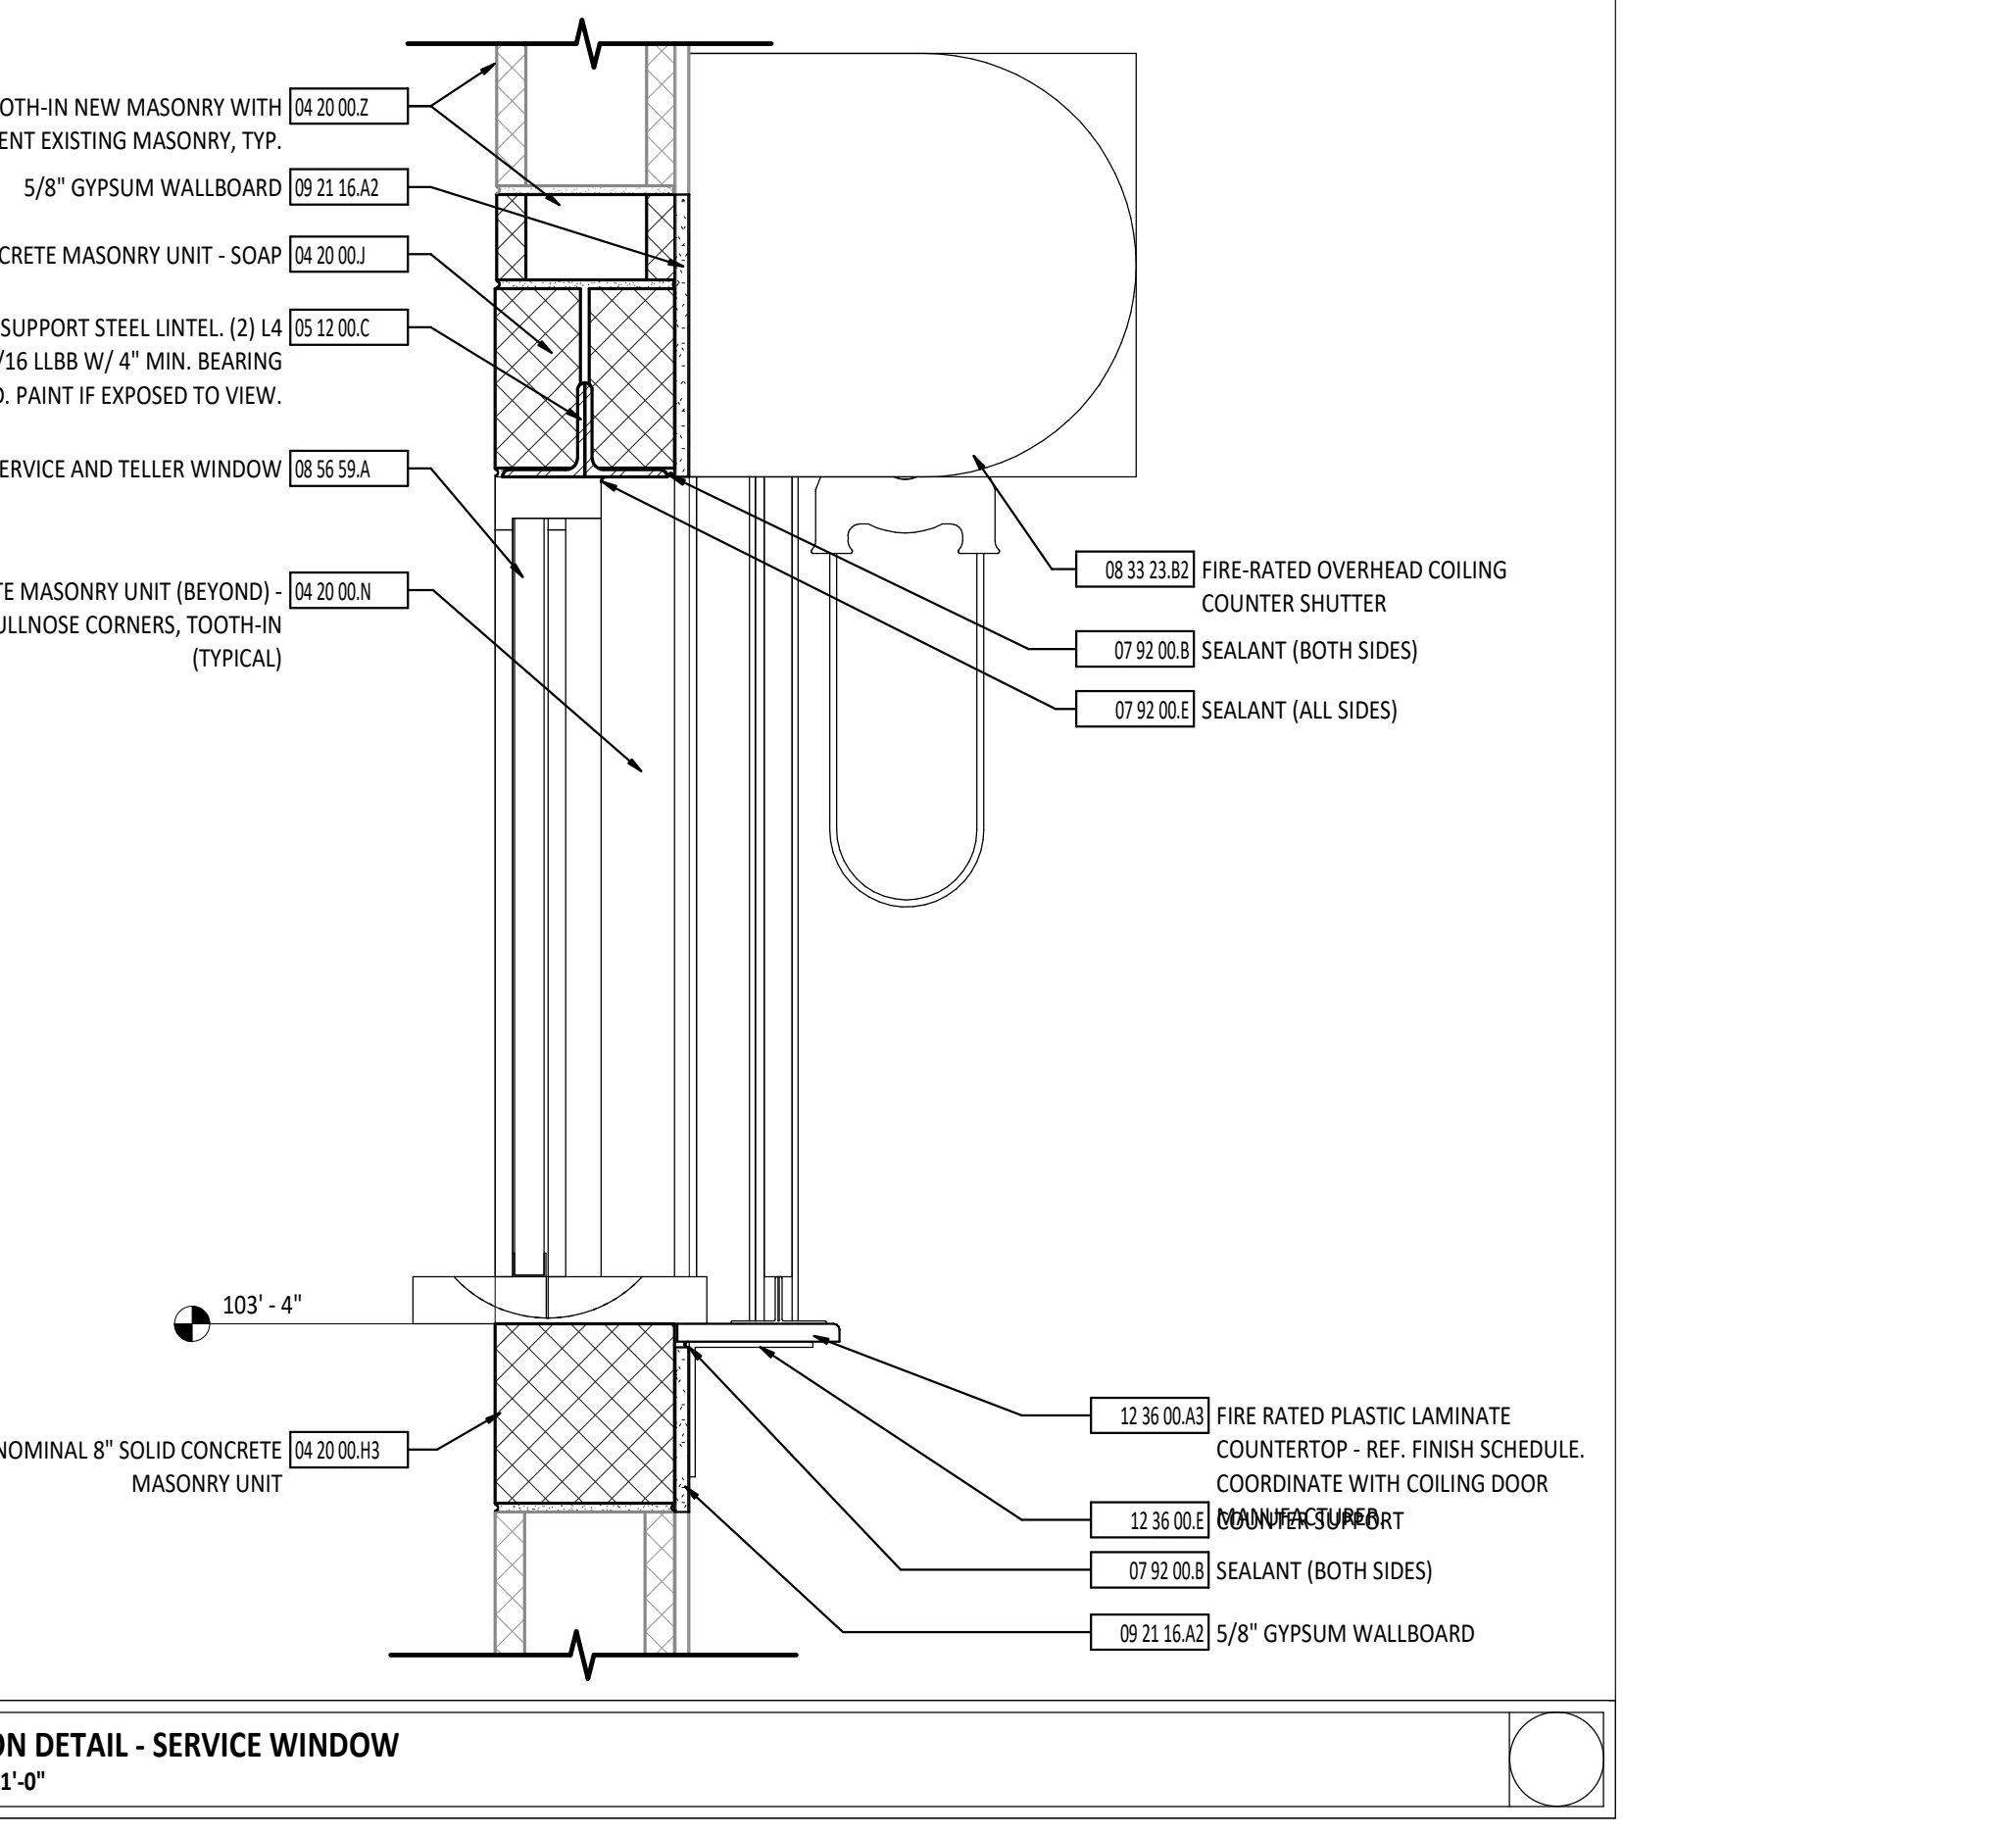

**8 SECTION DETAIL - SERVICE WINDOW**  
1 1/2" = 1'-0"

**DOOR GENERAL NOTES**  
B REFERENCE SPECIFICATION SECTION 08 71 00 FOR HARDWARE SETS.

**DOOR/OPENING SCHEDULE ABBREVIATIONS**

**SYMBOL DESCRIPTION**


AL ALUMINUM  
F FLUSH  
FG FULL GLASS  
HG HALF GLASS  
HM HOLLOW METAL  
NL NARROW LITE  
WD WOOD  
EXIST EXISTING

**DOOR/OPENING SCHEDULE NOTES**

1. EXISTING DOOR TO REMAIN. MODIFY DOOR AS REQUIRED TO RECEIVE NEW SCHEDULED HARDWARE.  
2. EXISTING DOOR TO BE REINSTALLED IN NEW LOCATION.

**GLAZING TYPES**

G1 - 1/4" TEMPERED GLAZING  
SG1 - SECURITY GLAZING  
FG1 - 1 HOUR FIRE RATED GLAZING  
FG2 - 1 HOUR FIRE RATED SECURITY GLAZING

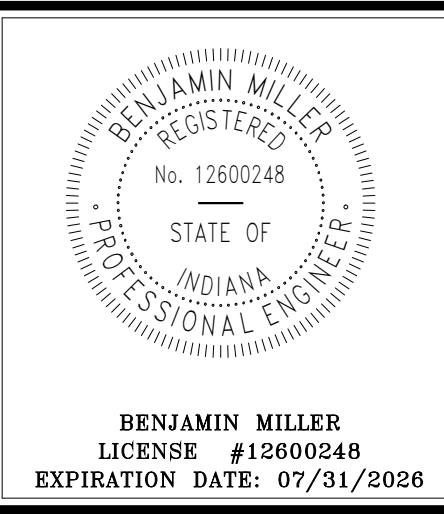

JENNINGS COUNTY SCHOOL CORPORATION  
GRAHAM CREEK

7803 S. COUNTRY ROAD SW, COMANSETT, INDIANA 47322



ISSUANCES/REVISIONS	
PROJECT NUMBER:	25064
CONSTRUCTION DOCUMENTS	03/26/2026
1 ADDENDUM #02	04/13/2026

PROJECT NUMBER:	DRAWN BY:	CHECKED BY:
25064	SRS	TAL

SHEET TITLE:  
**DOOR SCHEDULE AND DETAILS**

SHEET NUMBER:  
**GC-A6.1**

DOOR/OPENING SCHEDULE																		
NUMBER	DOOR					FRAME					DETAIL NUMBER			HARDWARE SET #	ROOM KEY	FUNCTION	LABEL (MIN)	NOTES
	SIZE	THK	MATL	TYPE	GLASS	DEPTH	MATL	TYPE	GLASS	HEAD	JAMB	SILL						
HS101A	(2) 3'-0" x 7'-0"	1 3/4"	AL	EXIST	EXST	5 3/4"	HM	EXIST	EXIST	-	-	-	013	EXT	Exterior	-	1	
HS101B	(2) 3'-0" x 7'-0"	1 3/4"	AL	EXIST	EXST	5 3/4"	HM	EXIST	EXIST	-	-	-	035	EXT	Exterior	-	1	
HS101C	(2) 3'-0" x 7'-0"	1 3/4"	AL	EXIST	EXST	5 3/4"	HM	EXIST	EXIST	-	-	-	035	EXT	Exterior	-	1	
HS101D	(2) 3'-0" x 7'-0"	1 3/4"	AL	EXIST	EXST	5 3/4"	HM	EXIST	EXIST	-	-	-	050	EXT	Exterior	-	1	
HS101E	(2) 3'-0" x 7'-0"	1 3/4"	AL	EXIST	EXST	5 3/4"	HM	EXIST	EXIST	-	-	-	050	INT	Interior	-	1	
HS101F	(2) 3'-0" x 7'-0"	1 3/4"	AL	EXIST	EXST	5 3/4"	HM	EXIST	EXIST	-	-	-	005	INT	Interior	-	1	
HS101G	(2) 3'-0" x 7'-0"	1 3/4"	AL	EXIST	EXST	5 3/4"	HM	EXIST	EXIST	-	-	-	005	INT	Interior	-	1	
HS101H	(2) 3'-0" x 7'-0"	1 3/4"	AL	EXIST	EXST	5 3/4"	HM	EXIST	EXIST	-	-	-	005	INT	Interior	-	1	
HS102A	(2) 3'-0" x 7'-0"	1 3/4"	AL	EXIST	EXST	5 3/4"	HM	EXIST	EXIST	-	-	-	005	INT	Interior	-	1	
HS102B	(2) 3'-0" x 7'-0"	1 3/4"	AL	EXIST	EXST	5 3/4"	HM	EXIST	EXIST	-	-	-	005	INT	Interior	-	1	
HS102C	(2) 3'-0" x 7'-0"	1 3/4"	AL	EXIST	EXST	5 3/4"	HM	EXIST	EXIST	-	-	-	005	INT	Interior	-	1	
HS102D	(2) 3'-0" x 7'-0"	1 3/4"	AL	EXIST	EXST	5 3/4"	HM	EXIST	EXIST	-	-	-	005	INT	Interior	-	1	
HS103A	3'-0" x 7'-0"	1 3/4"	WD	EXIST	EXST	5 3/4"	HM	EXIST	EXIST	-	-	-	007	INT	Interior	-	1	
HS103B	3'-0" x 7'-0"	1 3/4"	WD	EXIST	EXST	5 3/4"	HM	EXIST	EXIST	-	-	-	008	INT	Interior	-	1	

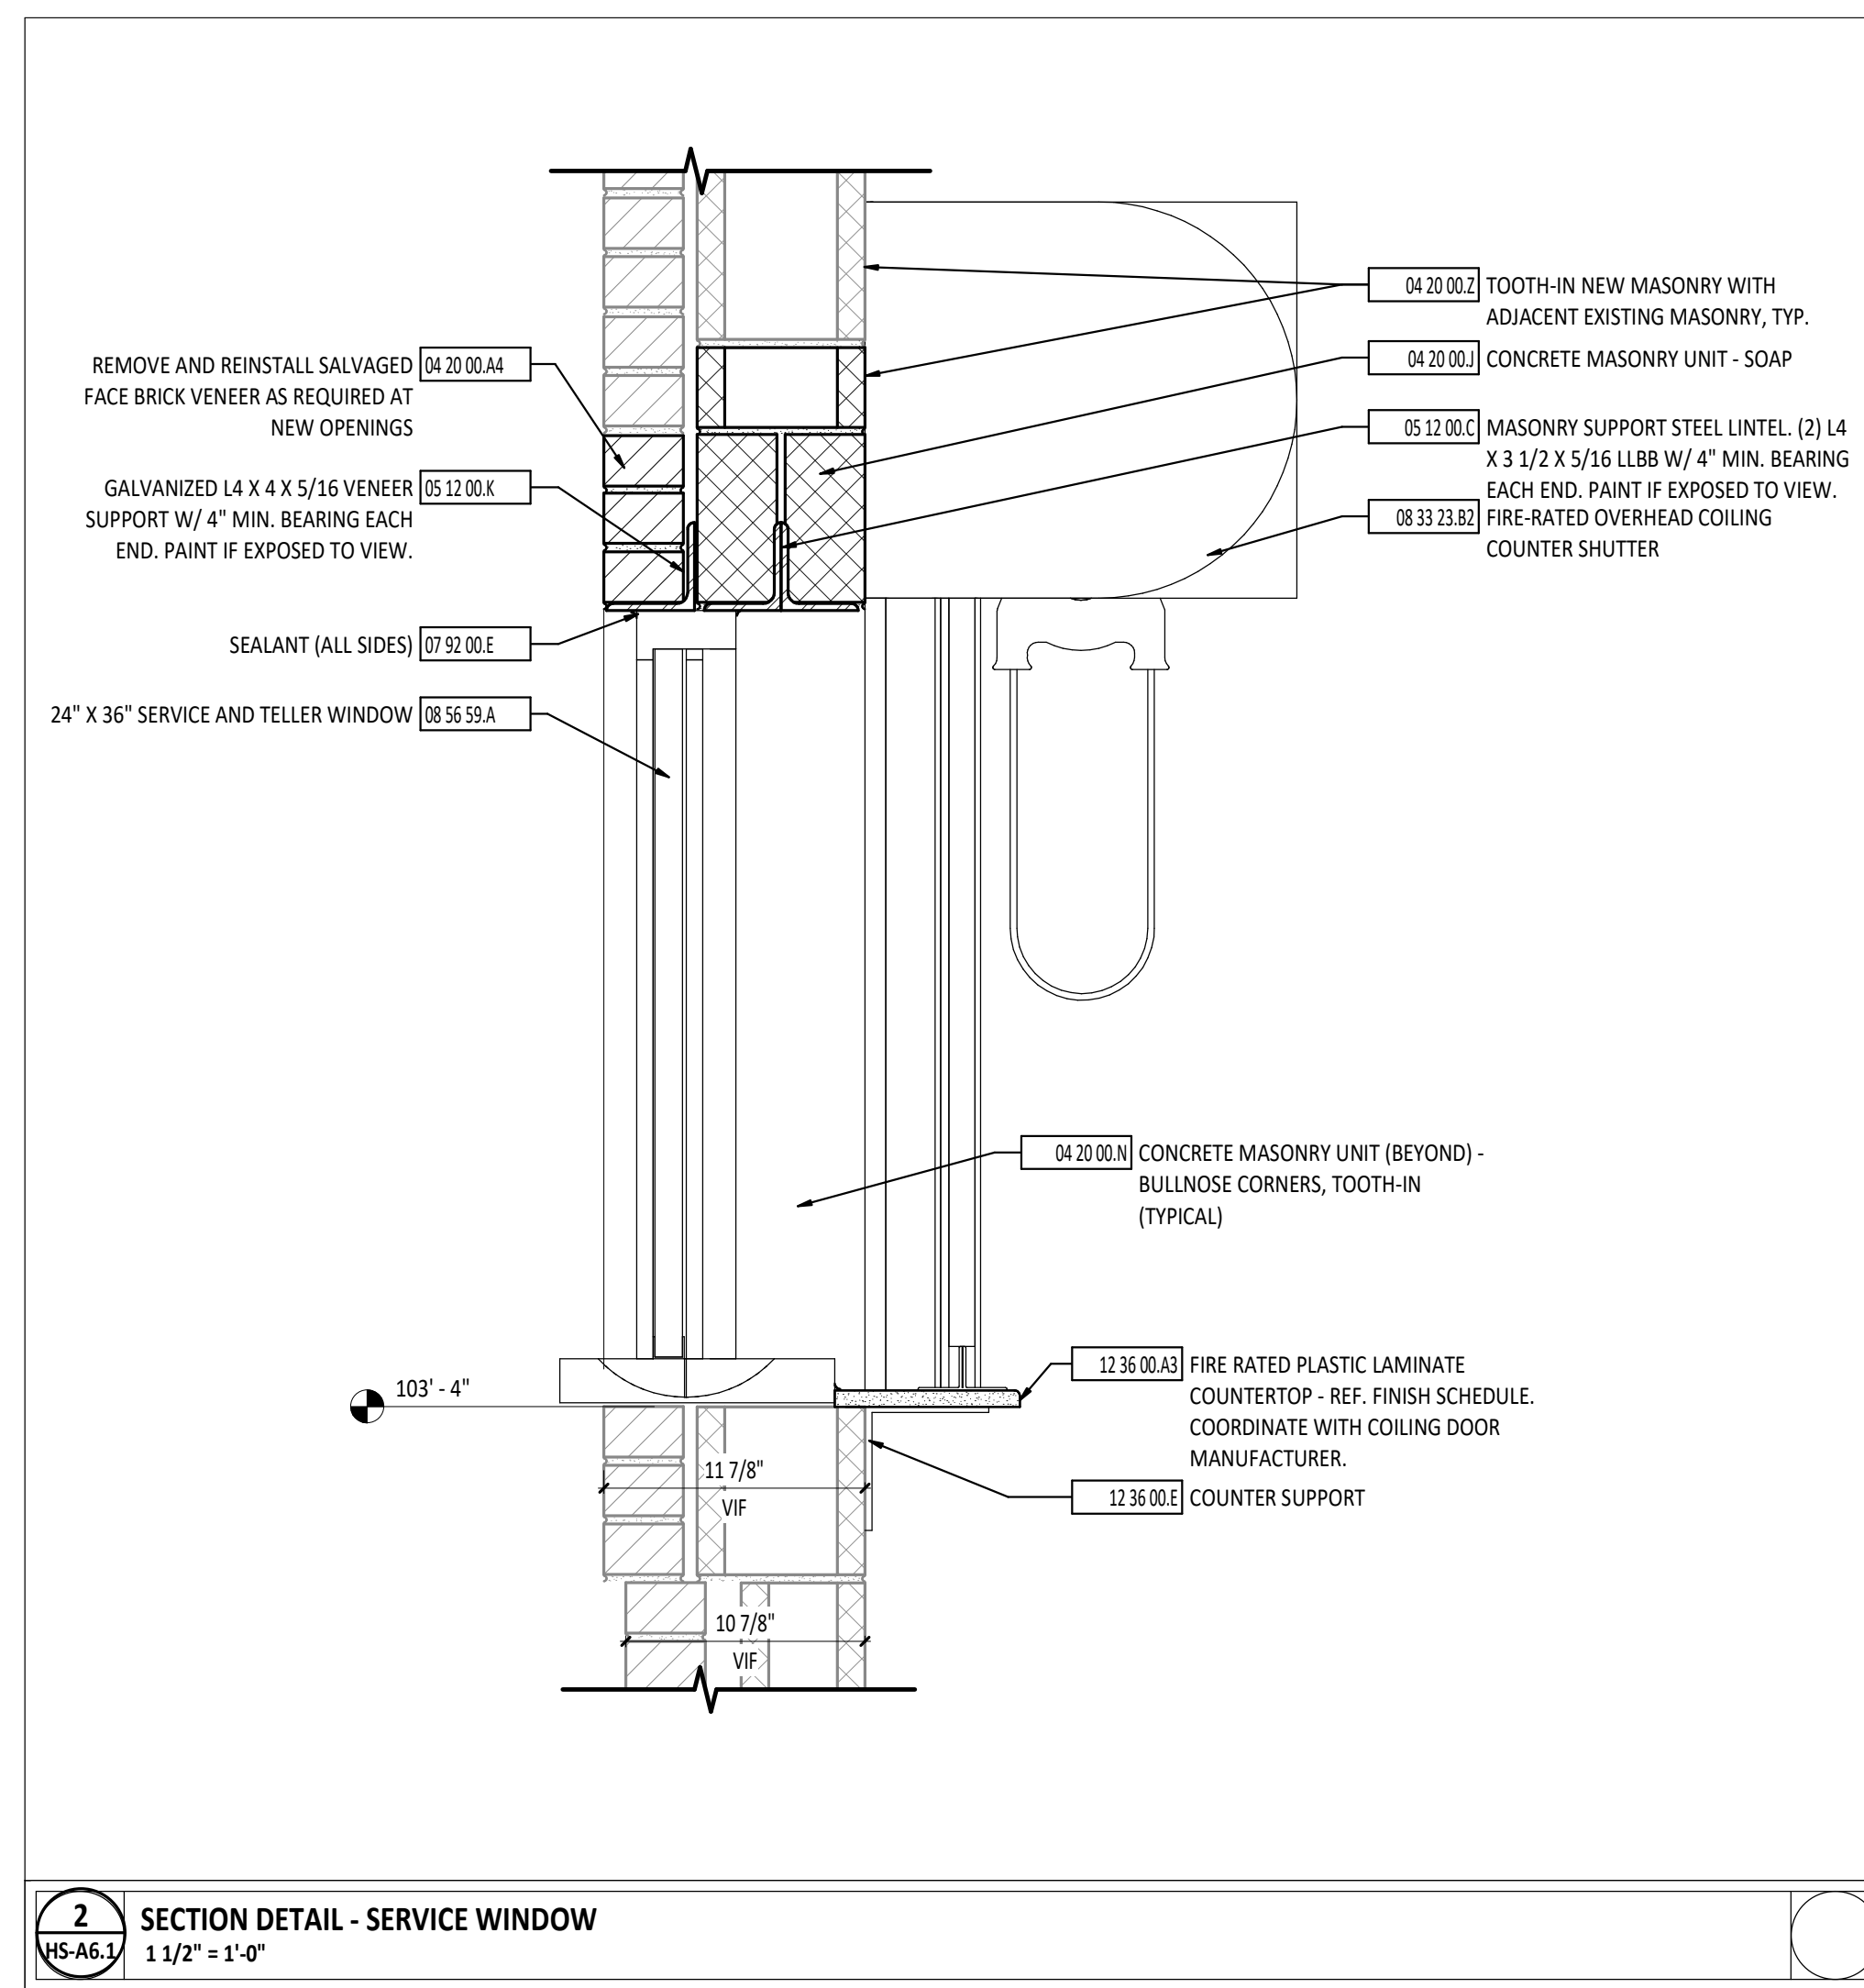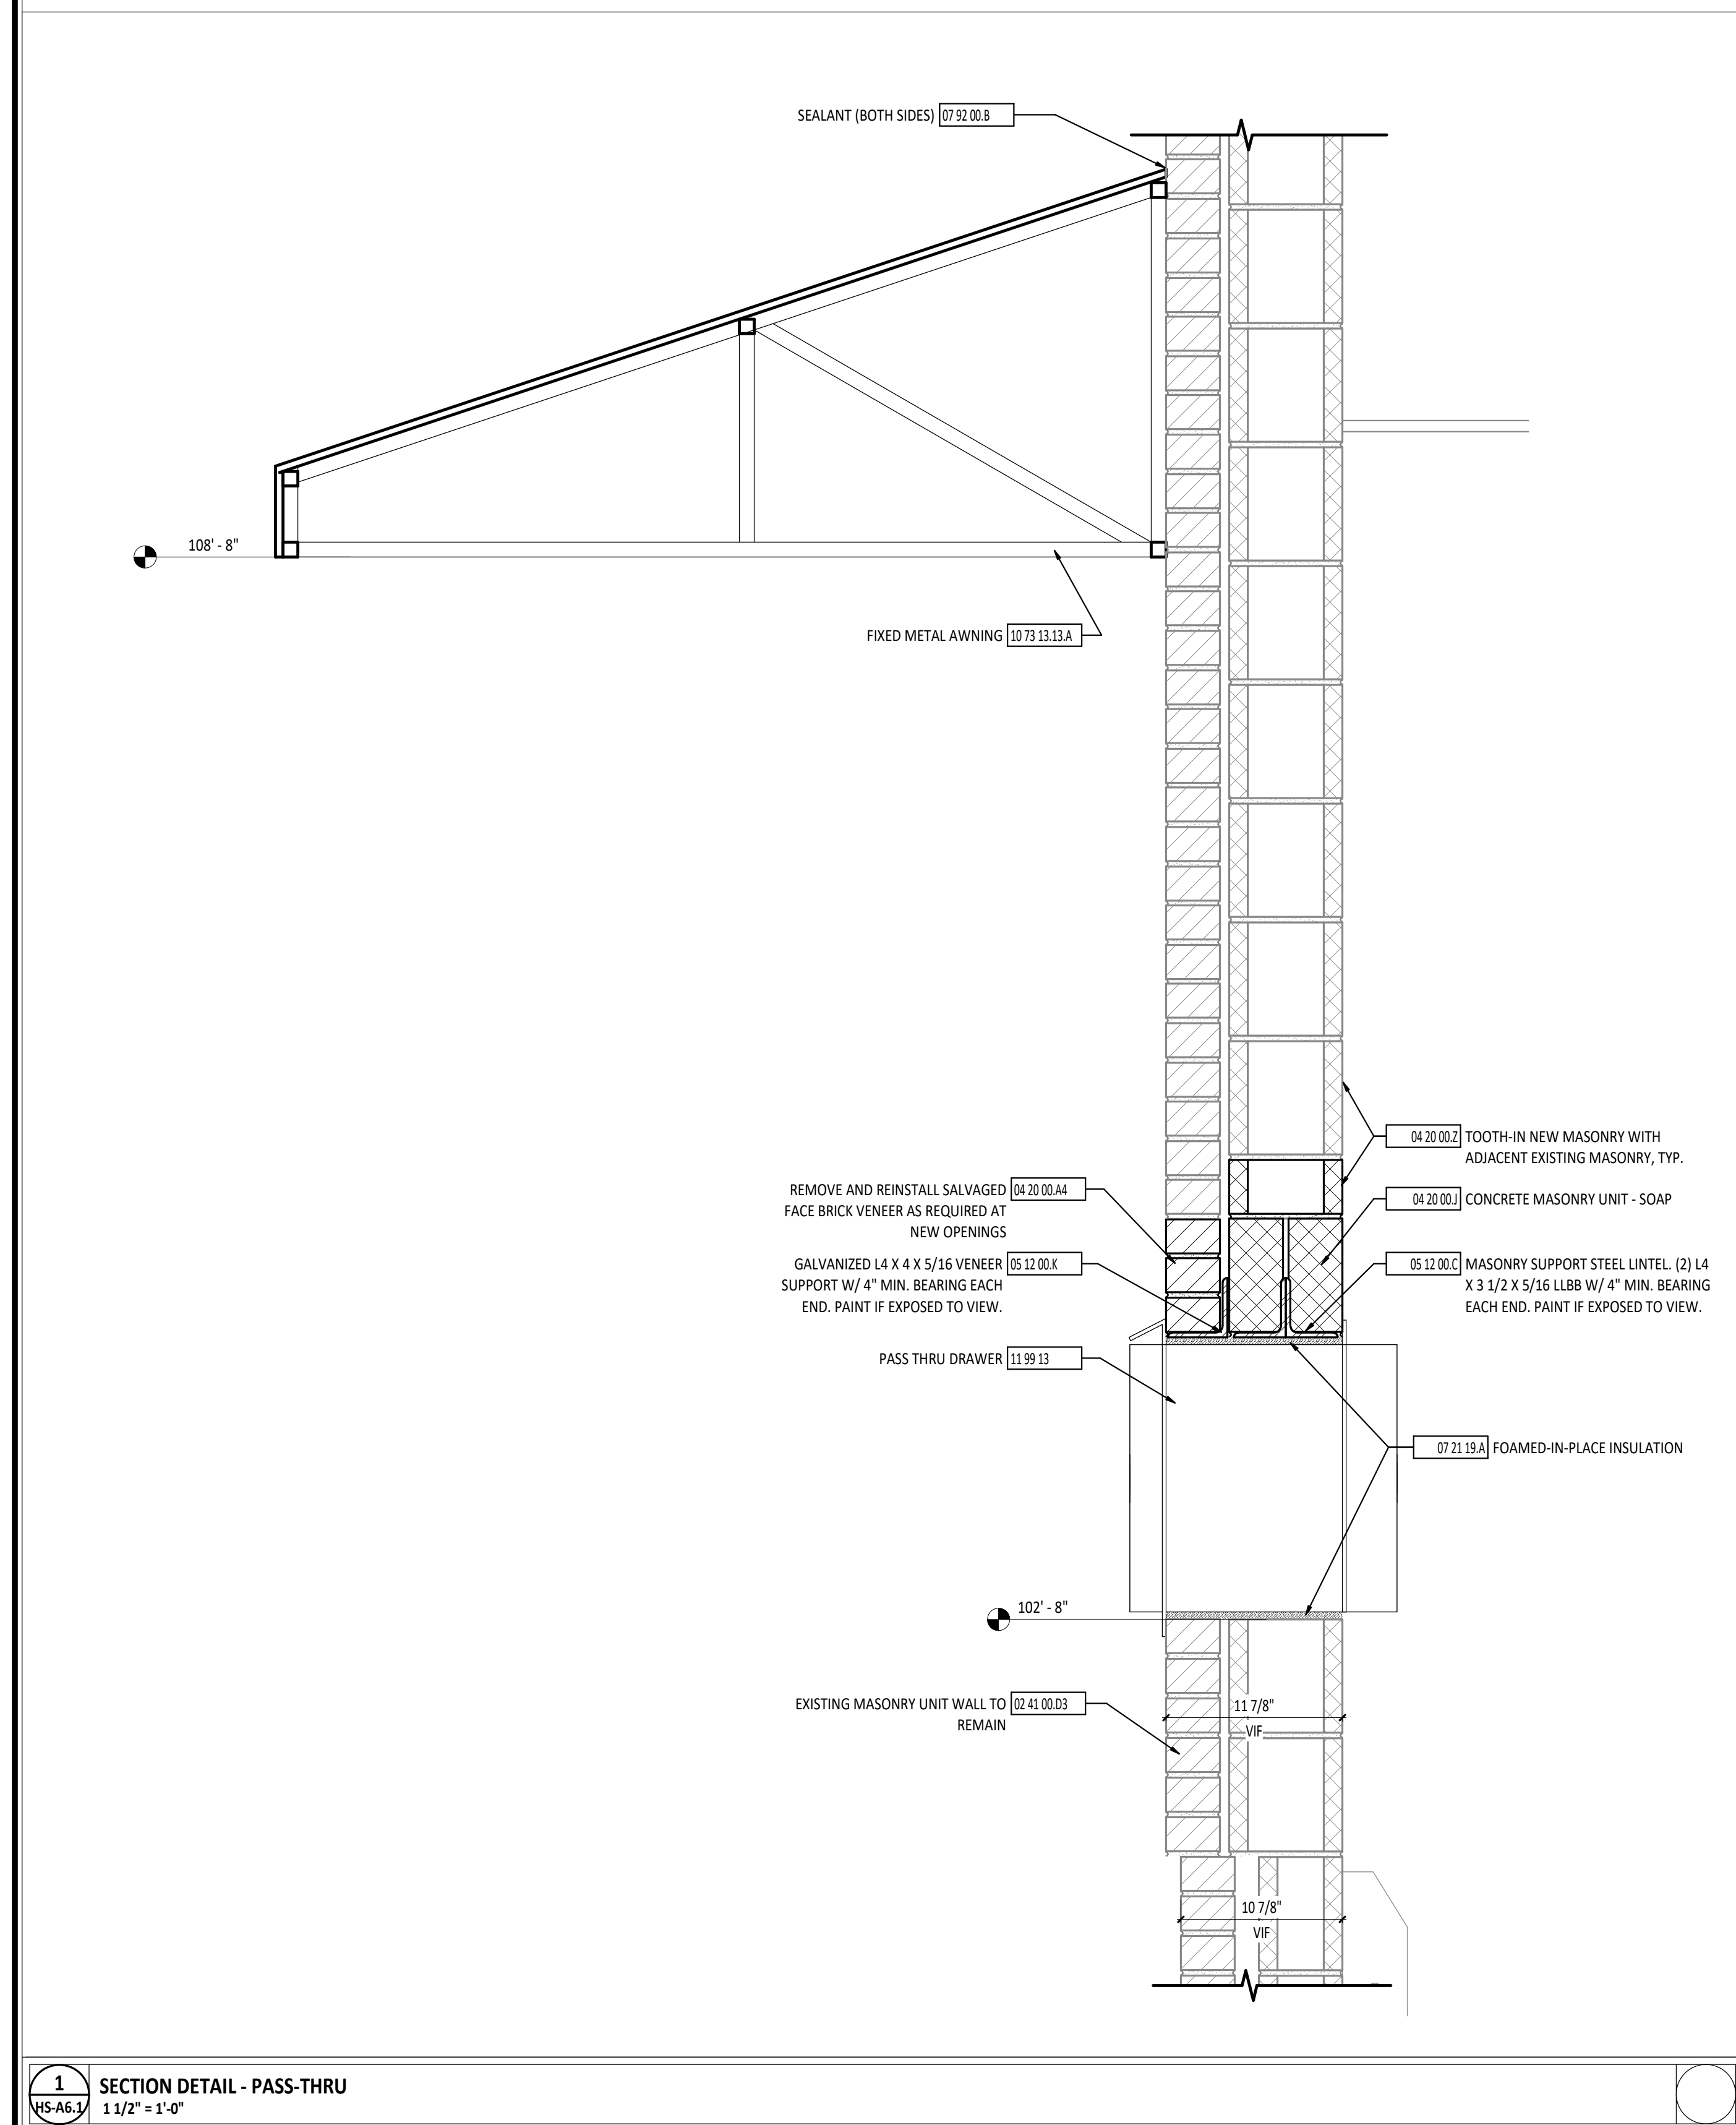

**DOOR GENERAL NOTES**

B REFERENCE SPECIFICATION SECTION 08 71 00 FOR HARDWARE SETS.


**DOOR/OPENING SCHEDULE ABBREVIATIONS**

**SYMBOL DESCRIPTION**

- AL ALUMINUM
- F FLUSH
- FG FULL GLASS
- HG HALF GLASS
- HM HOLLOW METAL
- NL NARROW LITE
- WD WOOD
- EXIST EXISTING

**DOOR/OPENING SCHEDULE NOTES**

1. EXISTING DOOR TO REMAIN. MODIFY DOOR AS REQUIRED TO RECEIVE NEW SCHEDULED HARDWARE.

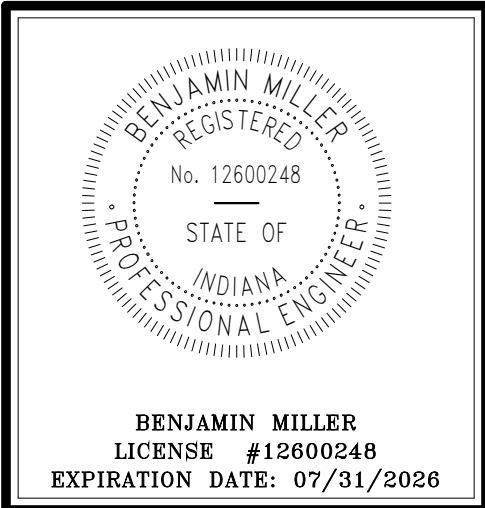

**JENNINGS COUNTY SCHOOL CORPORATIONS**  
**HIGH SCHOOL**  
 800 WALNUT STREET, NORTHVERNON, INDIANA 47255


ISSUANCES/REVISIONS		
CONSTRUCTION DOCUMENTS	02/26/2025	
1 ADDENDUM #02	04/13/2025	

PROJECT NUMBER:	DRAWN BY:	CHECKED BY:
25064	SRS	TAL


SHEET TITLE:  
**DOOR SCHEDULE AND DETAILS**

SHEET NUMBER:  
**HS-A6.1**


DOOR/OPENING SCHEDULE																	
NUMBER	SIZE	DOOR				FRAME				DETAIL NUMBER			HARDWARE SET	ROOM KEY	FUNCTION	LABEL (MIN)	NOTES
		THK	MATL	TYPE	GLASS	DEPTH	MATL	TYPE	GLASS	HEAD	JAMB	SILL					
MS101A	(2) 3'-0" x 7'-0"	1 3/4"	AL	EXIST	EXIST	4 1/2"	AL	EXIST	EXIST	-	-	-	030	EXT	Exterior	-	1
MS101B	(2) 3'-0" x 7'-0"	1 3/4"	AL	EXIST	EXIST	4 1/2"	AL	EXIST	EXIST	-	-	-	035	EXT	Exterior	-	1
MS101C	(2) 3'-0" x 7'-0"	1 3/4"	AL	EXIST	EXIST	4 1/2"	AL	EXIST	EXIST	-	-	-	035	EXT	Exterior	-	1
MS101D	(2) 3'-0" x 7'-0"	1 3/4"	AL	EXIST	EXIST	4 1/2"	AL	EXIST	EXIST	-	-	-	030	MS101	Interior	-	1
MS101E	(2) 3'-0" x 7'-0"	1 3/4"	AL	EXIST	EXIST	4 1/2"	AL	EXIST	EXIST	-	-	-	035	MS101	Interior	-	1
MS101F	(2) 3'-0" x 7'-0"	1 3/4"	AL	EXIST	EXIST	4 1/2"	AL	EXIST	EXIST	-	-	-	030	MS101	Interior	-	1
MS102A	(2) 3'-0" x 7'-0"	1 3/4"	WD	EXIST	EXIST	5 3/4"	HM	EXIST	EXIST	-	-	-	006	MS102	Interior	-	1
MS102B	(2) 3'-0" x 7'-0"	1 3/4"	WD	EXIST	EXIST	5 3/4"	HM	EXIST	EXIST	-	-	-	006	MS102	Interior	-	1
MS103	3'-0" x 7'-0"	1 3/4"	WD	EXIST	EXIST	5 3/4"	HM	EXIST	EXIST	-	-	-	036	MS103	Interior	-	1
MS105	(2) 3'-0" x 7'-0"	1 3/4"	WD	EXIST	EXIST	5 3/4"	HM	EXIST	EXIST	-	-	-	014	MS107	Interior	-	1

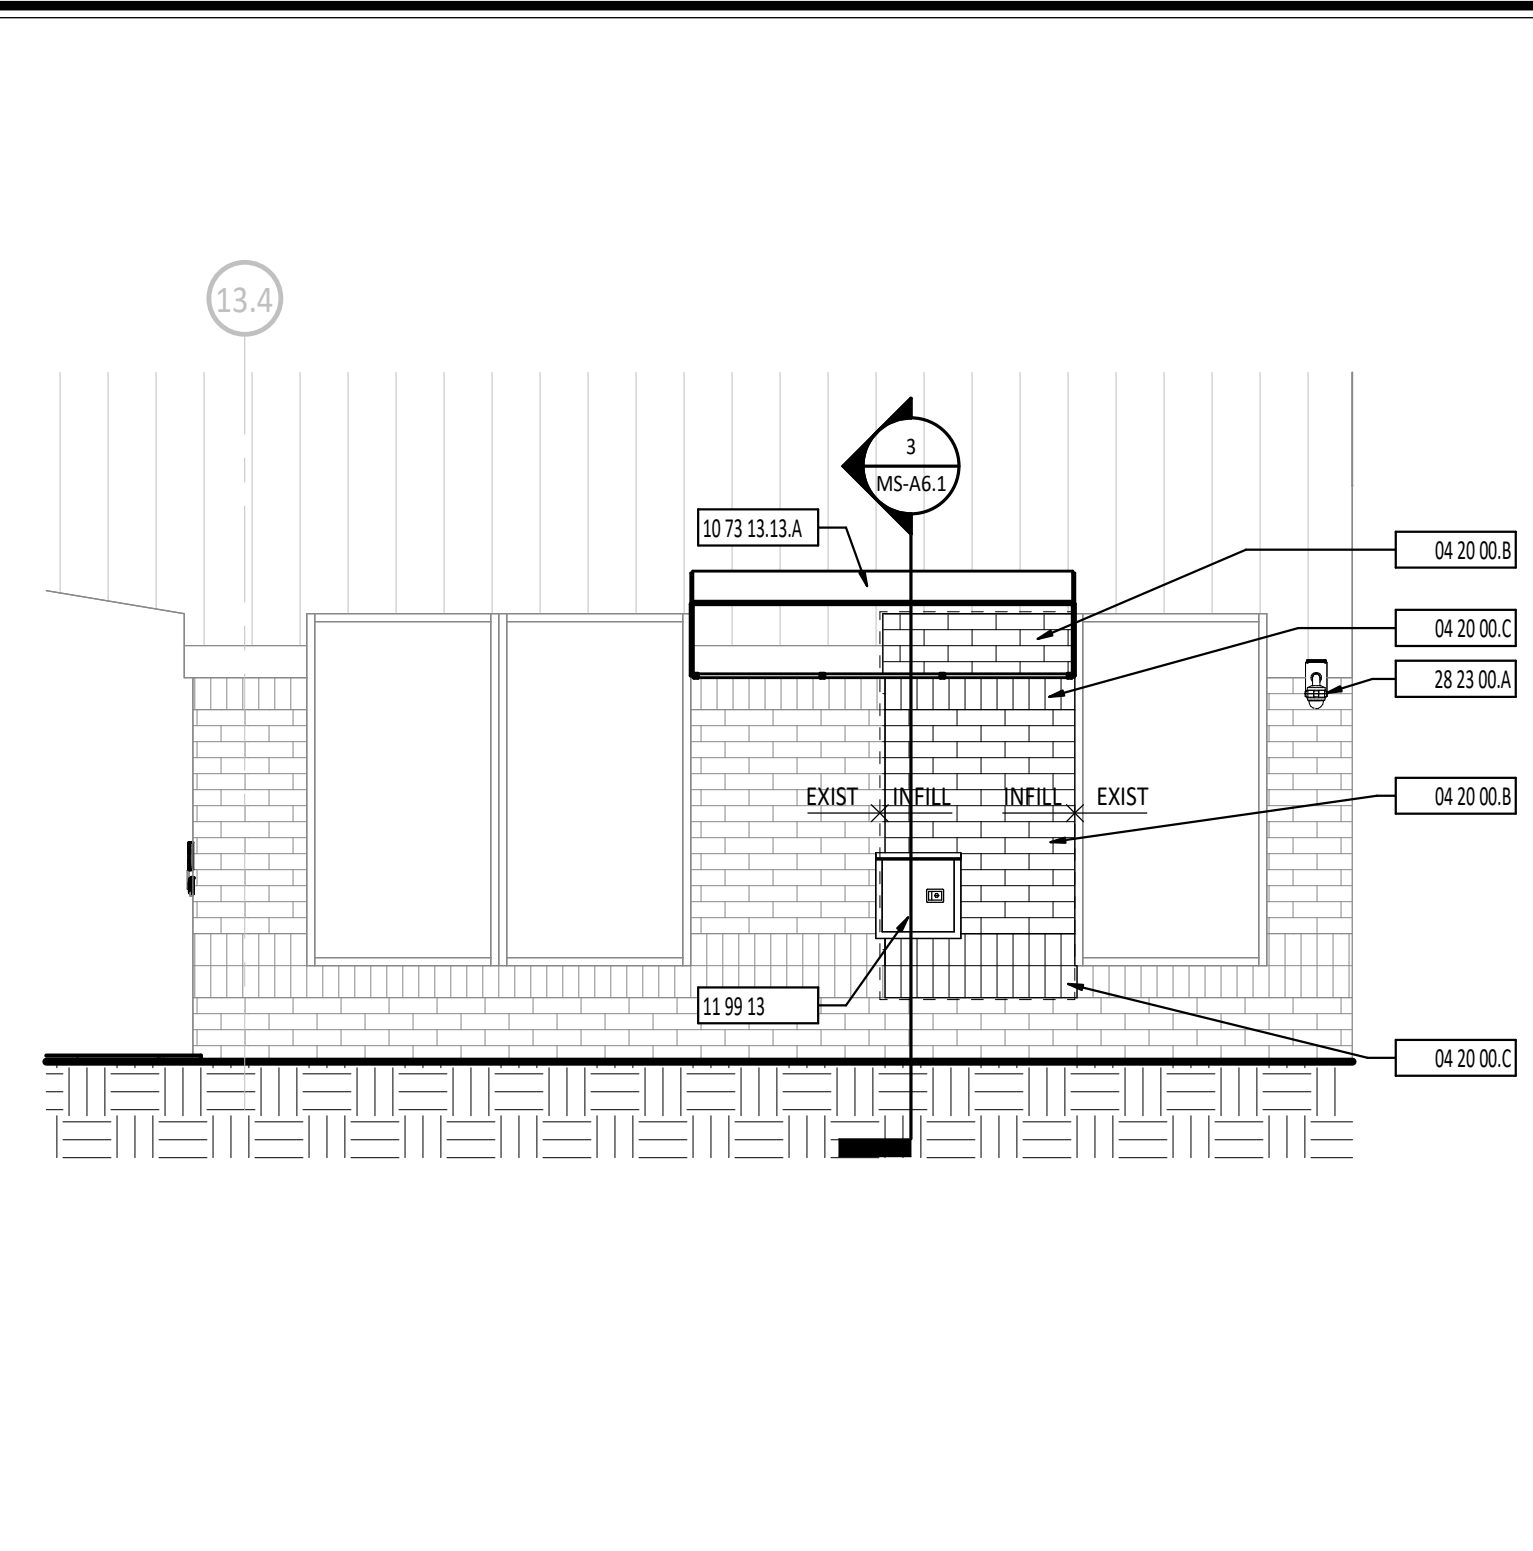


**1 EAST ELEVATION**  
1/4" = 1'-0"

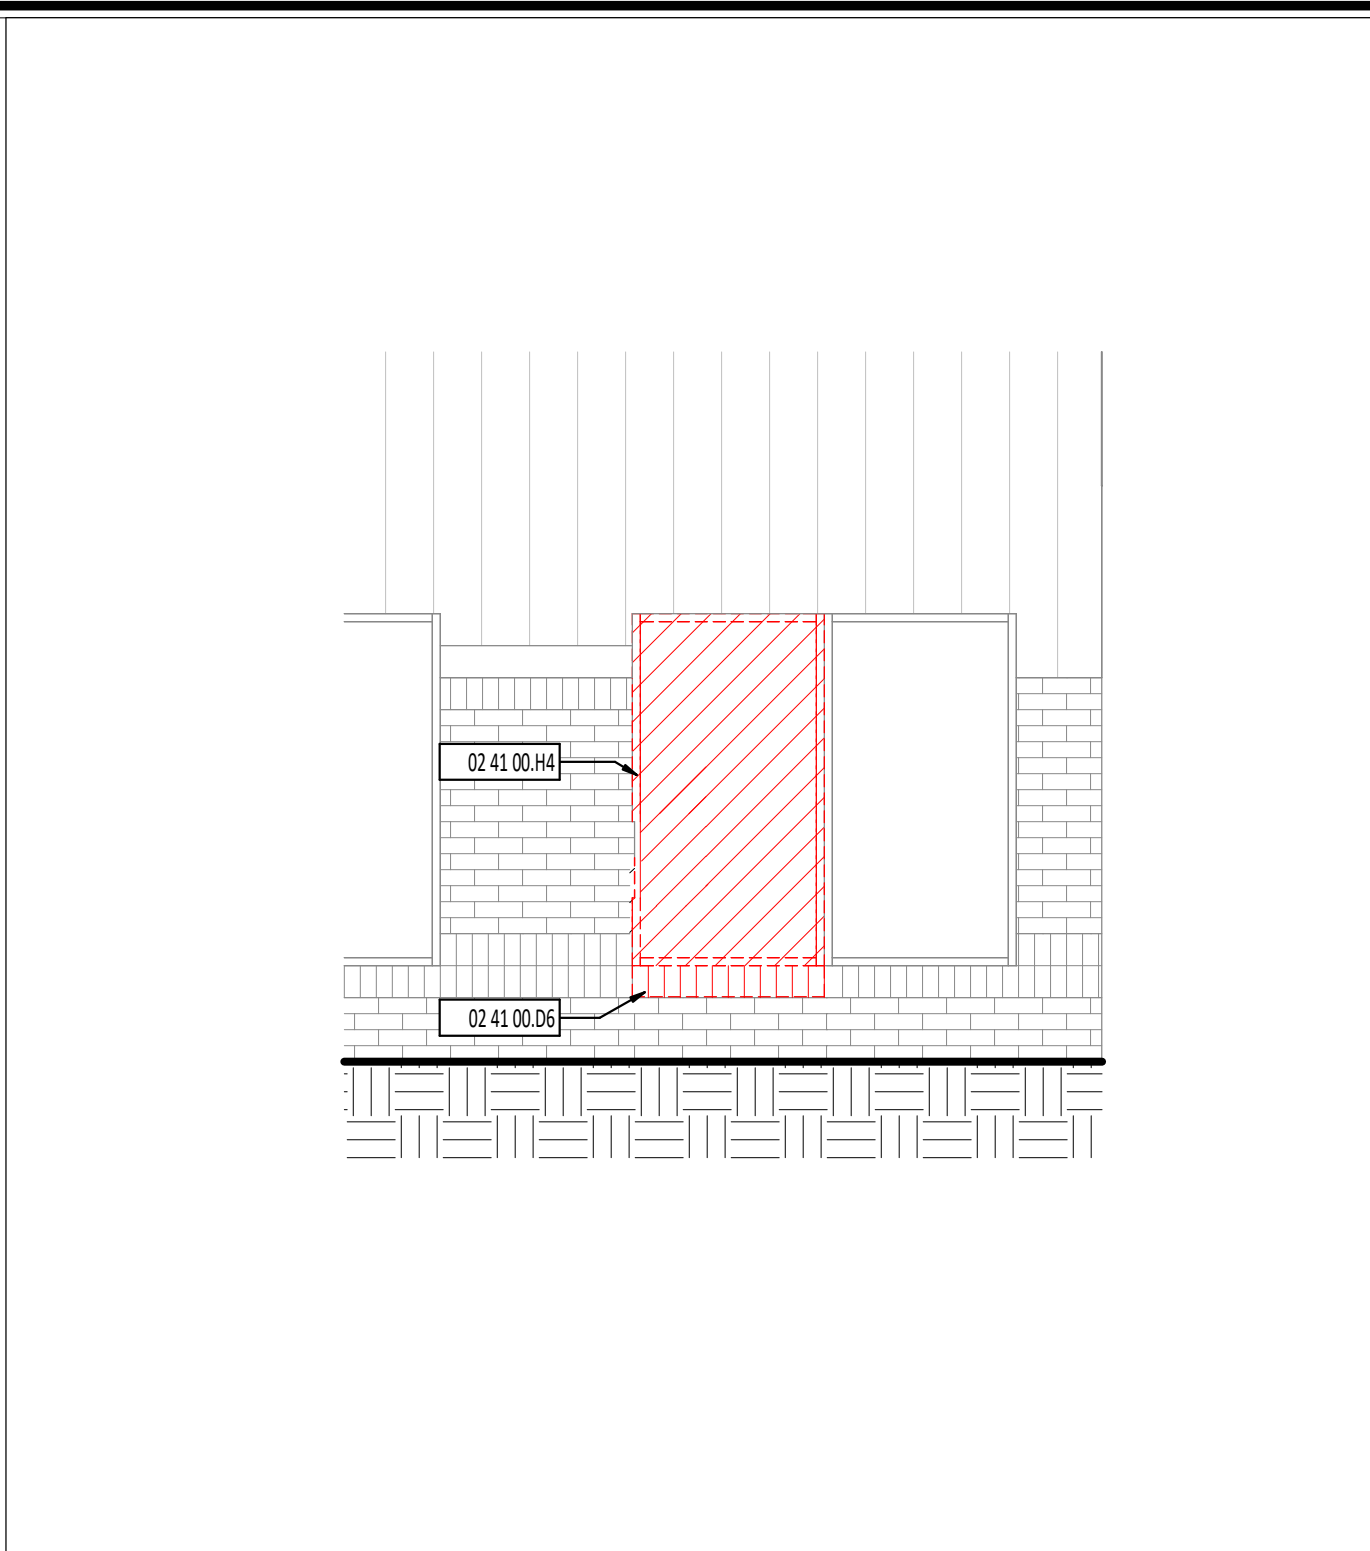

**2 EAST ELEVATION - DEMO**  
1/4" = 1'-0"

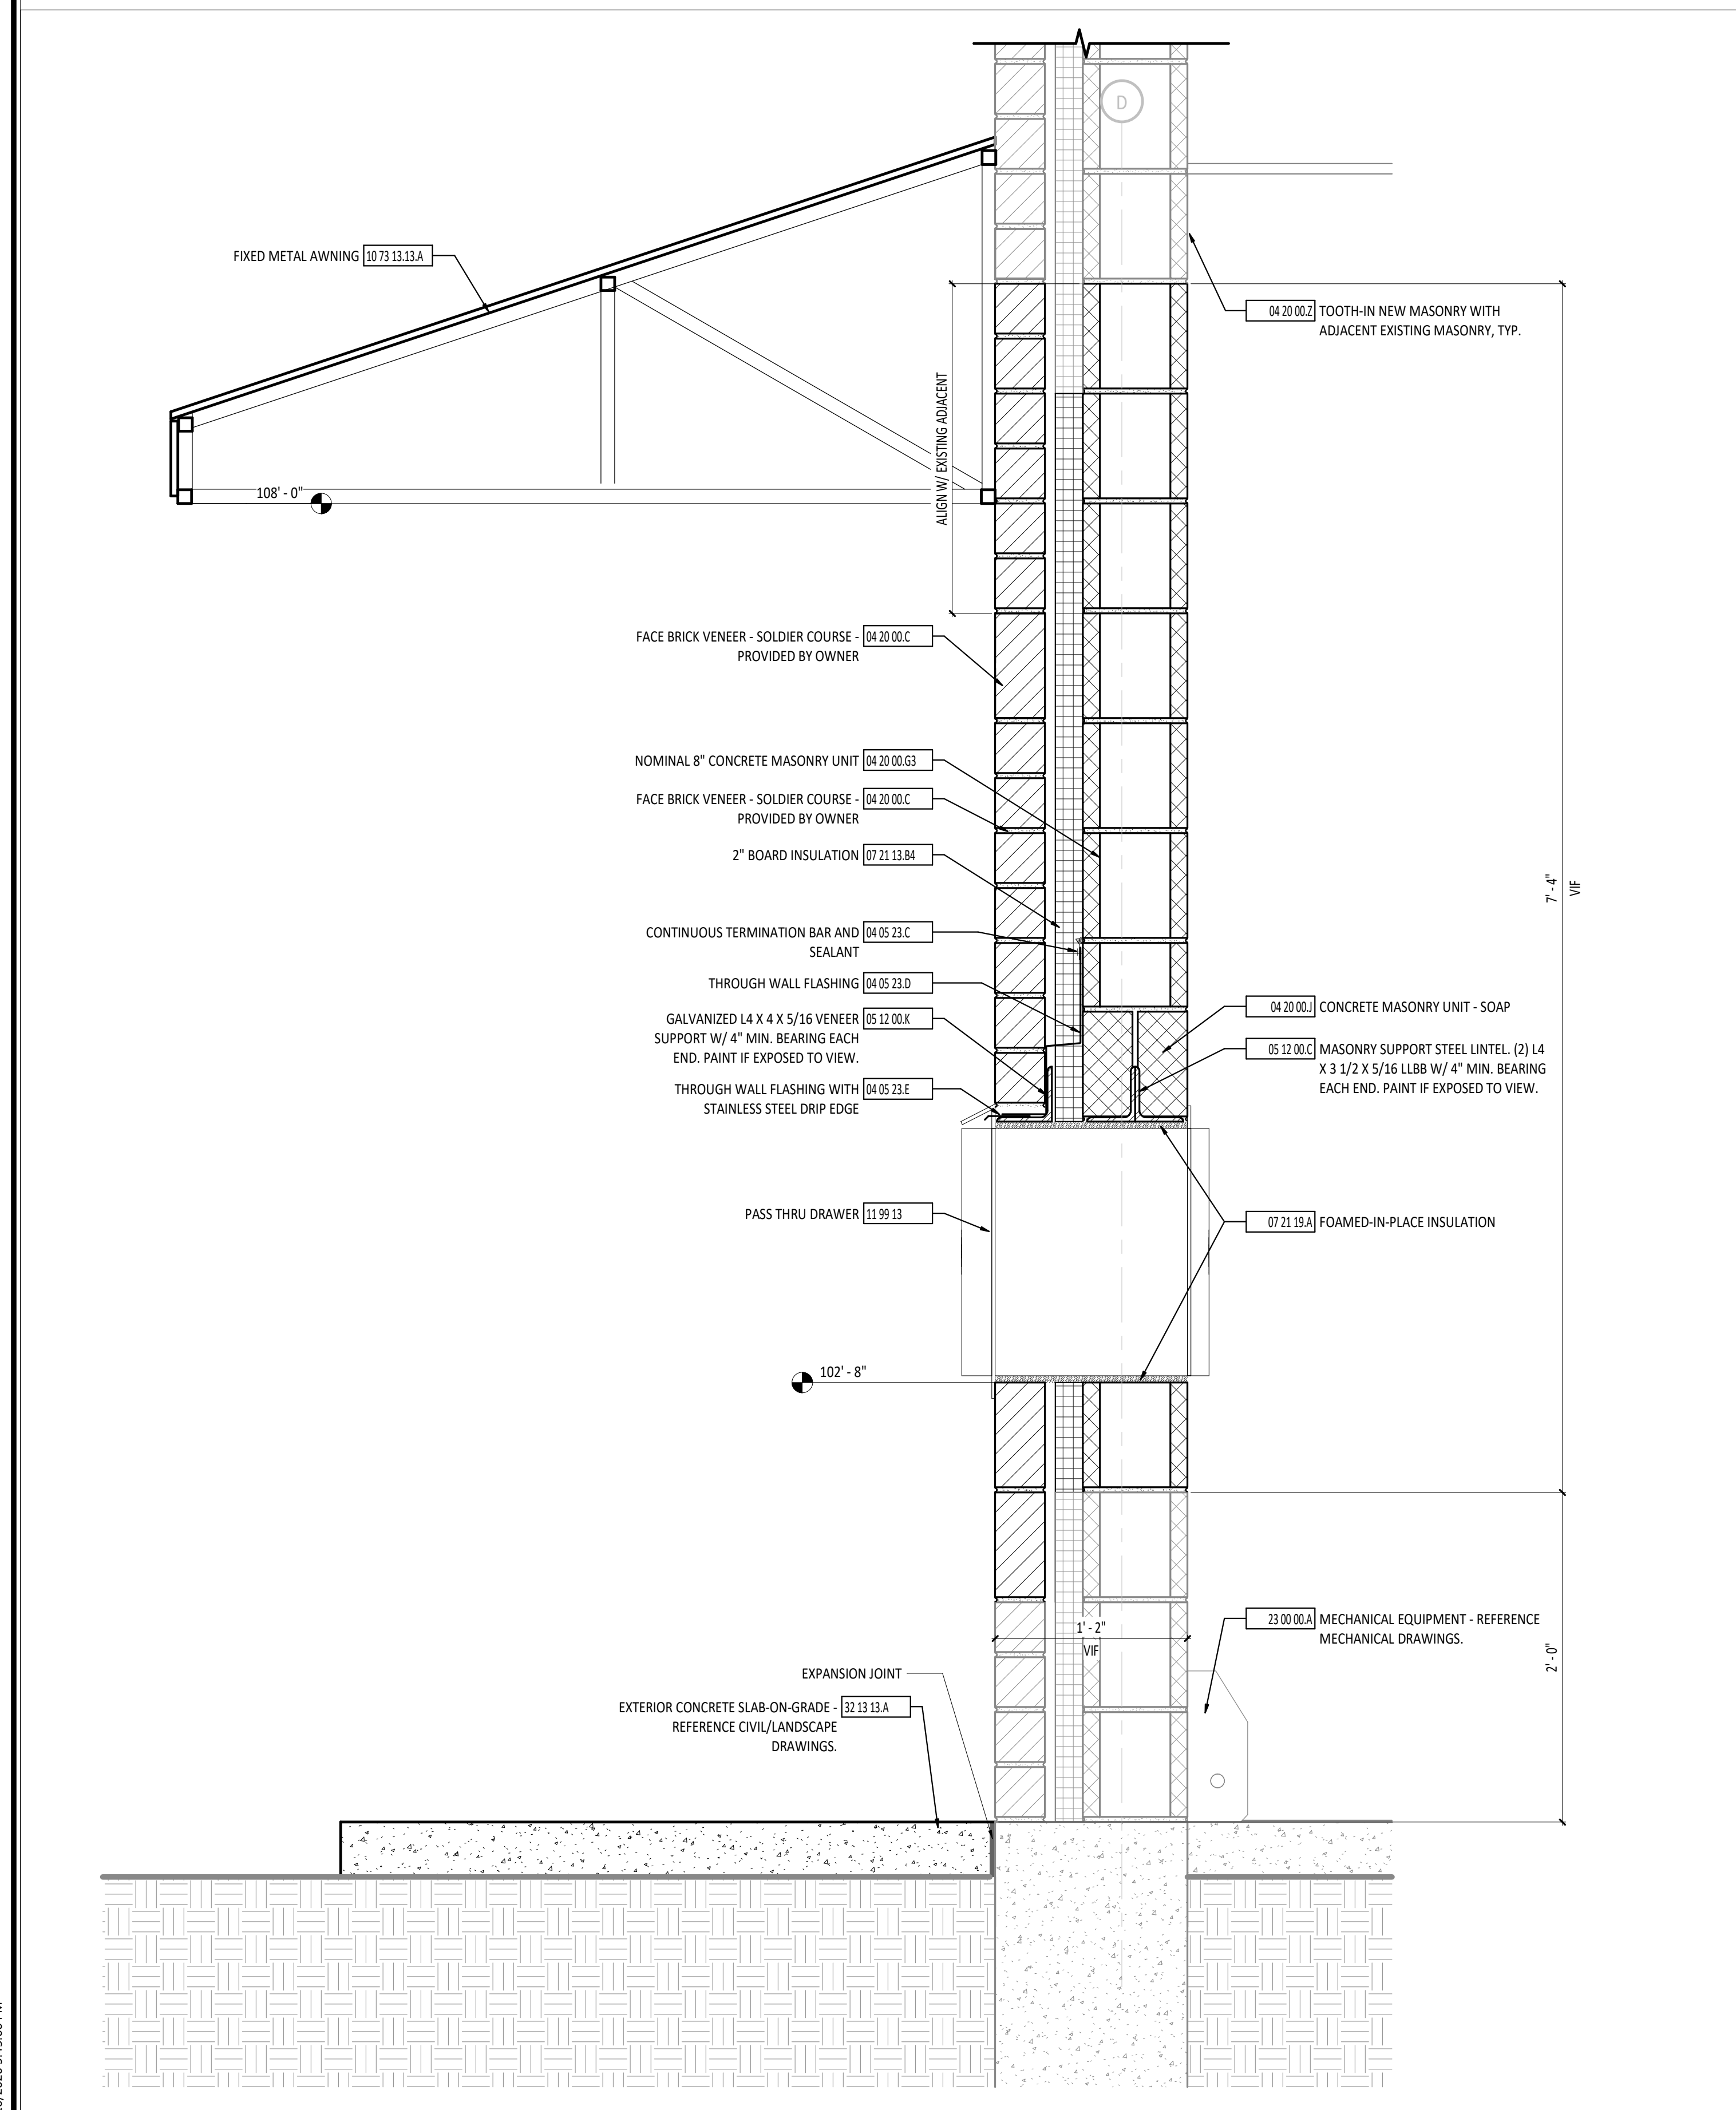

**3 SECTION DETAIL - PASS-THRU DRAWER**  
1 1/2" = 1'-0"

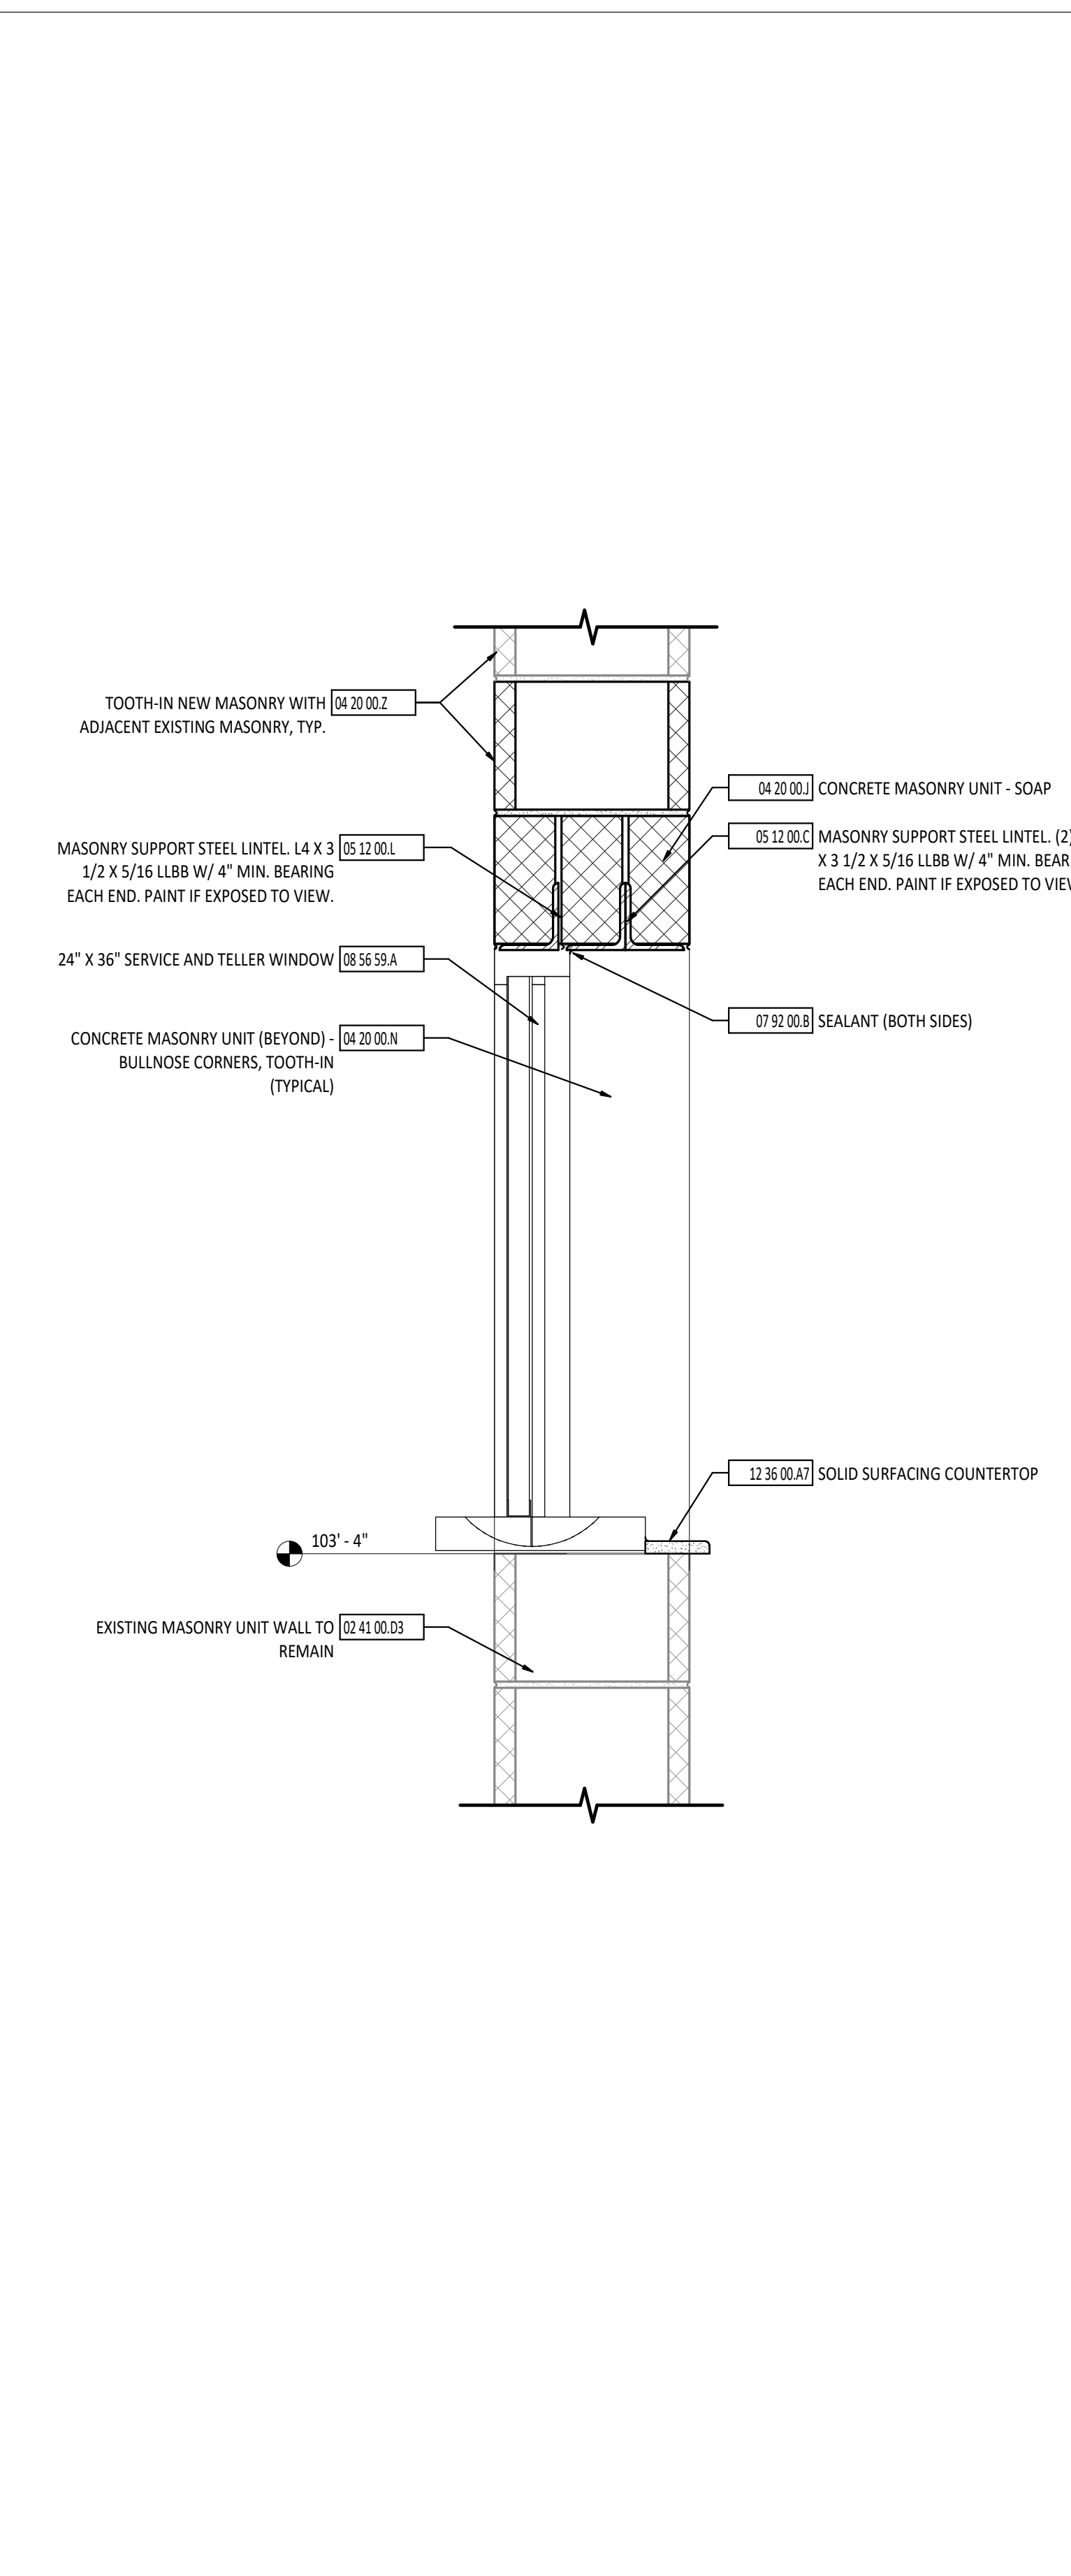

**4 SECTION DETAIL - SERVICE WINDOW**  
1 1/2" = 1'-0"

**DOOR GENERAL NOTES**

8 REFERENCE SPECIFICATION SECTION 08 71 00 FOR HARDWARE SETS.

**DOOR/OPENING SCHEDULE NOTES**

1. EXISTING DOOR TO REMAIN

**DOOR/OPENING SCHEDULE ABBREVIATIONS**


**SYMBOL DESCRIPTION**

AL ALUMINUM  
F FLUSH  
FG FULL GLASS  
HG HALF GLASS  
HM HOLLOW METAL  
NL NARROW LITE  
WD WOOD

**GLAZING TYPES**

G1 - 1/4" TEMPERED GLAZING  
SG1 - SECURITY GLAZING  
FG1 - 1 HOUR FIRE RATED GLAZING  
FG2 - 1 HOUR FIRE RATED SECURITY GLAZING

#	KEYNOTE DESCRIPTION
02 41 00 D3	EXISTING MASONRY UNIT WALL TO REMAIN
02 41 00 D6	REMOVE EXISTING FACE BRICK VENEER SILL. SALVAGE TO OWNER.
02 41 00 H4	REMOVE EXISTING WINDOW - PREPARE FOR NEW WORK.
04 05 23 C	CONTINUOUS TERMINATION BAR AND SEALANT
04 05 23 D	THROUGH WALL FLASHING
04 05 23 E	THROUGH WALL FLASHING WITH STAINLESS STEEL DRIP EDGE
04 20 00 B	FACE BRICK VENEER - PROVIDED BY OWNER
04 20 00 C	FACE BRICK VENEER - SOLDIER COURSE - PROVIDED BY OWNER
04 20 00 G3	NOMINAL 8" CONCRETE MASONRY UNIT
04 20 00 J	CONCRETE MASONRY UNIT - SOAP
04 20 00 N	CONCRETE MASONRY UNIT (BEYOND) - BULLNOSE CORNERS, TOOTH-IN (TYPICAL)
04 20 00 I	TOOTH-IN NEW MASONRY WITH ADJACENT EXISTING MASONRY, TYP.
05 12 00 C	MASONRY SUPPORT STEEL LINTEL (2) L4 X 3 1/2 X 5/16 LBB W/ 4" MIN. BEARING EACH END. PAINT IF EXPOSED TO VIEW.
05 12 00 X	GALVANIZED L4 X 4 X 5/16 VENEER SUPPORT W/ 4" MIN. BEARING EACH END. PAINT IF EXPOSED TO VIEW.
05 12 00 L	MASONRY SUPPORT STEEL LINTEL L4 X 3 1/2 X 5/16 LBB W/ 4" MIN. BEARING EACH END. PAINT IF EXPOSED TO VIEW.
07 21 13 B4	2" BOARD INSULATION
07 21 19 A	FOAMED-IN-PLACE INSULATION
07 92 00 B	SEALANT (BOTH SIDES)
08 56 59 A	24" X 36" SERVICE AND TELLER WINDOW
10 73	FIXED METAL AWNING
13 13 A	PASS THRU DRAWER
12 36 00 A7	SOLID SURFACING COUNTERTOP
23 00 00 A	MECHANICAL EQUIPMENT - REFERENCE MECHANICAL DRAWINGS.
28 23 00 A	EXTERIOR SECURITY CAMERA - REFERENCE TECHNOLOGY DRAWINGS.
32 13 13 A	EXTERIOR CONCRETE SLAB ON-GRADE - REFERENCE CIVIL/LANDSCAPE DRAWINGS.

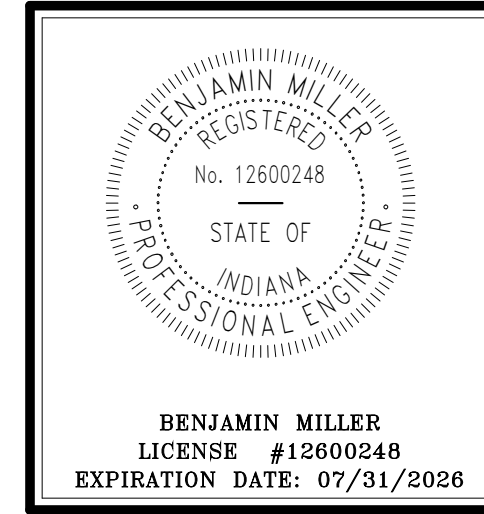

**JENNINGS COUNTY SCHOOL CORPORATIONS**  
**MIDDLE SCHOOL**

800 WALNUT STREET, NORTHVENON, INDIANA 47255


ISSUANCES/REVISIONS		
CONSTRUCTION DOCUMENTS	03/26/2025	
1 ADDENDUM #02	04/13/2025	

PROJECT NUMBER:	DRAWN BY:	CHECKED BY:
25064	SRS	TAL


SHEET TITLE:  
**DOOR SCHEDULE AND DETAILS**

SHEET NUMBER:  
**MS-A6.1**

NUMBER	DOOR/OPENING SCHEDULE										HARDWARE SET A	ROOM KEY	FUNCTION	LABEL (MIN)	NOTES		
	DOOR					FRAME											
	SIZE	THK	MATL	TYPE	GLASS	DEPTH	MATL	TYPE	GLASS	DETAIL NUMBER							
S101A	(2) 3'-0" x 7'-0"	1 3/4"	AL	EXIST	EXIST	4 1/2"	AL	EXIST	EXIST	-	-	-	039	EXT	Exterior	-	1
S101B	(2) 3'-0" x 7'-0"	1 3/4"	AL	EXIST	EXIST	4 1/2"	AL	EXIST	EXIST	-	-	-	035	EXT	Exterior	-	1
S101C	(2) 3'-0" x 7'-0"	1 3/4"	AL	EXIST	EXIST	4 1/2"	AL	EXIST	EXIST	-	-	-	035	S101	Interior	-	1
S101D	(2) 3'-0" x 7'-0"	1 3/4"	AL	EXIST	EXIST	4 1/2"	AL	EXIST	EXIST	-	-	-	038	S101	Interior	-	1
S102A	(2) 3'-0" x 7'-0"	1 3/4"	WD	FG	SG1	5 3/4"	HM	2	SG1	3/A6.1	4/A6.1	-	025	S102	Interior	-	-
S102B	(2) 3'-0" x 7'-0"	1 3/4"	WD	FG	SG1	5 3/4"	HM	2	SG1	3/A6.1	4/A6.1	-	025	S102	Interior	-	-
S103A	3'-0" x 7'-0"	1 3/4"	WD	FG	SG1	8 3/4"	HM	1	-	1/A6.1	2/A6.1	-	029	S102	Interior	-	-
S103B	3'-0" x 7'-0"	1 3/4"	WD	EXIST	EXIST	5 3/4"	HM	EXIST	EXIST	-	-	-	028A	103B	Interior	-	1
S103C	3'-4" x 3'-4"	-	-	-	SG1	8 3/4"	HM	-	-	5/A6.1	6/A.1	7/A6.1	-	-	Interior	-	-
S103E	3'-4" x 3'-4"	-	-	-	SG1	8 3/4"	HM	-	-	5/A6.1	6/A.1	7/A6.1	-	-	Interior	-	-

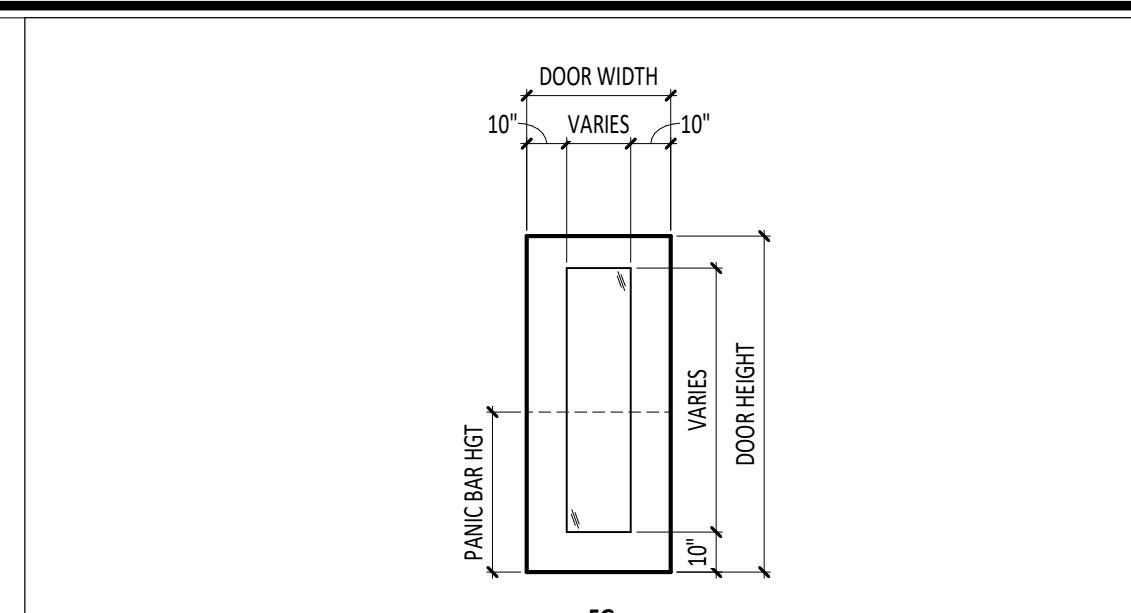

**DOOR TYPES**  
NTS

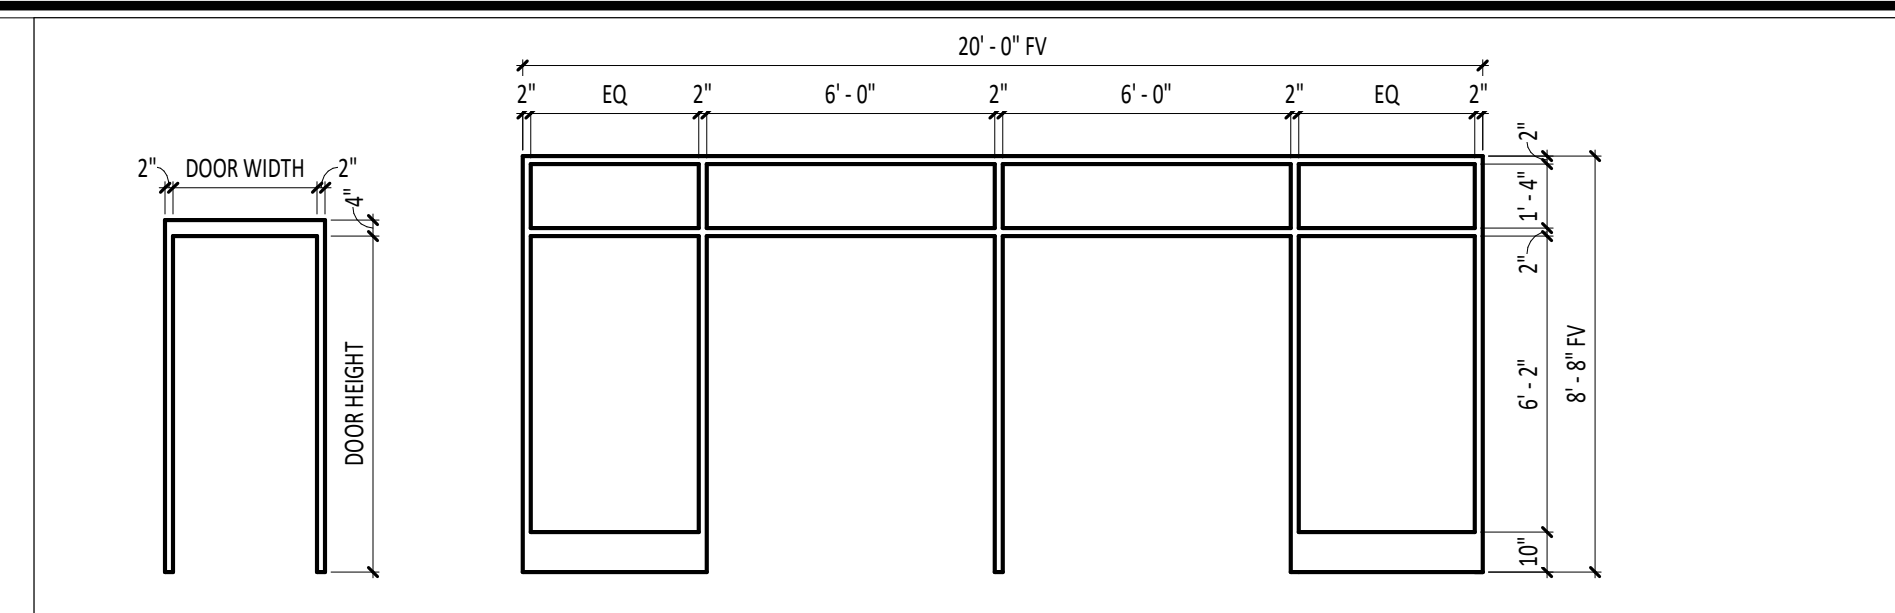

**HOLLOW METAL DOOR FRAME TYPES**  
NTS

**DOOR GENERAL NOTES**

8. REFERENCE SPECIFICATION SECTION 08 71 00 FOR HARDWARE SETS.

**DOOR/OPENING SCHEDULE NOTES**

1. EXISTING DOOR TO REMAIN. MODIFY DOOR AS REQUIRED TO RECEIVE NEW SCHEDULED HARDWARE.




**DOOR/OPENING SCHEDULE ABBREVIATIONS**

**SYMBOL DESCRIPTION**


AL ALUMINUM  
CD COILING DOOR  
DG DIFFUSING GLASS  
F FLUSH  
FG FULL GLASS  
FRG FIRE RATED GLASS  
HG HALF GLASS  
HM HOLLOW METAL  
IG INSULATED GLASS  
LG LAMINATED GLASS  
N NARROW LITE  
SG SAFETY GLASS  
TG TEMPERED GLASS  
W WOOD

**GLAZING TYPES**


G1 - 1/4" TEMPERED GLAZING  
SG1 - SECURITY GLAZING  
FG1 - 1 HOUR FIRE RATED GLAZING  
FG2 - 1 HOUR FIRE RATED SECURITY GLAZING

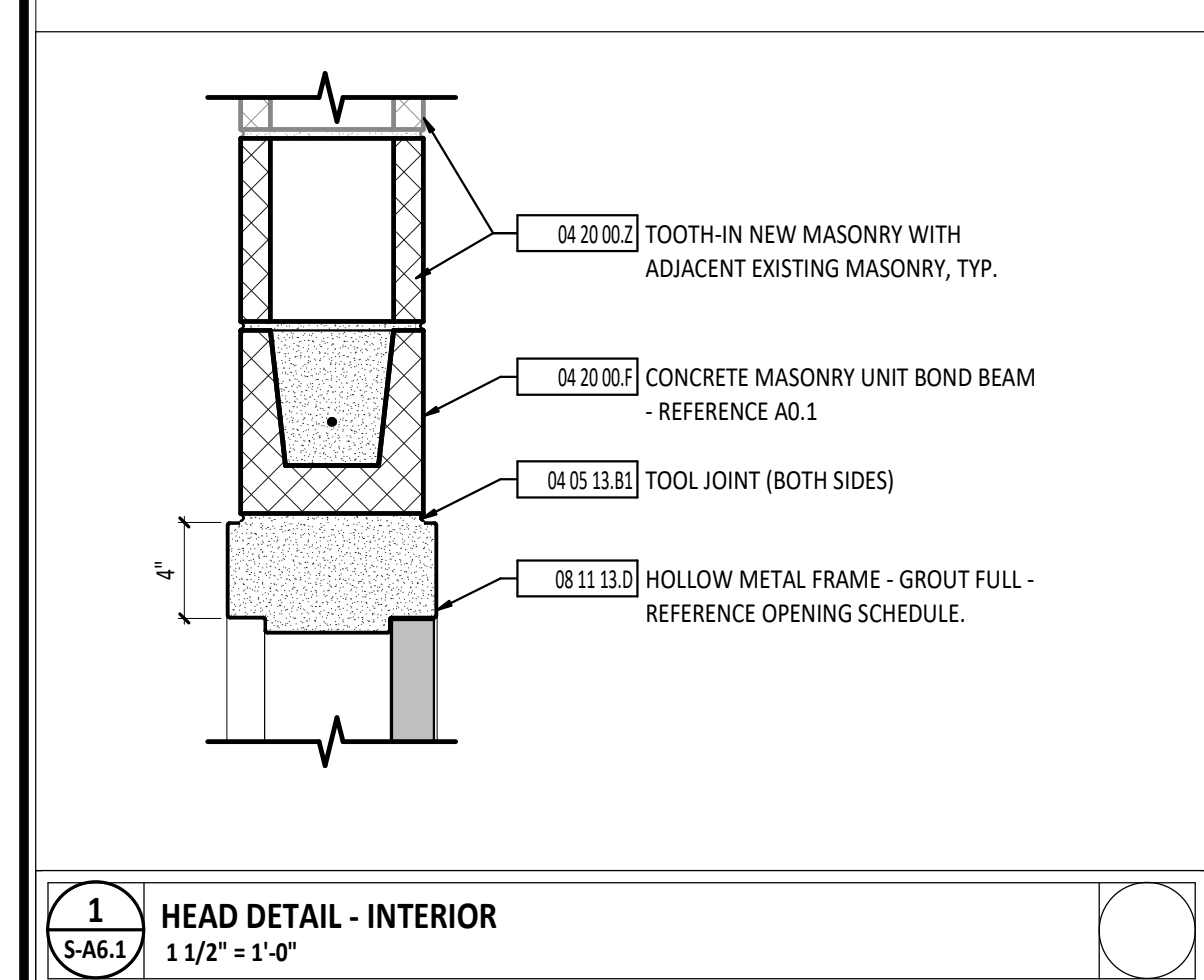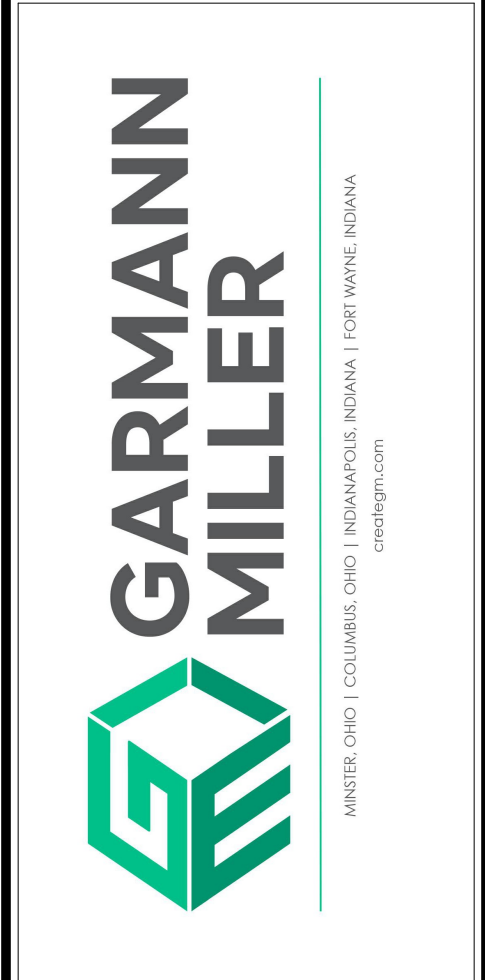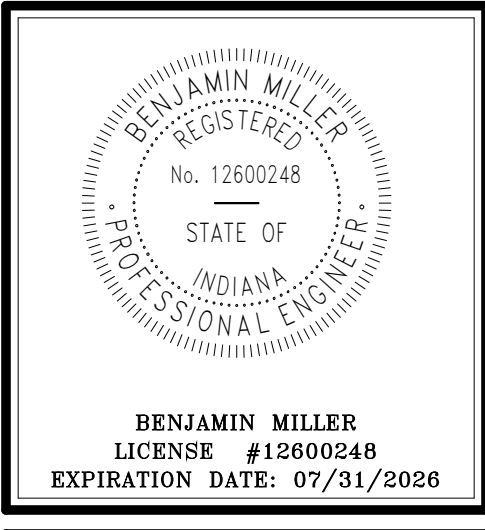


**1 HEAD DETAIL - INTERIOR**  
1 1/2" = 1'-0"

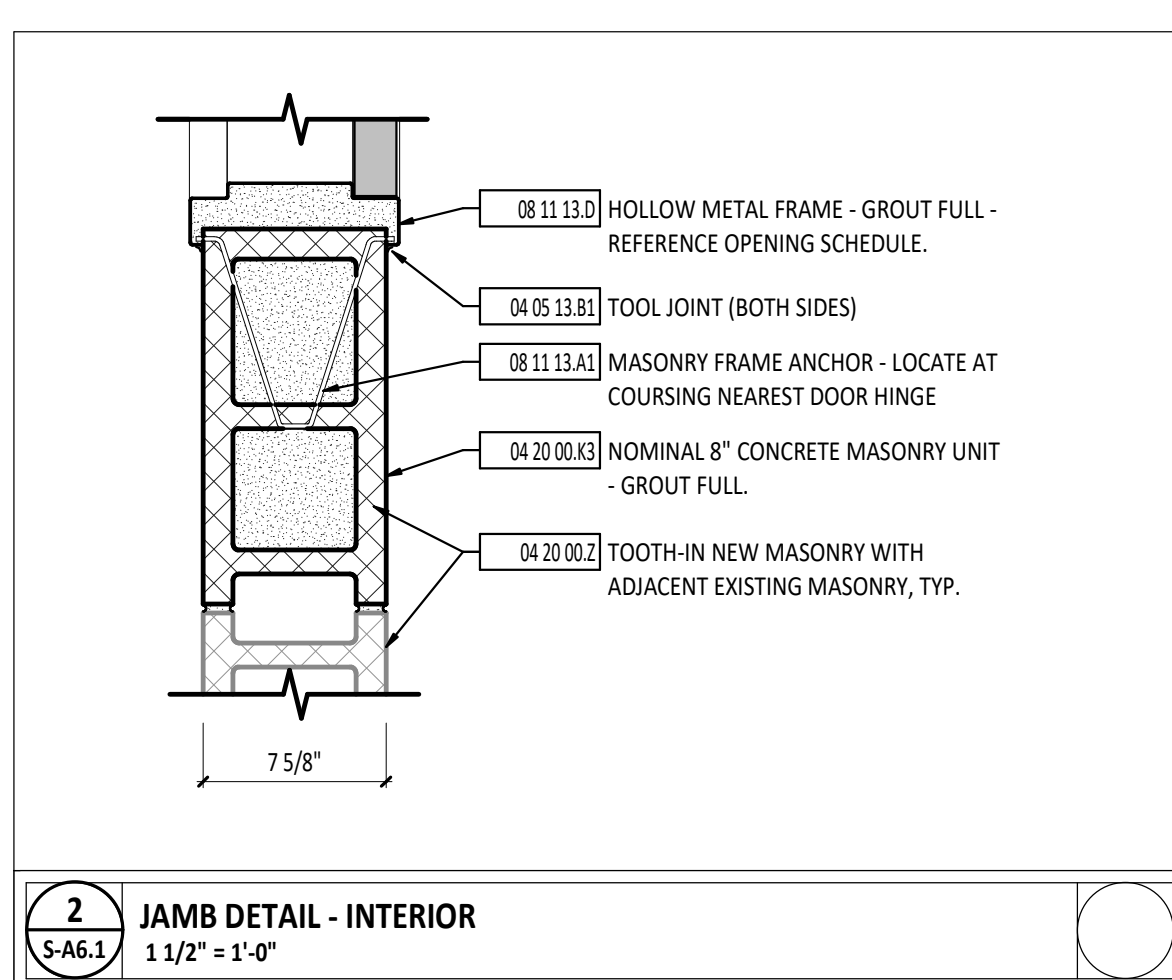


**2 JAMB DETAIL - INTERIOR**  
1 1/2" = 1'-0"

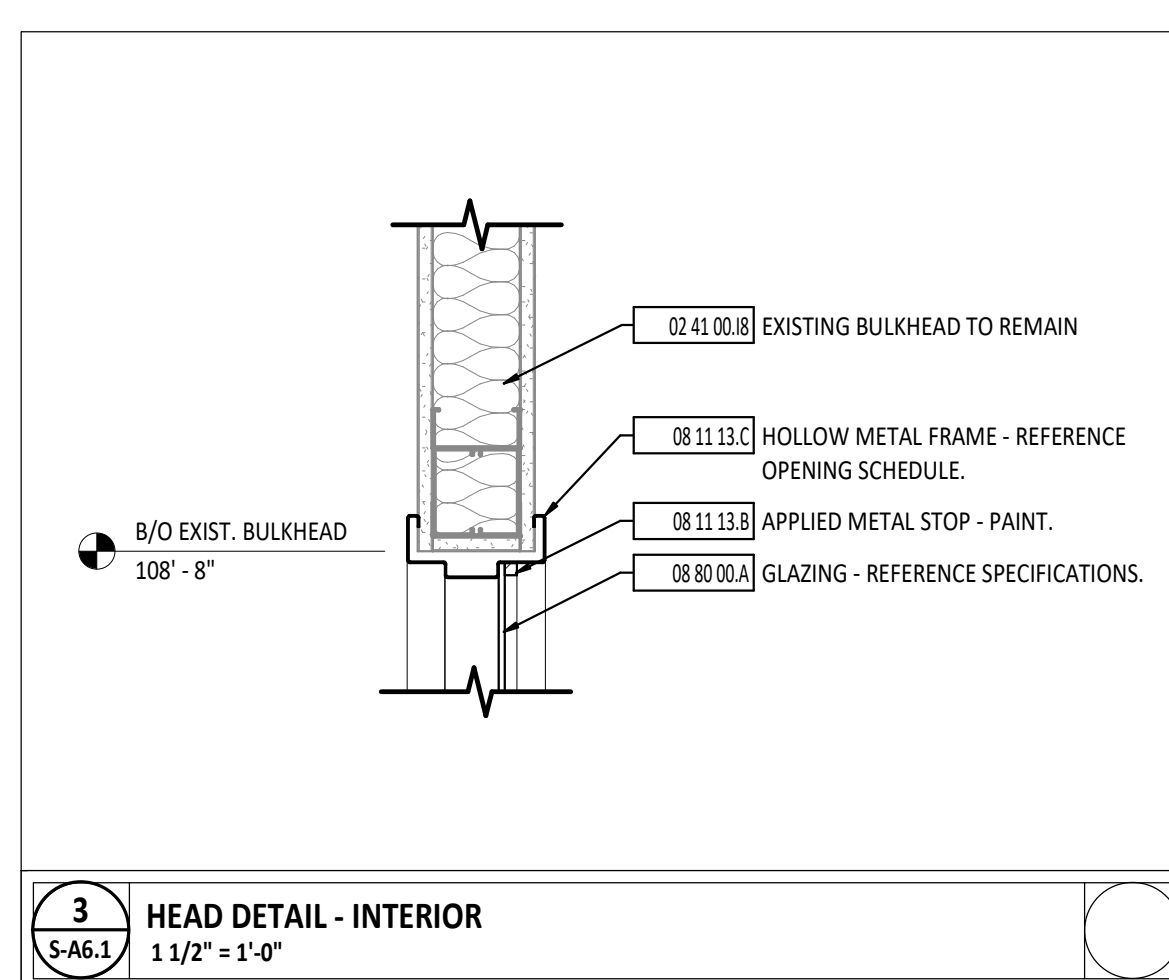


**3 HEAD DETAIL - INTERIOR**  
1 1/2" = 1'-0"

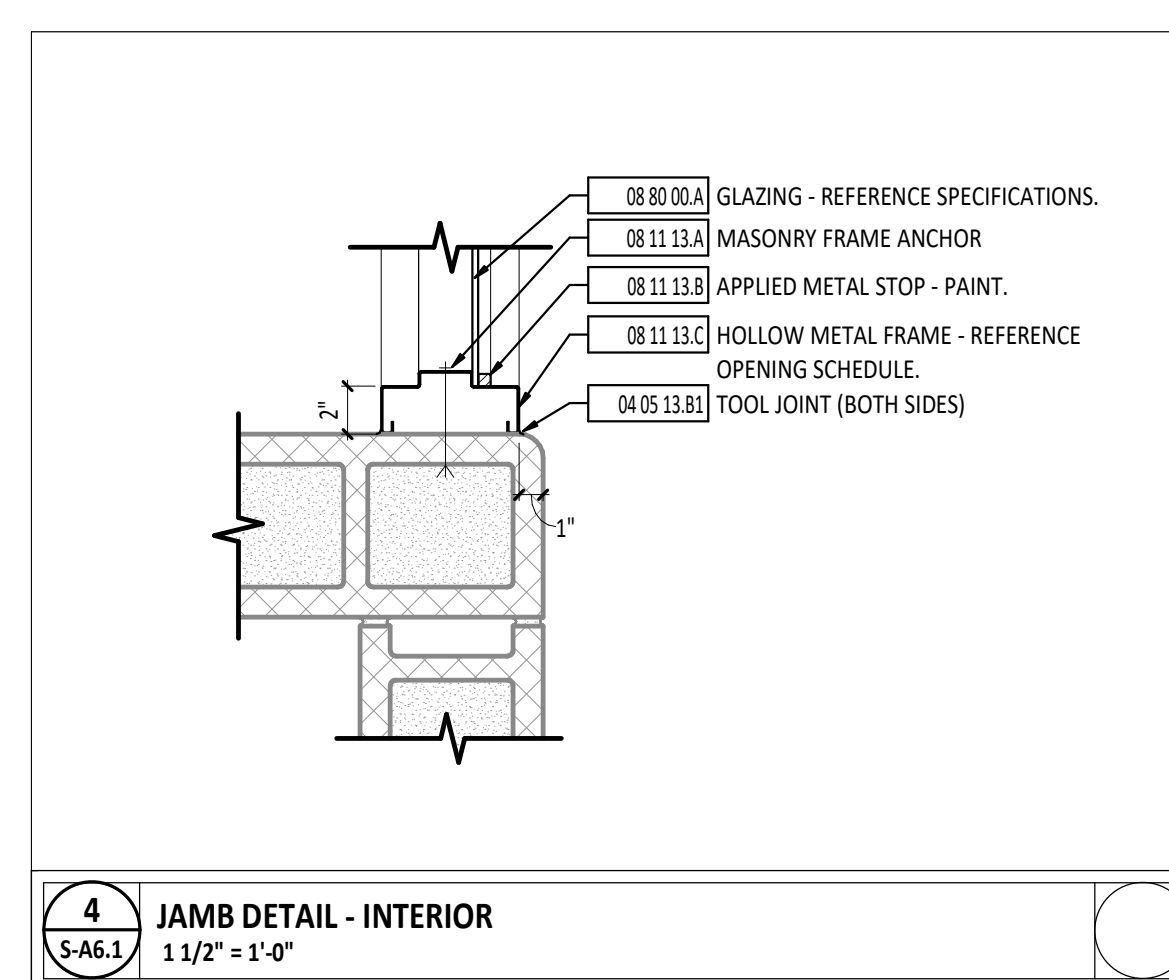


**4 JAMB DETAIL - INTERIOR**  
1 1/2" = 1'-0"

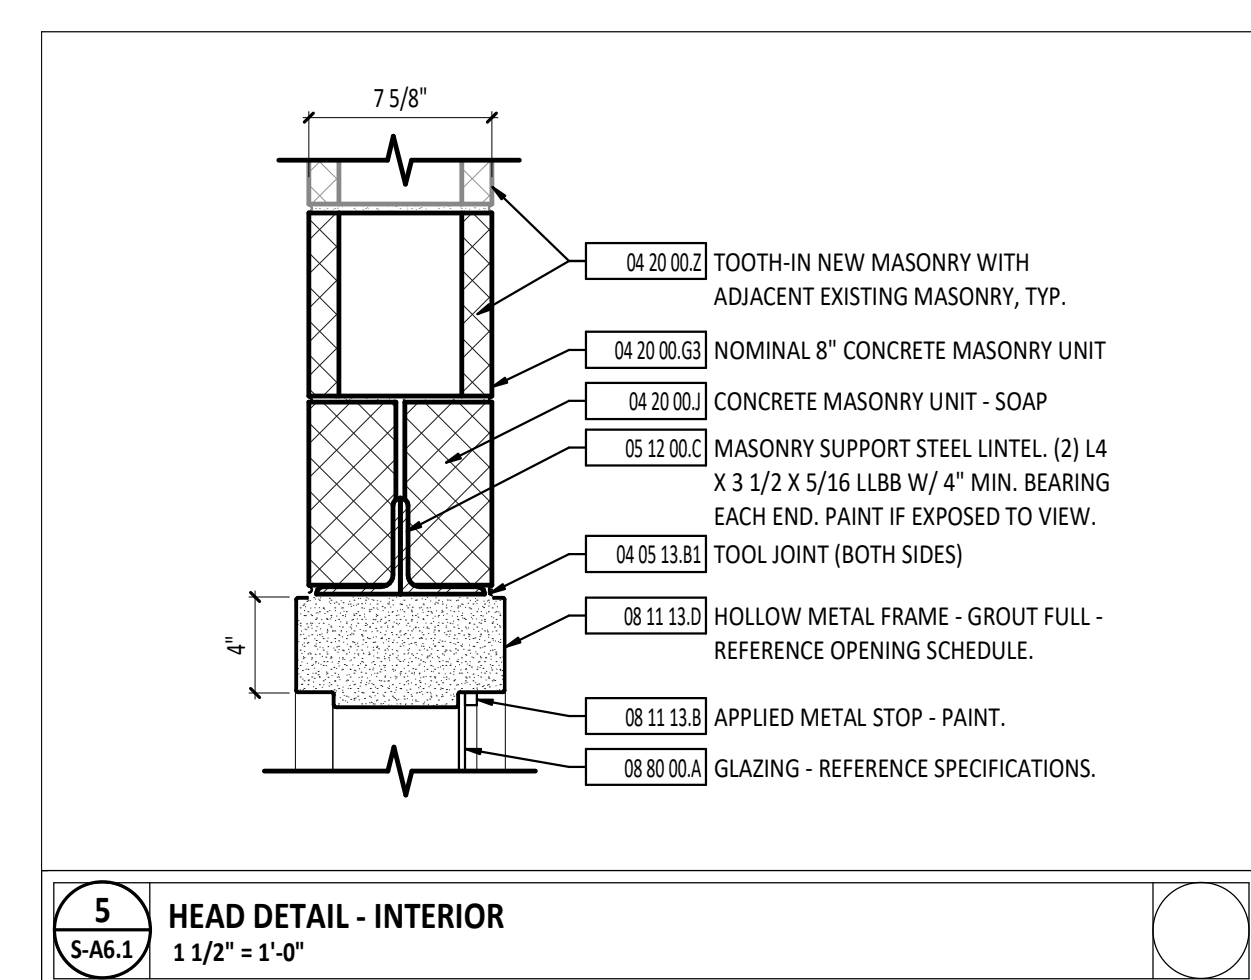


**5 HEAD DETAIL - INTERIOR**  
1 1/2" = 1'-0"

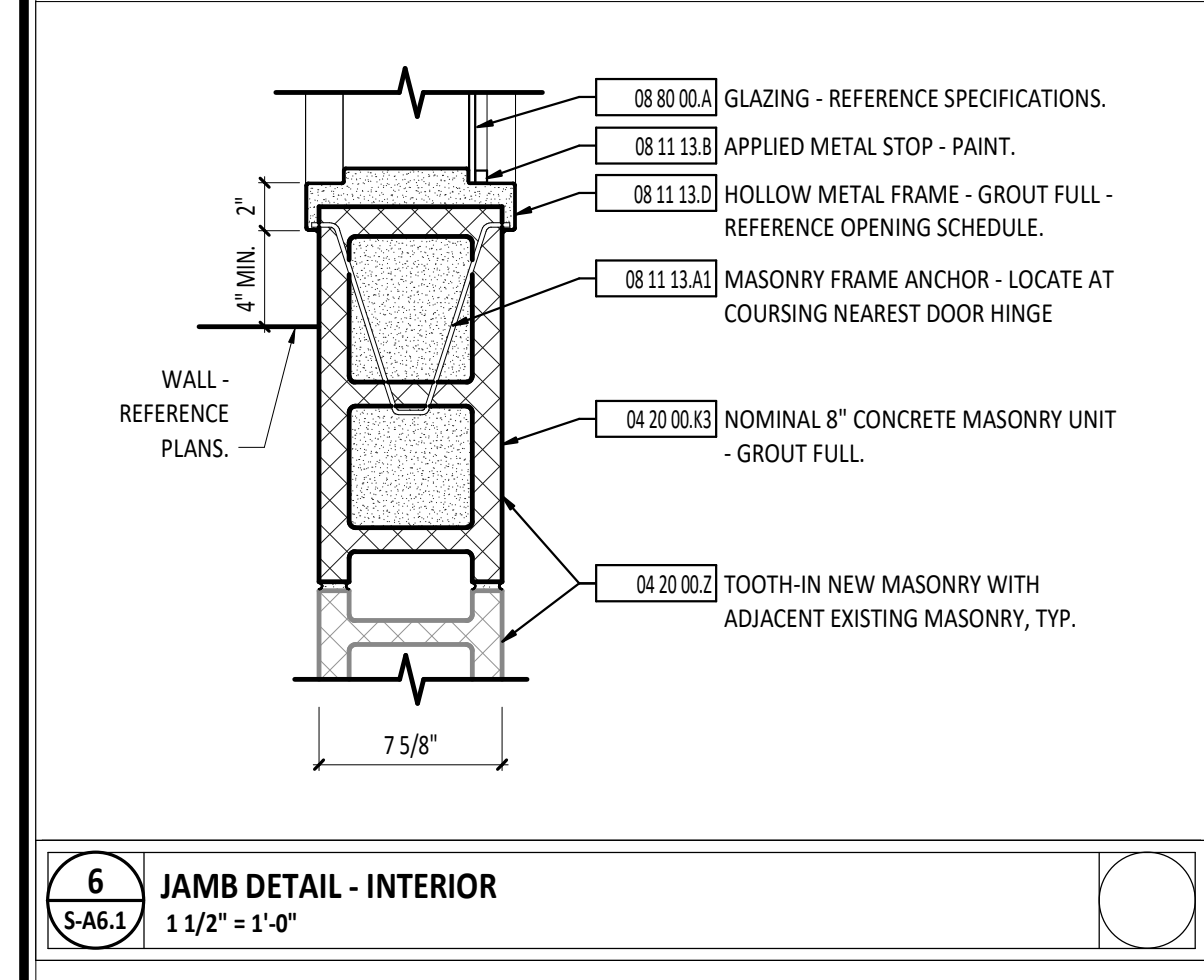


**6 JAMB DETAIL - INTERIOR**  
1 1/2" = 1'-0"

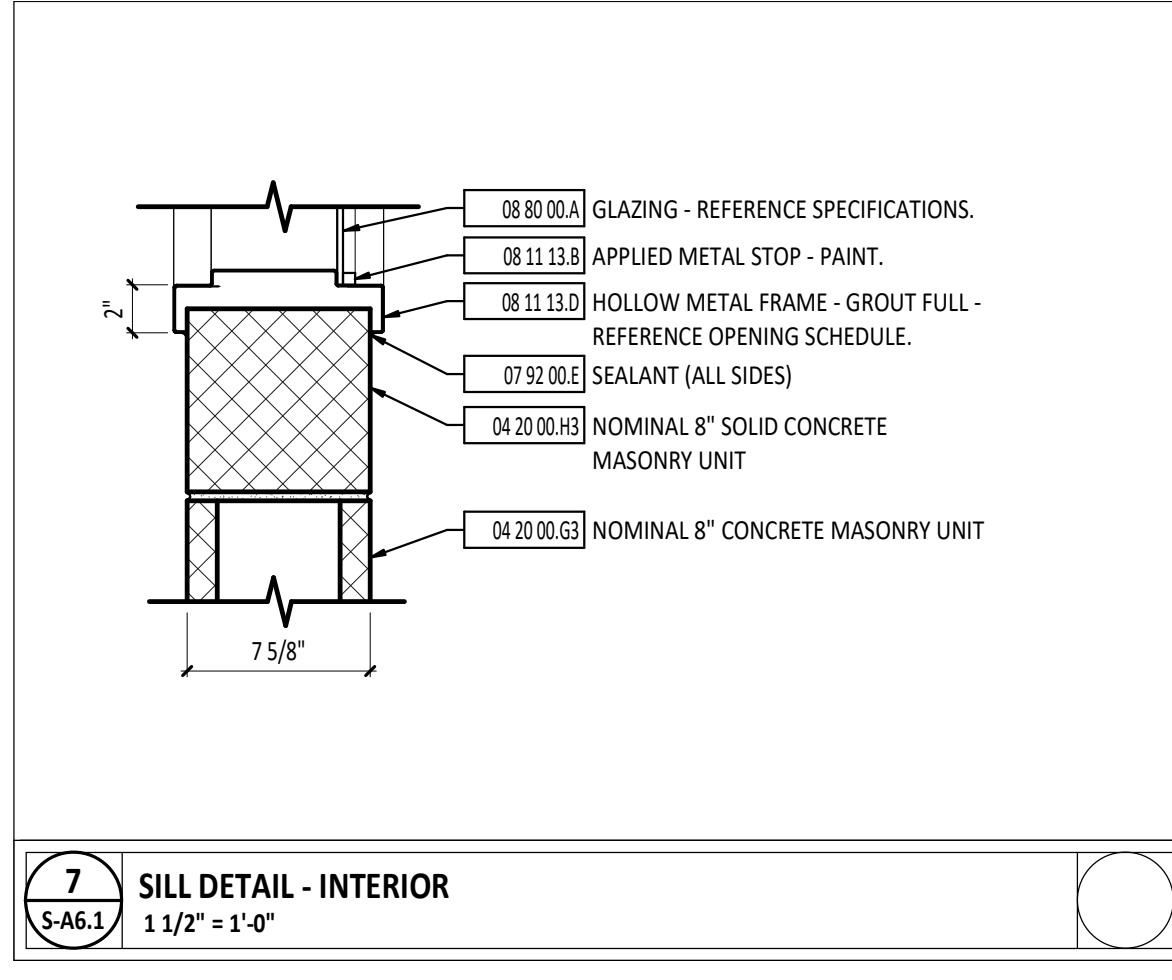

**7 SILL DETAIL - INTERIOR**  
1 1/2" = 1'-0"

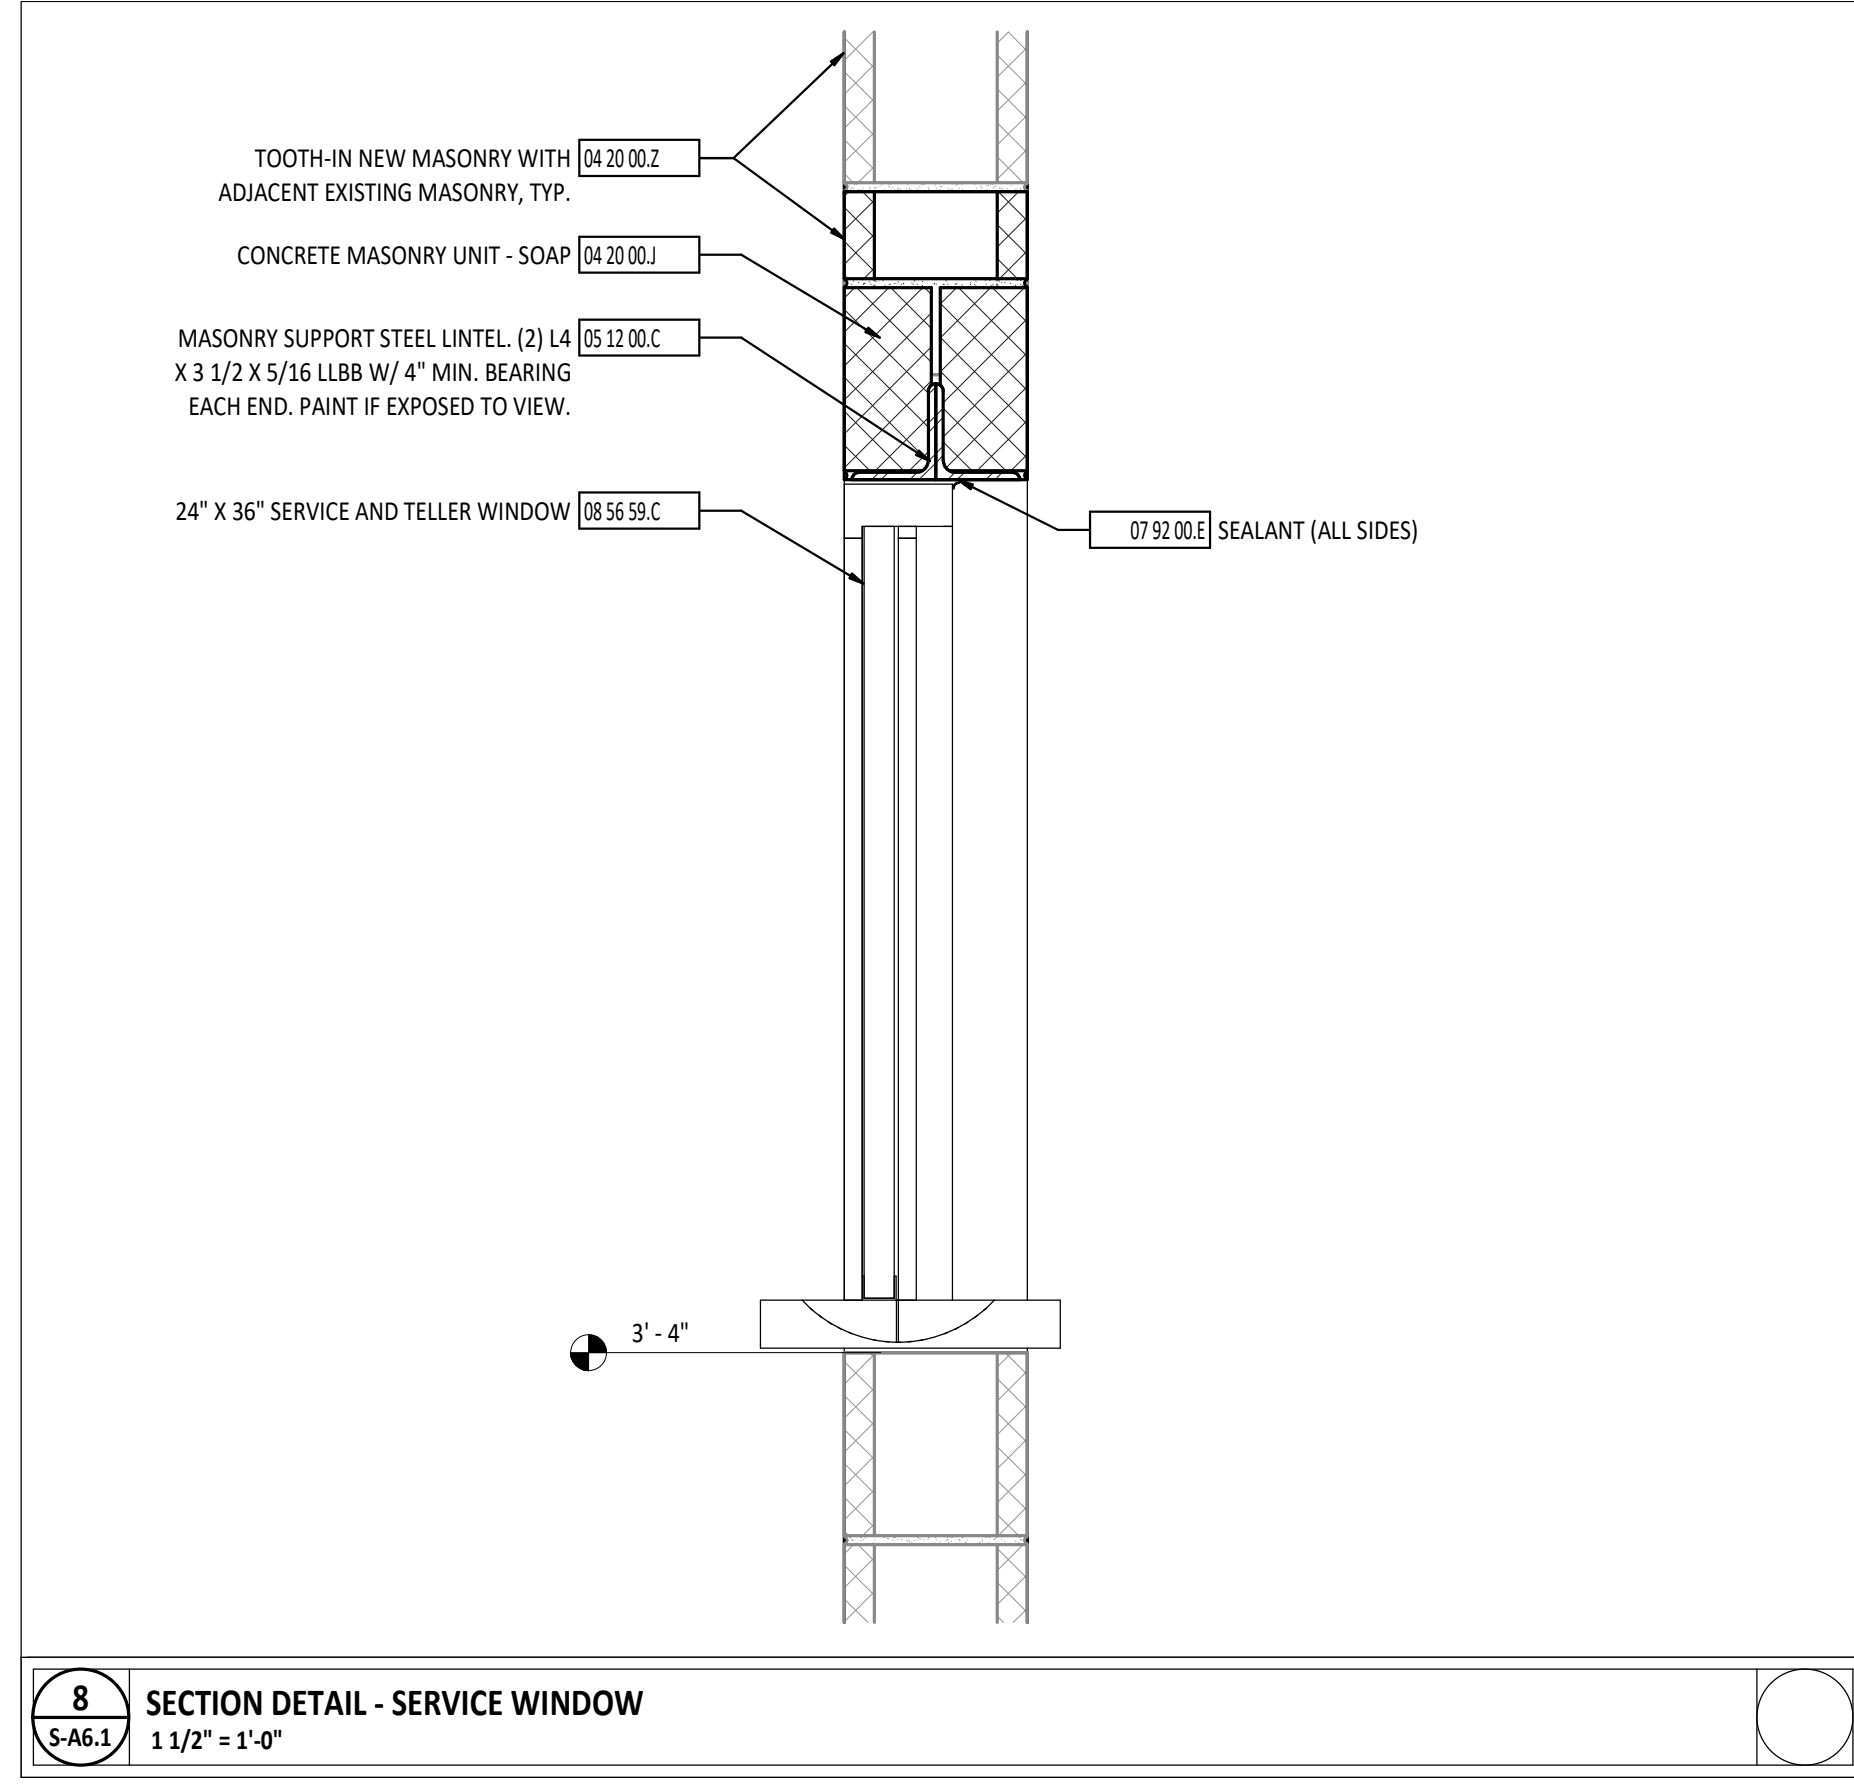

**8 SECTION DETAIL - SERVICE WINDOW**  
1 1/2" = 1'-0"

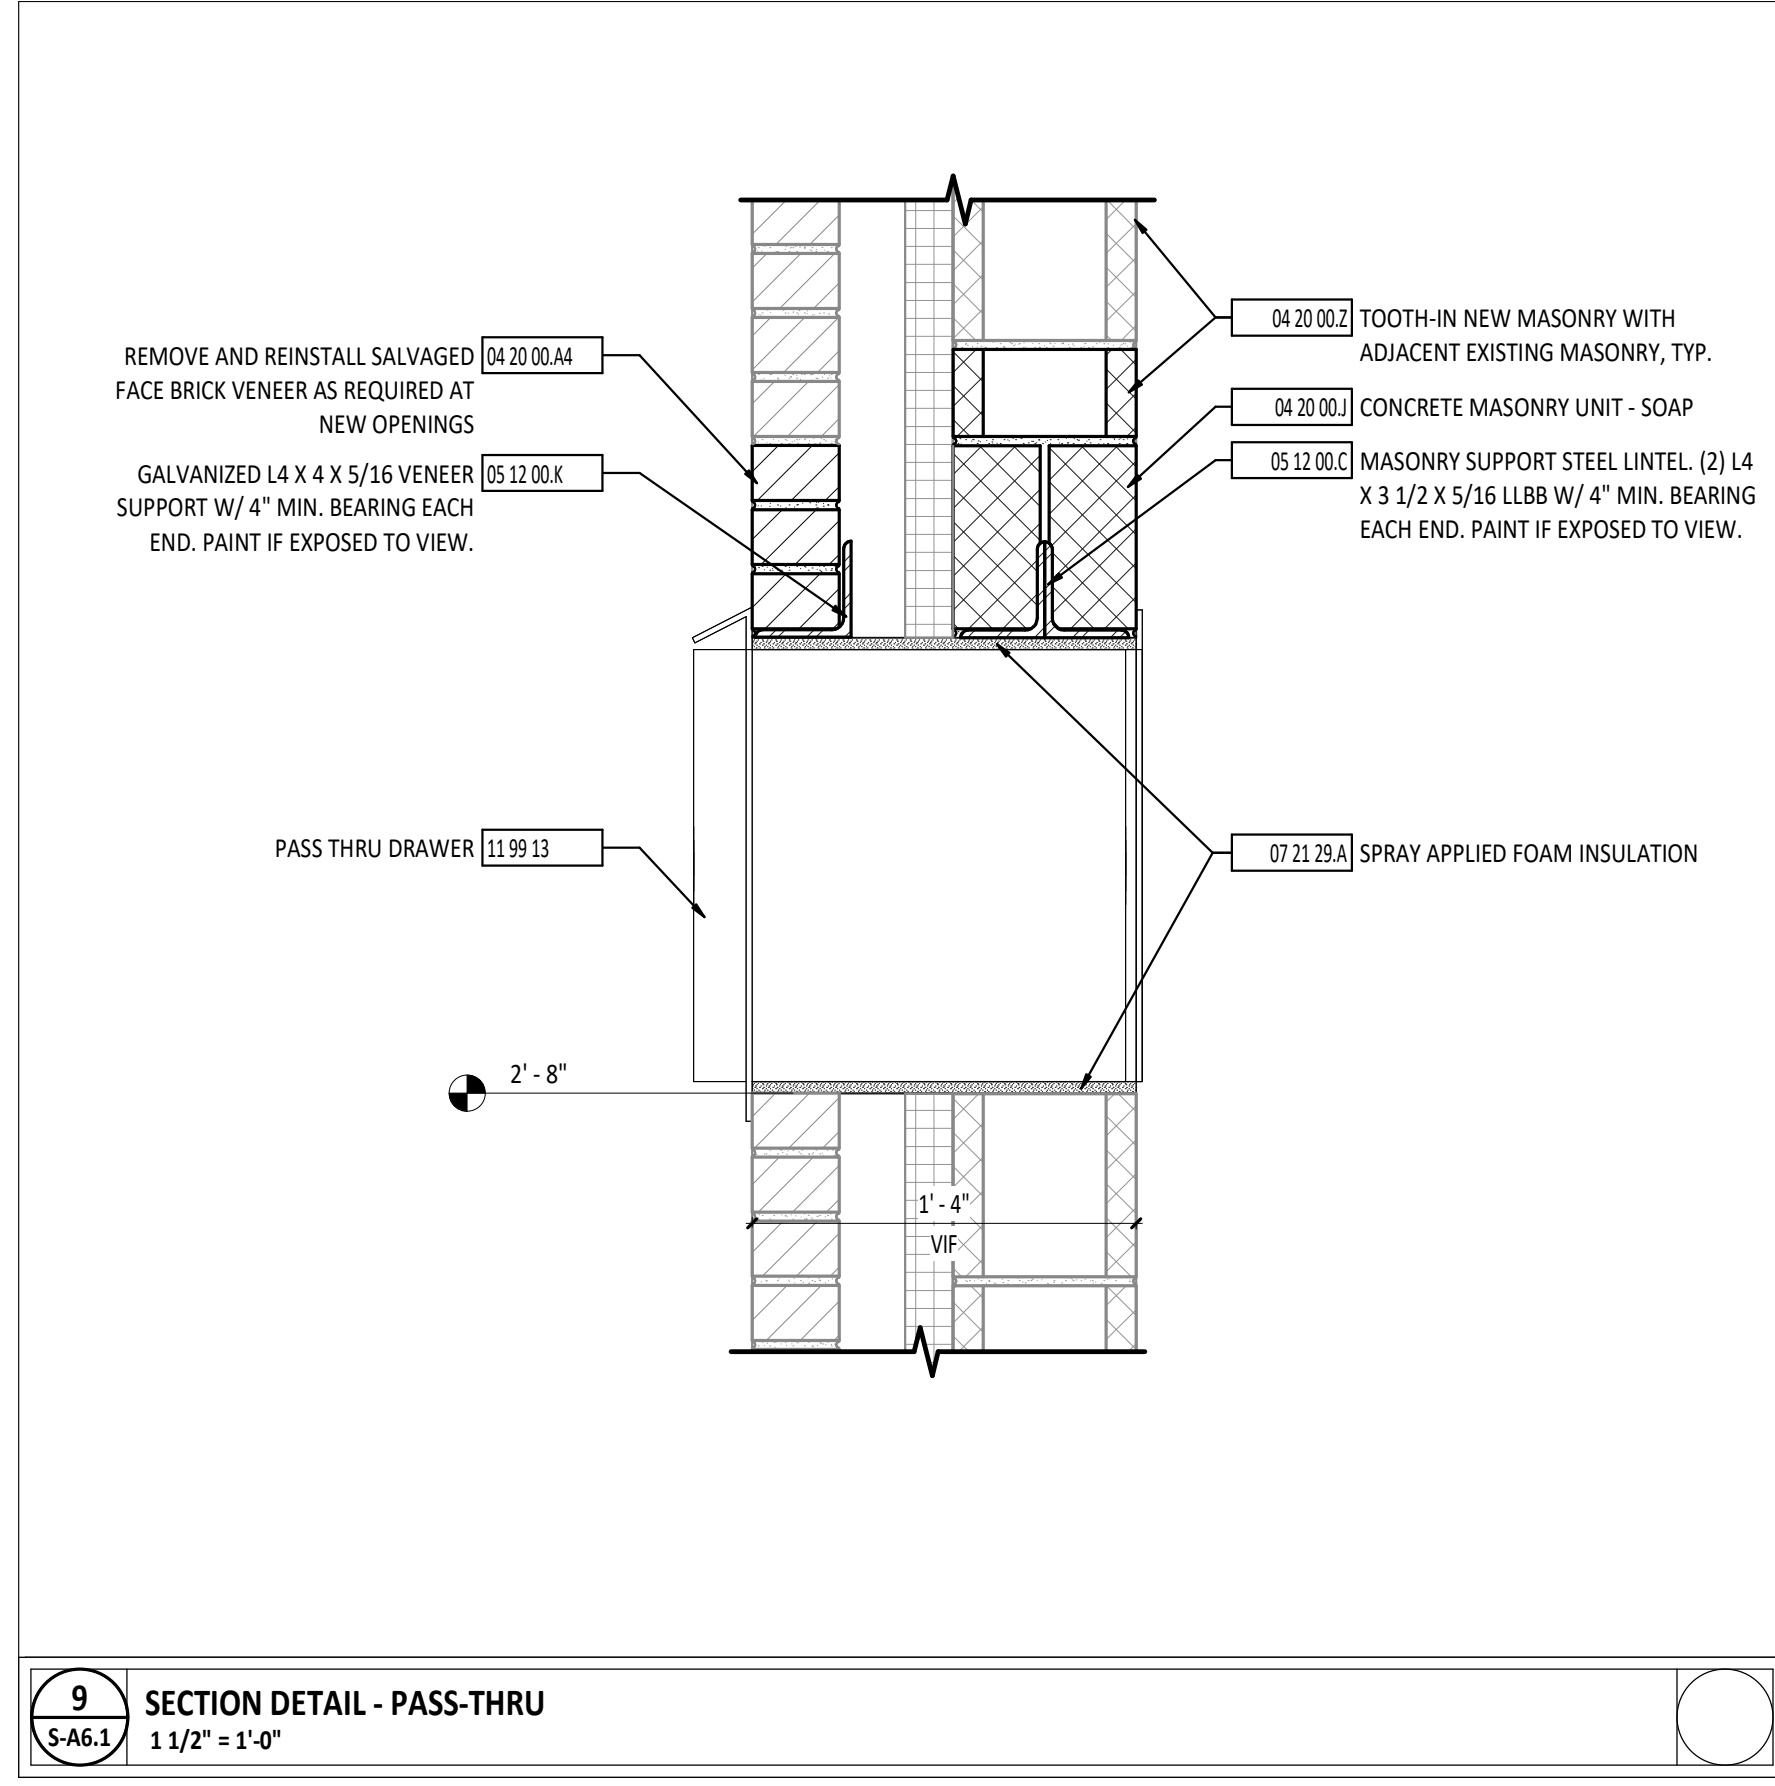

**9 SECTION DETAIL - PASS-THRU**  
1 1/2" = 1'-0"

**JENNINGS COUNTY SCHOOL CORPORATION**  
**SCIPIO**

6326 N. STATE HIGHWAY 7, SCIPIO, INDIANA 47275


ISSUANCES/REVISIONS	
CONSTRUCTION DOCUMENTS	02/26/2025
1 ADDENDUM #02	04/13/2025

PROJECT NUMBER:	DRAWN BY:	CHECKED BY:
26054	SRS	TAL


SHEET TITLE:  
**DOOR SCHEDULE AND DETAILS**

SHEET NUMBER:  
**S-A6.1**


NUMBER	DOOR/OPENING SCHEDULE										HARDWARE SET	ROOM KEY	FUNCTION	LABEL (MIN)	NOTES		
	DOOR					FRAME											
	SIZE	THK	MATL	TYPE	GLASS	DEPTH	MATL	TYPE	GLASS	DETAIL NUMBER							
SC101A	(2) 3'-0" x 7'-0"	1 3/4"	AL	EXIST	EXIST	4 1/2"	AL	EXIST	EXIST	-	-	-	015	EXT	Exterior	-	1
SC101B	(2) 3'-0" x 7'-0"	1 3/4"	AL	EXIST	EXIST	4 1/2"	AL	EXIST	EXIST	-	-	-	044	EXT	Exterior	-	1
SC101C	(2) 3'-0" x 7'-0"	1 3/4"	AL	EXIST	EXIST	4 1/2"	AL	EXIST	EXIST	-	-	-	044	EXT	Exterior	-	1
SC101D	(2) 3'-0" x 7'-0"	1 3/4"	AL	EXIST	EXIST	4 1/2"	AL	EXIST	EXIST	-	-	-	042	INT	Interior	-	1
SC101E	(2) 3'-0" x 7'-0"	1 3/4"	AL	EXIST	EXIST	4 1/2"	AL	EXIST	EXIST	-	-	-	042	INT	Interior	-	1
SC101F	(2) 3'-0" x 7'-0"	1 3/4"	AL	EXIST	EXIST	4 1/2"	AL	EXIST	EXIST	-	-	-	041	INT	Interior	-	1
SC102A	(2) 3'-0" x 7'-0"	1 3/4"	HM	FG2	SG1	8 1/4"	HM	2	-	1/A6.1	2/A6.1	-	043	INT	Interior	-	-
SC102B	(2) 3'-0" x 7'-0"	1 3/4"	HM	FG2	SG1	8 1/4"	HM	2	-	1/A6.1	2/A6.1	-	043	INT	Interior	-	-
SC103	3'-0" x 7'-0"	1 3/4"	WD	NL	G1	8 1/4"	HM	1	-	1/A6.1	2/A6.1	-	047	INT	Interior	-	-
SC103A	3'-0" x 7'-10"	1 3/4"	AL	EXIST	EXIST	4 1/2"	AL	EXST	EXIST	-	-	-	045	INT	Interior	-	1
SC103B	3'-0" x 7'-10"	1 3/4"	AL	EXIST	EXIST	4 1/2"	AL	EXST	EXIST	-	-	-	045	INT	Interior	-	1
SC104	(2) 3'-0" x 7'-0"	1 3/4"	AL	EXIST	EXIST	4 1/2"	AL	EXIST	EXIST	-	-	-	051	INT	Interior	-	-
SC105	(2) 3'-0" x 7'-0"	1 3/4"	AL	EXIST	EXIST	4 1/2"	AL	EXIST	EXIST	-	-	-	051	INT	Interior	-	-
SC106	3'-0" x 7'-0"	1 3/4"	WD	NL	G1	8 1/4"	HM	1	-	1/A6.1	2/A6.1	-	047	INT	Interior	-	-
SC107	3'-0" x 7'-0"	1 3/4"	WD	NL	G1	8 1/4"	HM	1	-	1/A6.1	2/A6.1	-	037	INT	Interior	-	-

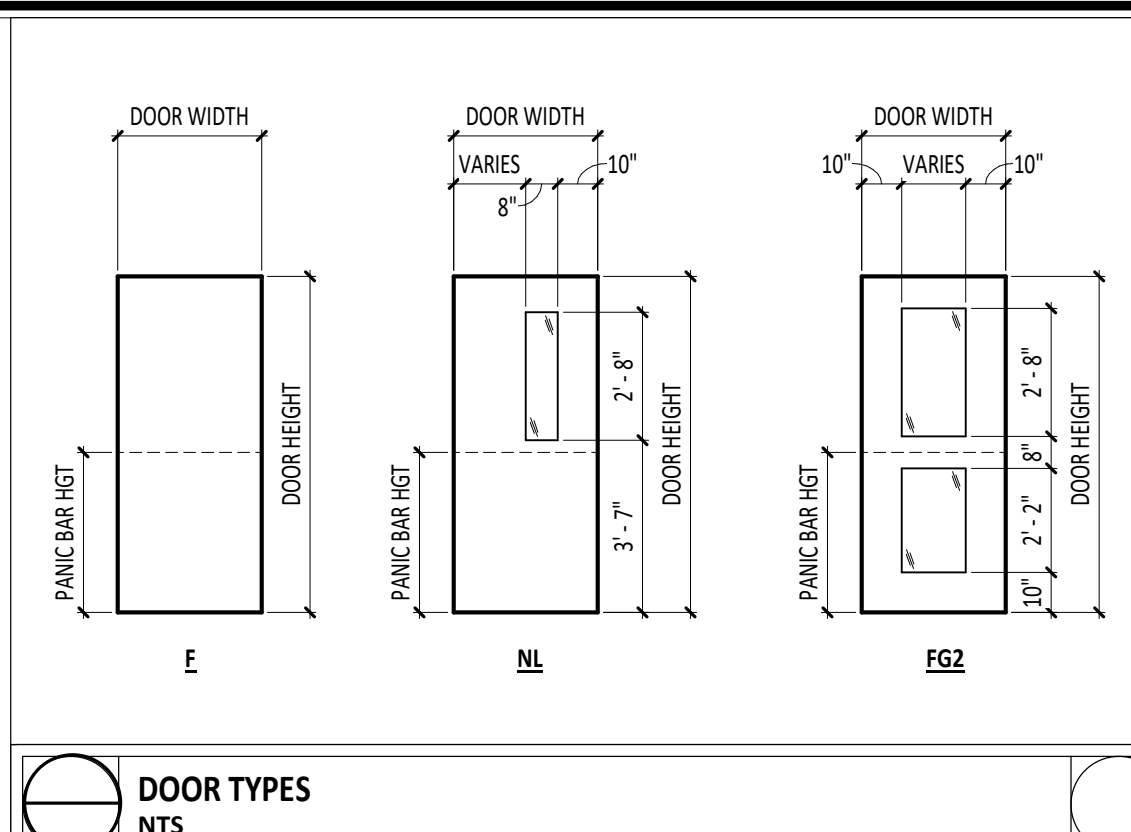


**DOOR TYPES**  
NTS

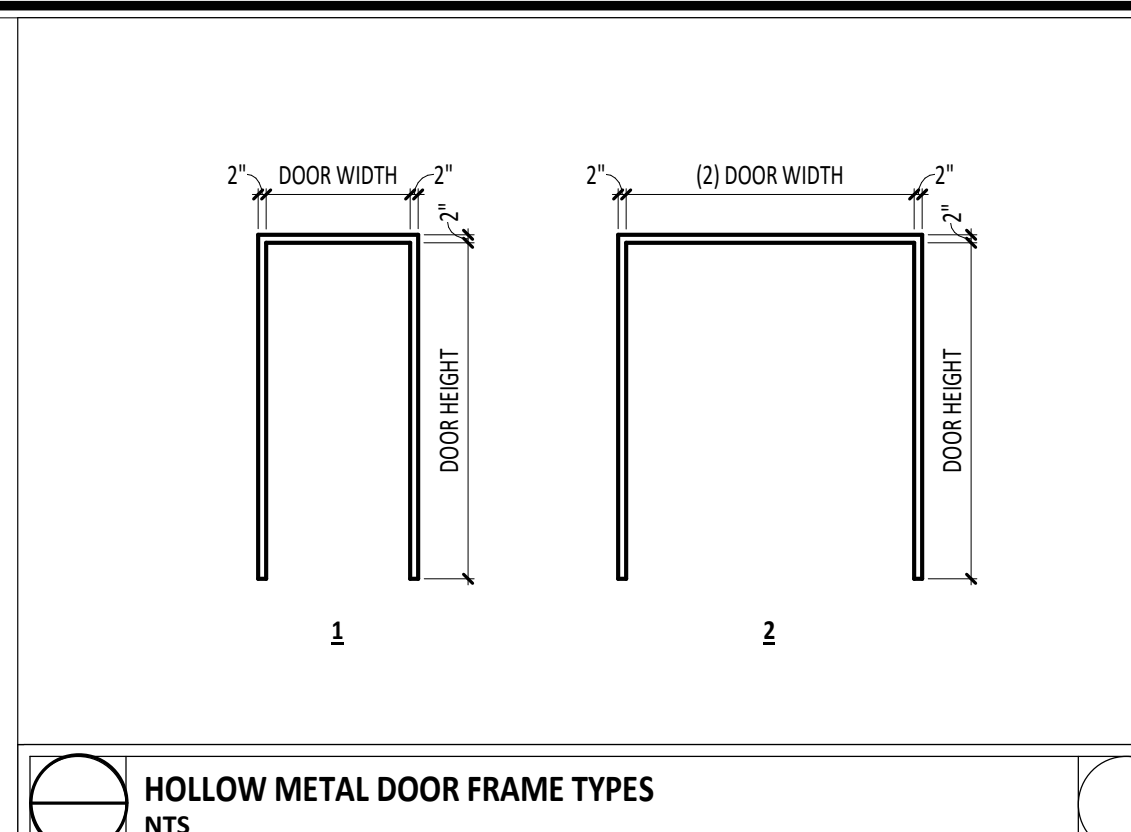


**HOLLOW METAL DOOR FRAME TYPES**  
NTS

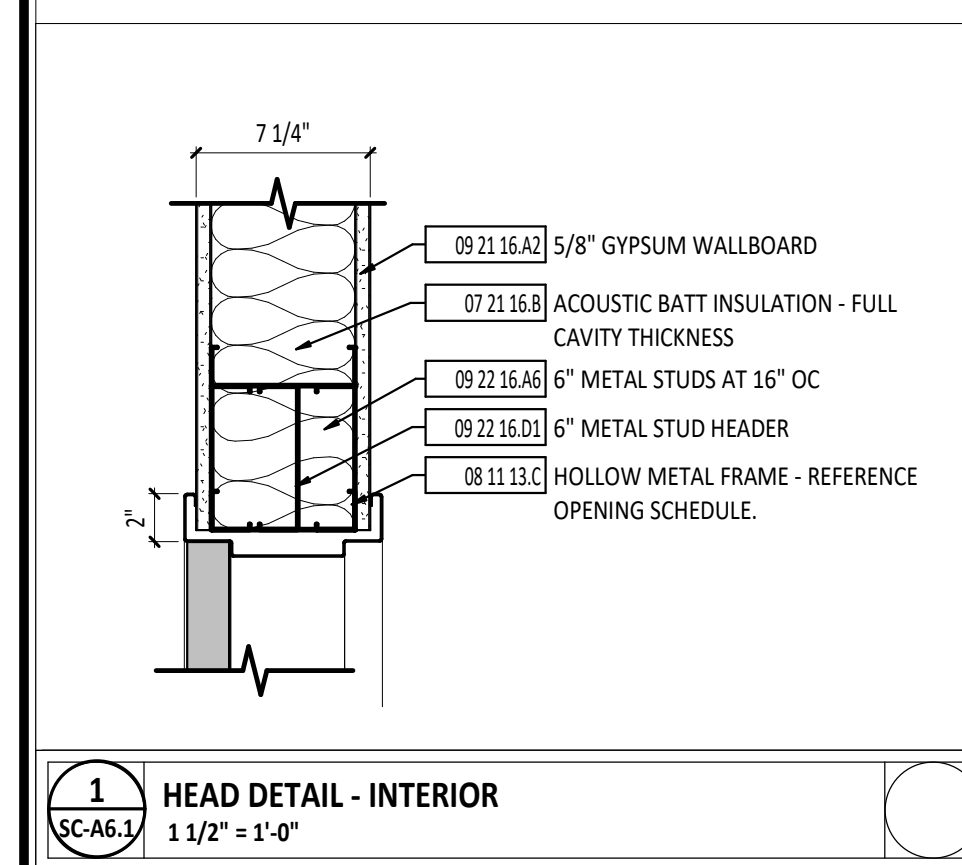


**1 HEAD DETAIL - INTERIOR**  
1 1/2" x 1'-0"

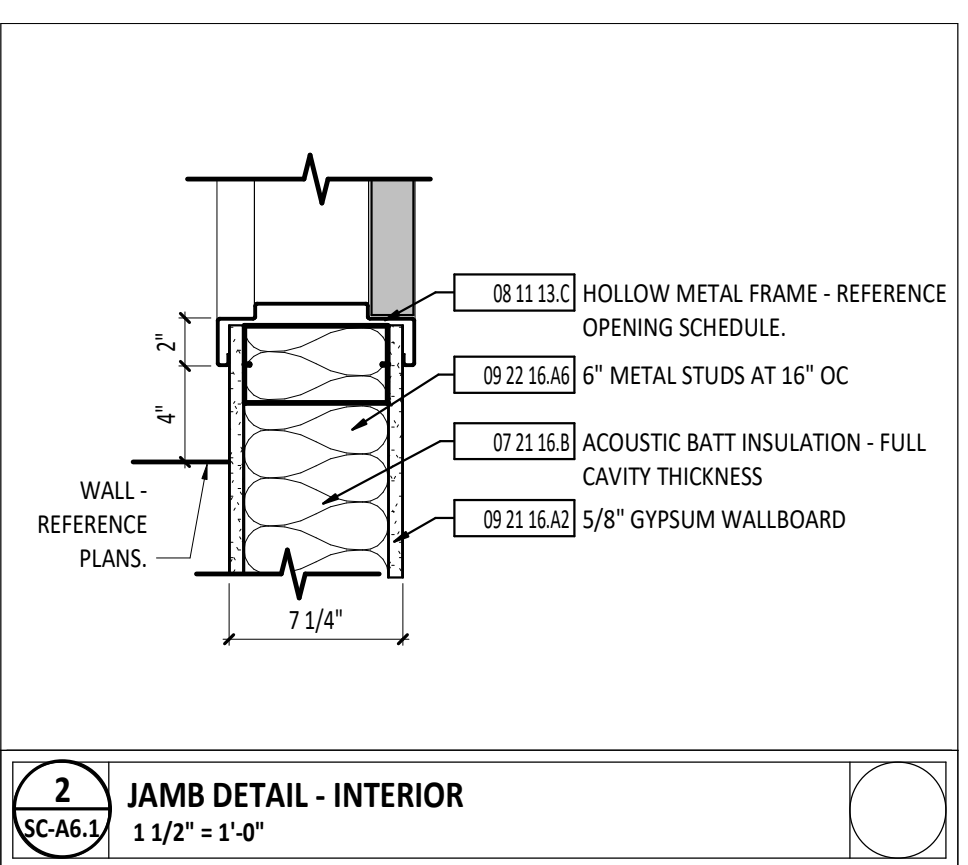

**2 JAMB DETAIL - INTERIOR**  
1 1/2" x 1'-0"

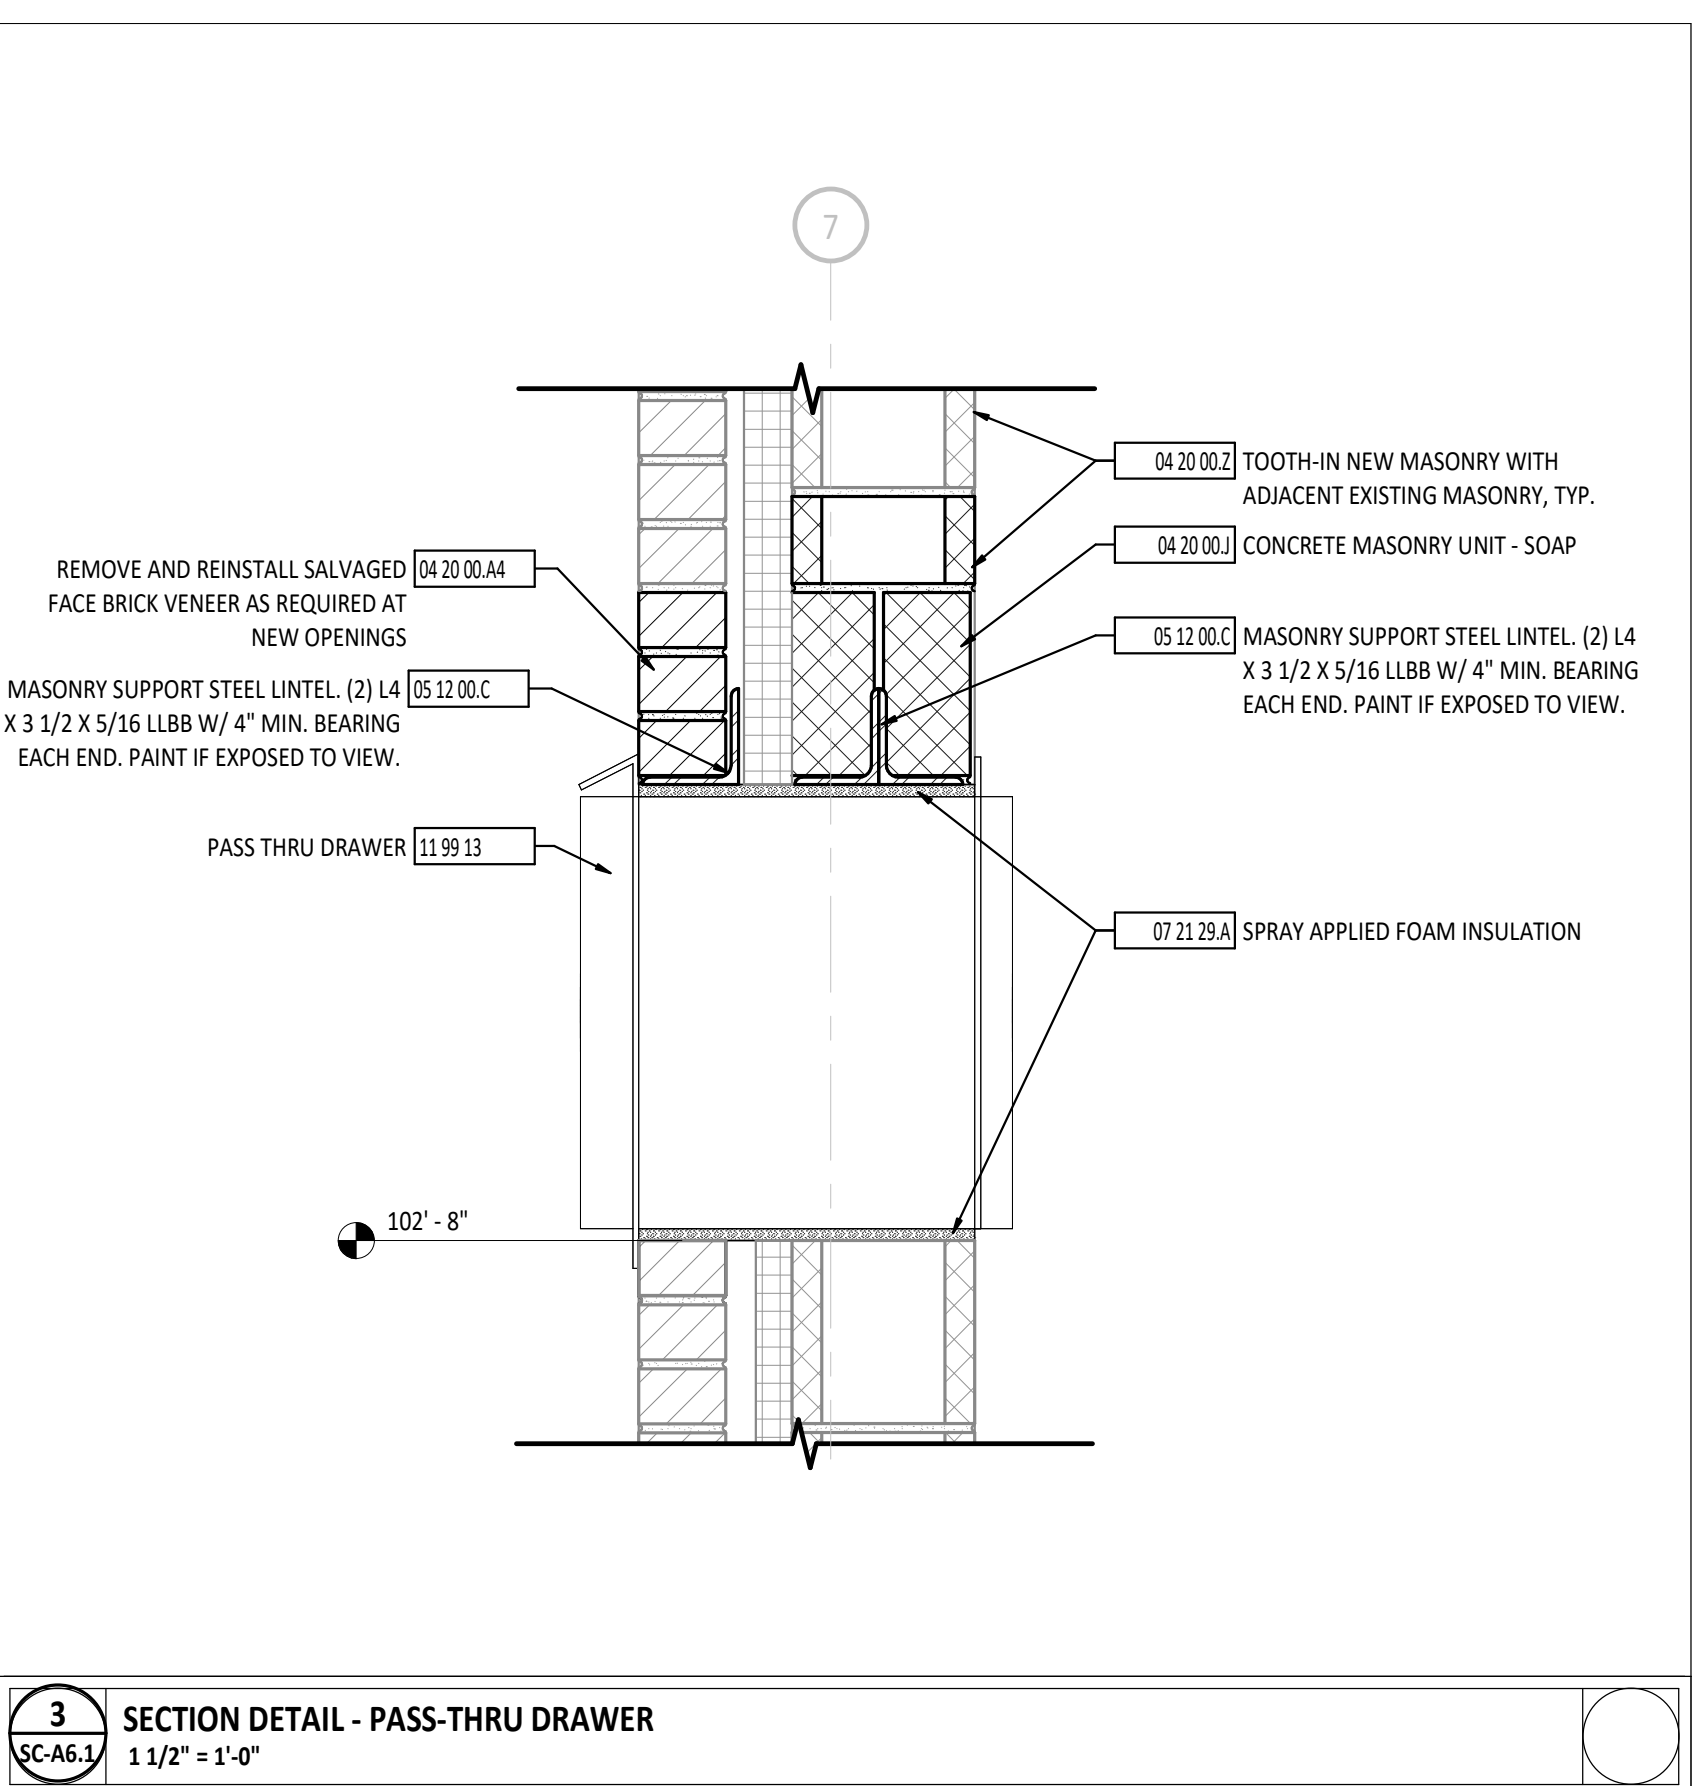

**3 SECTION DETAIL - PASS-THRU DRAWER**  
1 1/2" x 1'-0"

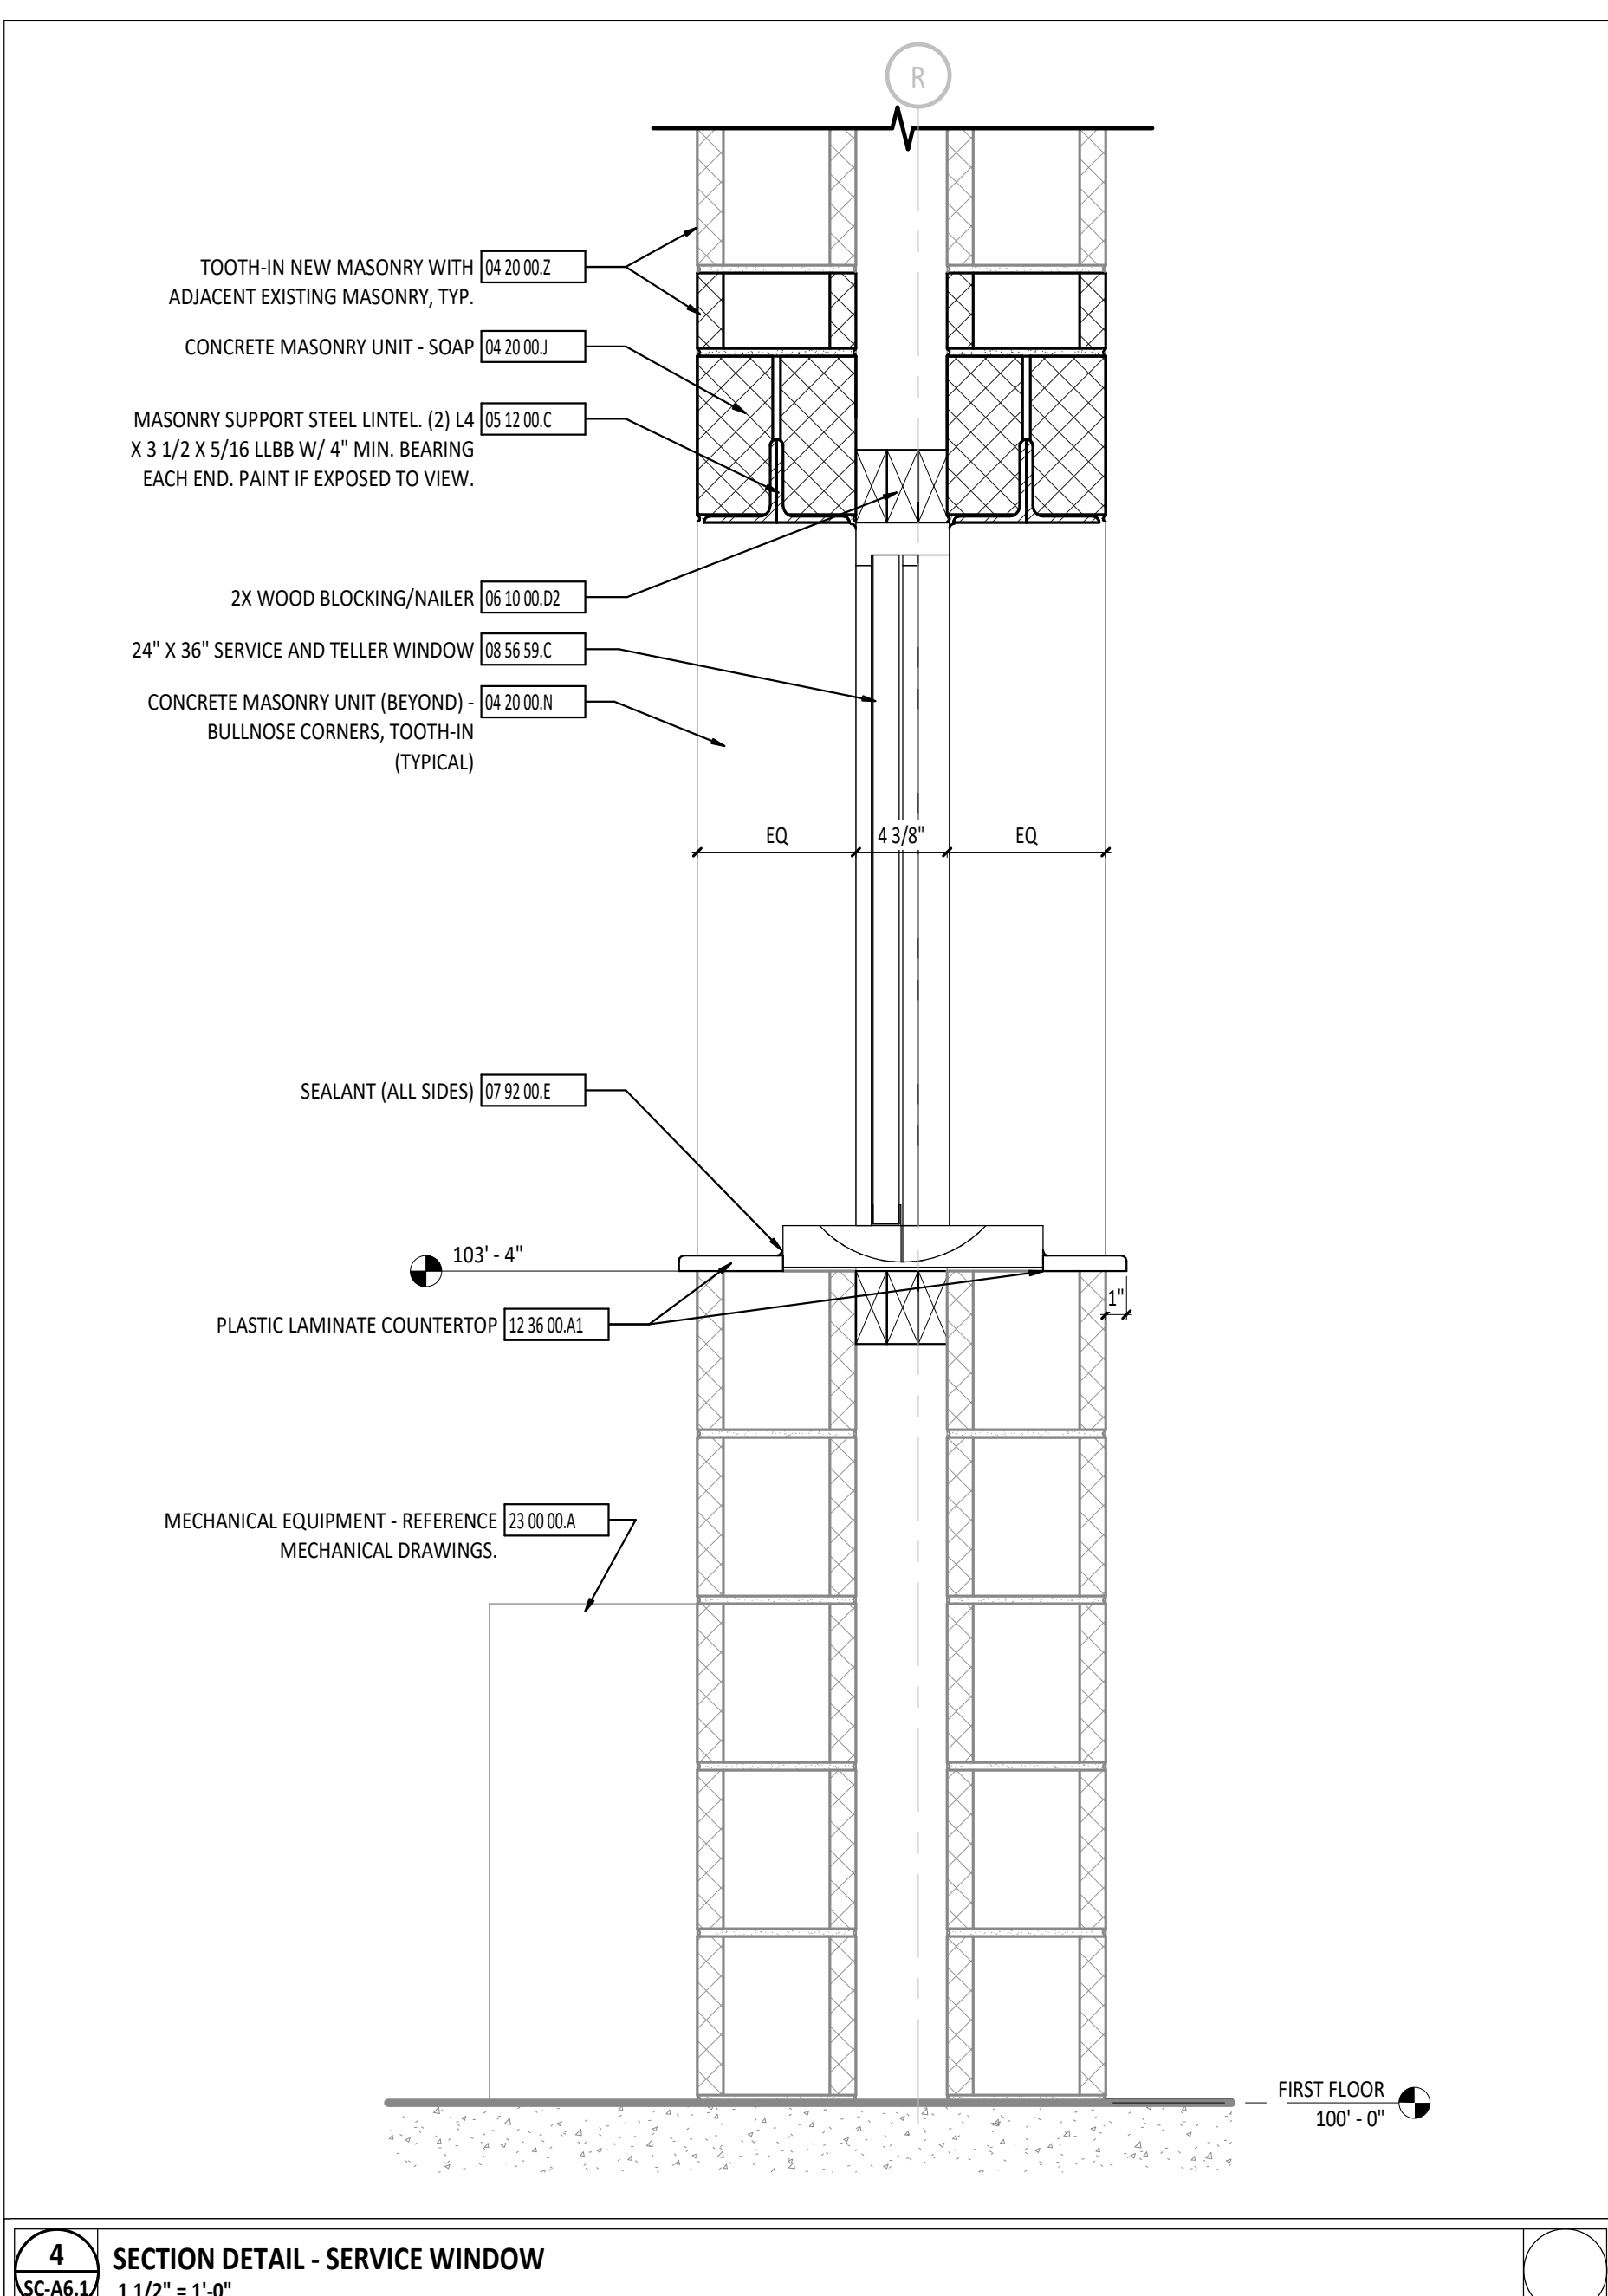

**4 SECTION DETAIL - SERVICE WINDOW**  
1 1/2" x 1'-0"

**DOOR GENERAL NOTES**

B REFERENCE SPECIFICATION SECTION 08 71 00 FOR HARDWARE SETS.

**DOOR/OPENING SCHEDULE ABBREVIATIONS**

**SYMBOL DESCRIPTION**


AL ALUMINUM  
F FLUSH  
FG FULL GLASS  
HG HALF GLASS  
HM HOLLOW METAL  
NL NARROW LITE  
WD WOOD

**DOOR/OPENING SCHEDULE NOTES**

1. EXISTING DOOR TO REMAIN. MODIFY DOOR AS REQUIRED TO RECEIVE NEW SCHEDULED HARDWARE.

**GLAZING TYPES**

G1 - 1/4" TEMPERED GLAZING  
SG1 - SECURITY GLAZING  
FG1 - 1 HOUR FIRE RATED GLAZING  
FG2 - 1 HOUR FIRE RATED SECURITY GLAZING

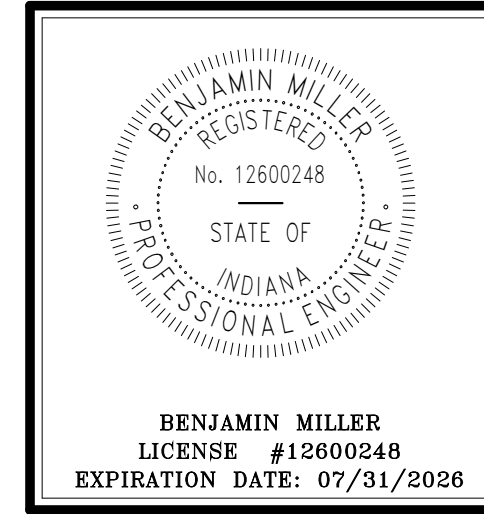

**JENNINGS COUNTY SCHOOL CORPORATIONS**  
**SAND CREEK**


1450 N. COUNTY ROAD 050 N. NORTH VERNON, INDIANA 47258

ISSUANCES/REVISIONS		
CONSTRUCTION DOCUMENTS	03/26/2026	
1 ADDENDUM #02	04/13/2026	


PROJECT NUMBER:	DRAWN BY:	CHECKED BY:
25064	SRS	TAL

SHEET TITLE:  
**DOOR SCHEDULE AND DETAILS**

SHEET NUMBER:  
**SC-A6.1**

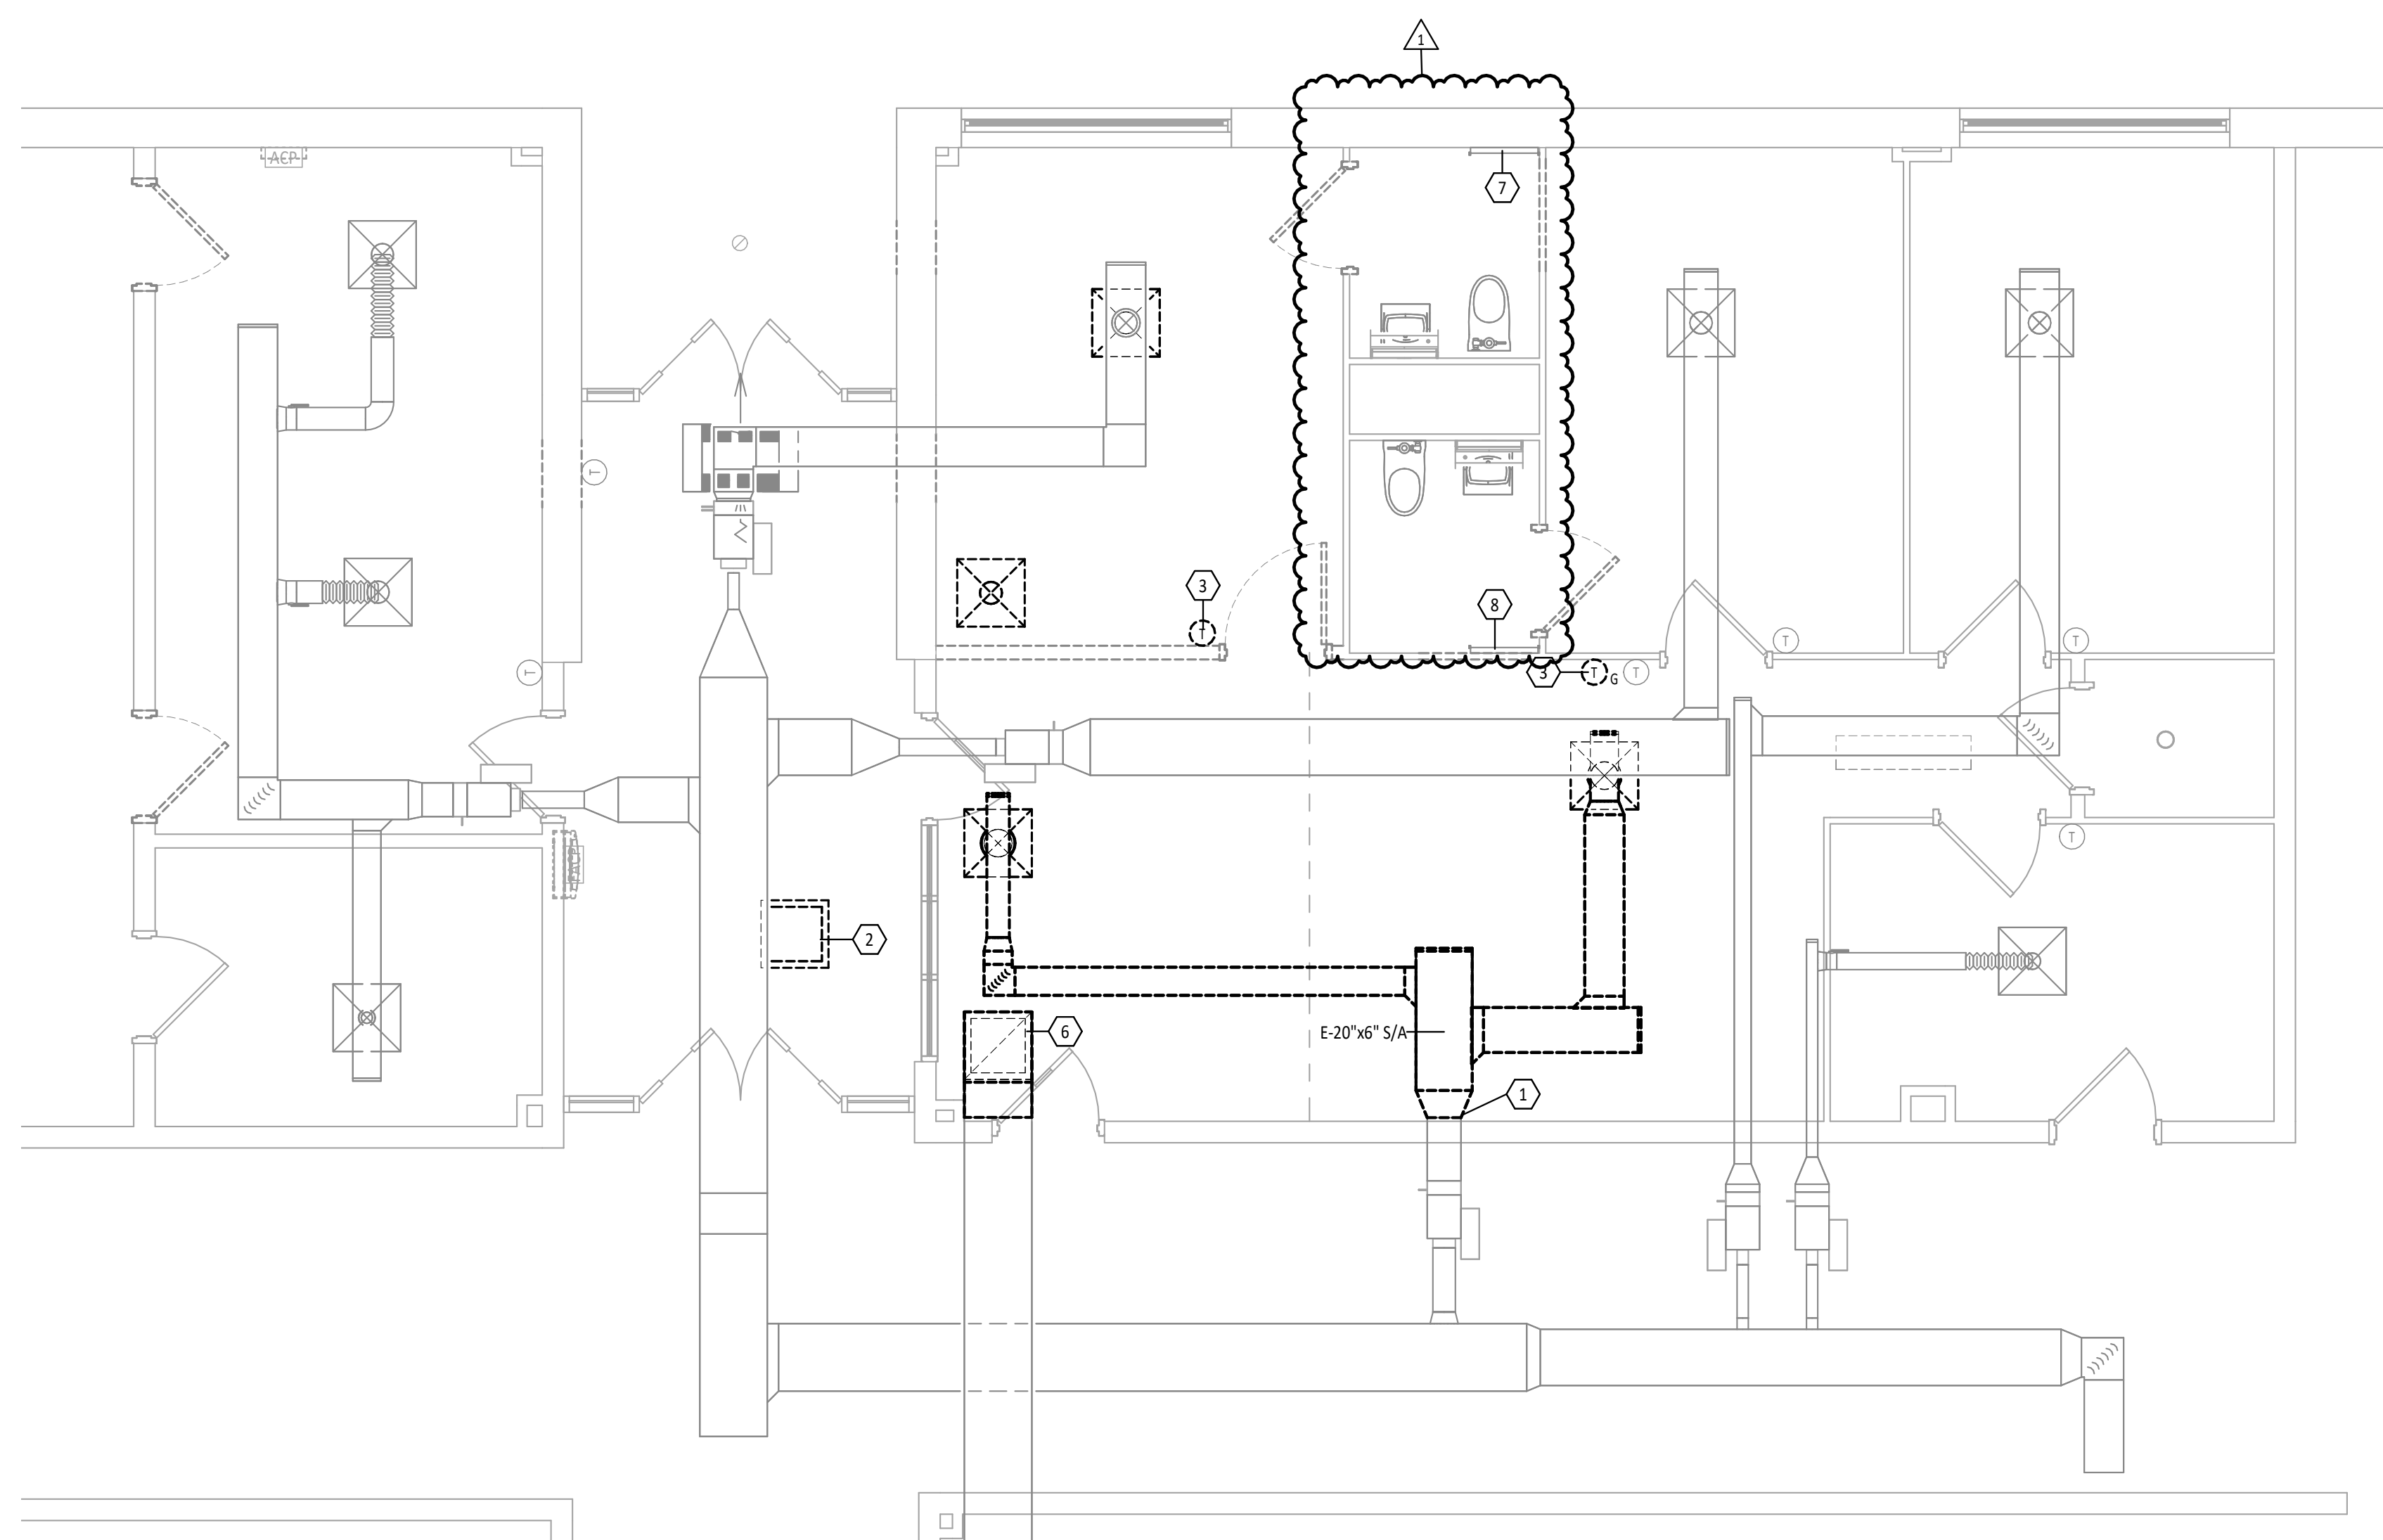

**1** FIRST FLOOR MECHANICAL DEMOLITION PLAN  
1/4" = 1'-0"

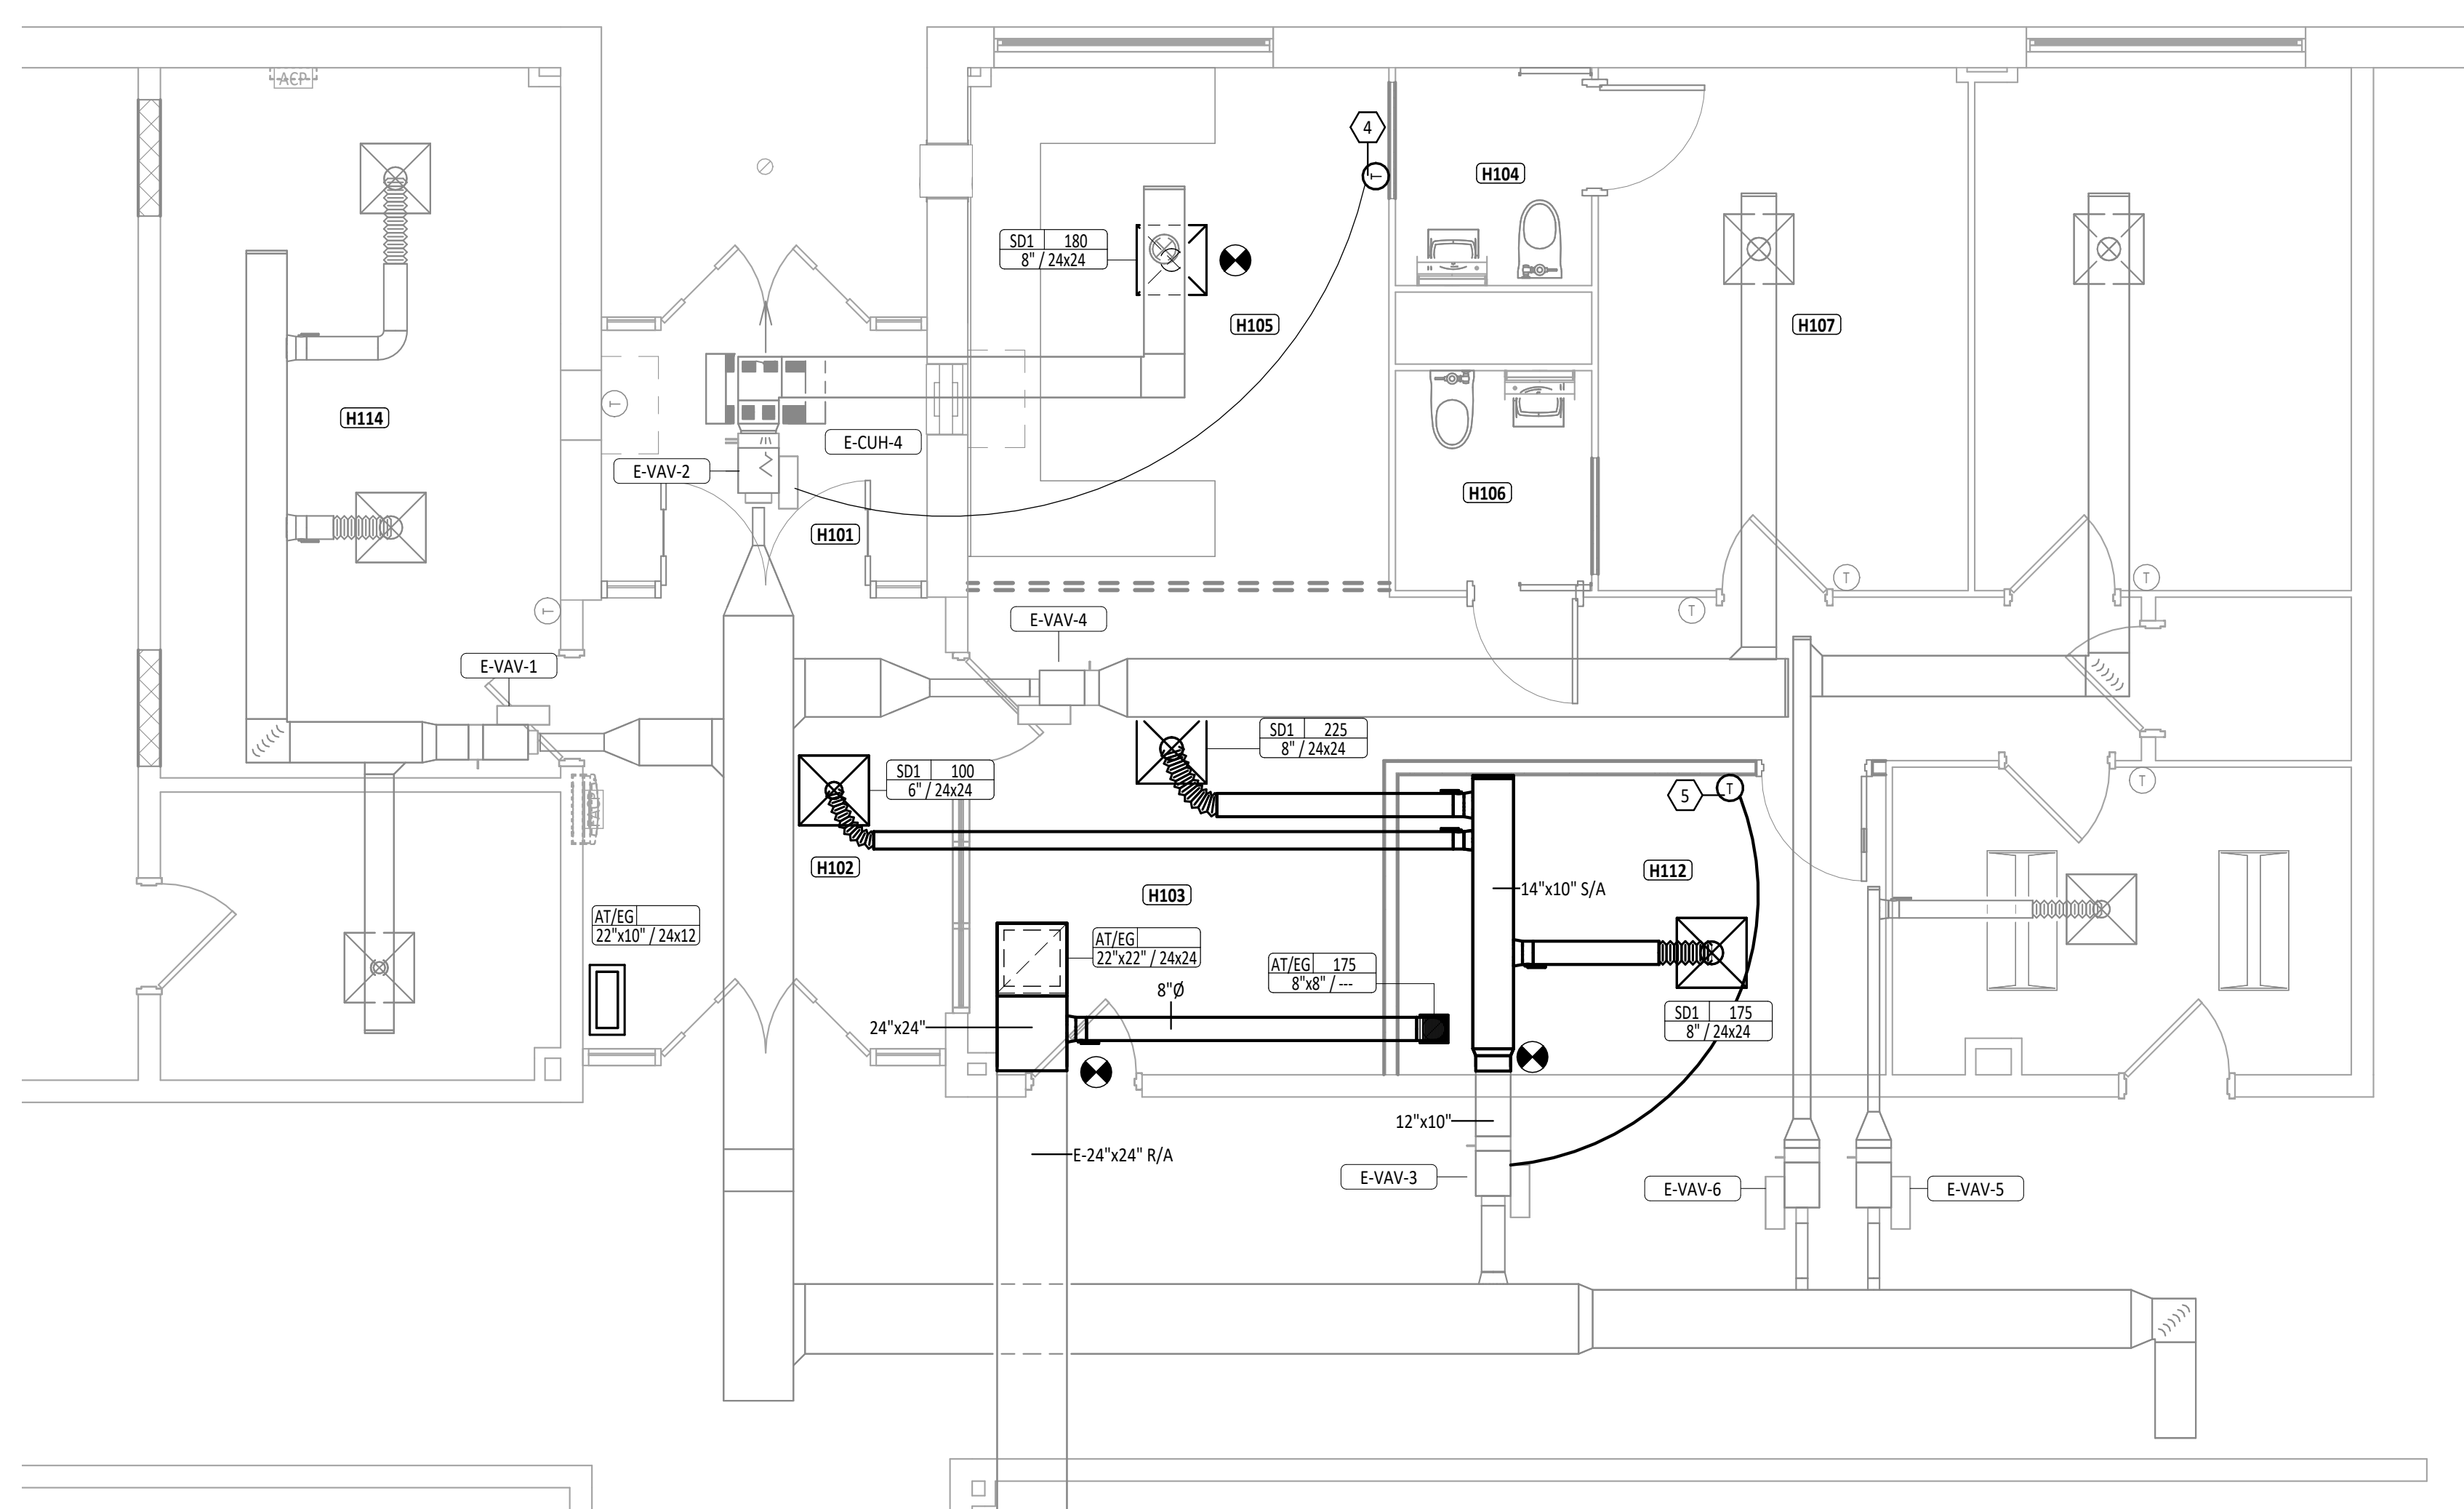


**2** FIRST FLOOR MECHANICAL AND TEMPERATURE CONTROL PLAN  
1/4" = 1'-0"

GRILLES, REGISTERS AND DIFFUSERS SCHEDULE														
ID	DESCRIPTION	MANUFACTURER	MODEL	QTY	FACE SIZE	NECK				BLADE DESIGN		INSTALLATION	NOTES	
						SIZE	WIDTH	HEIGHT	THICKNESS	SPACING	DEFLECTION ANGLE			ORIENTATION
SD1	PLAQUE FACE DIFFUSER	Titus	OMNI-AA	3	24x24	8"						TYPE 3 (LAY-IN)		
SD1	PLAQUE FACE DIFFUSER	Titus	OMNI-AA	1	24x24	6"						TYPE 3 (LAY-IN)		
AT/REG	LOUVERED GRILLE	Titus	355FL	1		8"	8"	1/8"	1/2"	35.0°	LONG	TYPE 1 (SURFACE)		
AT/REG	LOUVERED GRILLE	Titus	355FL	1	24x12		22"	10"	1/8"	1/2"	35.0°	LONG	TYPE 3 (LAY-IN)	
AT/REG	LOUVERED GRILLE	Titus	355FL	1	24x24		22"	22"	1/8"	1/2"	35.0°	LONG	TYPE 3 (LAY-IN)	

FIRST FLOOR PLAN ROOM INDEX		
ROOM NUMBER	ROOM NAME	AREA
109	STR	26 SF
H101	VESTIBULE	71 SF
H102	VESTIBULE	139 SF
H103	CIRCULATION	153 SF
H104	TOILET	35 SF
H105	RECEPTION	178 SF
H106	TOILET	35 SF
H107	NURSE	159 SF
H112	OFFICE	120 SF
H114	TECHNOLOGY	233 SF

- HVAC GENERAL NOTES**
- REMOVE ALL UNUSED PIPING, DUCTWORK AND ACCESSORIES. DISPOSE OF THESE ITEMS OFF SITE.
  - THE MECHANICAL CONTRACTOR SHALL BE RESPONSIBLE FOR FIELD VERIFYING, PRIOR TO FINAL BID, ALL EXISTING CONDITIONS FOR PLUMBING AND MECHANICAL SYSTEMS WITHIN SCOPE AREA AND WITHIN CLOSE PROXIMITY OF THE SCOPE AREA.
  - DIVISION 23 MECHANICAL CONTRACTOR IS REQUIRED TO COORDINATE DIFFUSER AND GRILLE LOCATIONS WITH ARCHITECTURAL REFLECTED CEILING PLANS.
  - ALL EQUIPMENT LOCATED ABOVE CEILING REQUIRING MAINTENANCE SHALL BE INSTALLED WITHIN (2) FEET OF THE CEILING FOR MAINTENANCE PURPOSES. DO NOT INSTALL UNITS ABOVE LIGHTS AND CEILING SPEAKERS. COORDINATE LOCATION WITH ARCHITECTURAL REFLECTED CEILING PLAN AND GENERAL CONTRACTOR.
  - ANY BALANCING DAMPERS OR OTHER DEVICES IN DUCTS ABOVE HARD CEILINGS SHALL BE LOCATED ABOVE NEAREST ACCESSIBLE CEILING.
  - THIS CONTRACTOR SHALL BE REQUIRED TO REPLACE FILTERS ON HVAC EQUIPMENT AFTER ALL DUST PRODUCING CONSTRUCTION HAS BEEN COMPLETED AND PRIOR TO THE FINAL PUNCH.
  - LOCATE DUCTWORK AND MECHANICAL EQUIPMENT AWAY FROM THE SPACE ABOVE ELECTRICAL PANELS, TRANSFORMERS AND OTHER ELECTRICAL EQUIPMENT.
  - FIRE SEAL AROUND DUCT PENETRATIONS OF FIRE RATED WALLS. REFER TO SPECIFICATION.
  - PROVIDE SLEEVES AND/OR OPENINGS TO RUN DUCTS THROUGH FOUNDATIONS, FLOORS, WALLS, AND ROOF.
  - CONTRACTOR SHALL LOCATE THERMOSTATS AND TEMPERATURE SENSORS AT 3'-8" AFF, A MINIMUM OF 4" FROM LIGHT SWITCH.
  - ALL SUPPLY, RETURN, AND EXHAUST DUCTWORK SHALL BE RATED FOR PRESSURE CLASS OF 2" W.G. UNLESS NOTED OTHERWISE.
  - COORDINATE INSTALLATION OF PIPING, DUCTWORK, CONDUIT, LIGHTS, CABLE TRAY, STRUCTURE, AND EQUIPMENT TO PREVENT CONFLICTS.
  - THE CONTRACTOR SHALL BE FAMILIAR WITH ALL THE CONDITIONS BOTH EXISTING AND THOSE ILLUSTRATED BY THESE DOCUMENTS AS WELL AS THOSE WHICH CAN BE REASONABLY ANTICIPATED INCLUDING, BUT NOT LIMITED TO ARCHITECTURAL, ELECTRICAL, VENTILATION, PLUMBING, AND OTHER SYSTEMS INVOLVED ON THIS PROJECT.
  - FINAL PRODUCT SHALL BE A COMPLETE AND FUNCTIONING SYSTEM, AND SHALL CONFORM TO ALL REQUIREMENTS OF APPLICABLE FEDERAL, STATE, AND LOCAL CODES, INCLUDING BUT NOT LIMITED TO THE INTERNATIONAL BUILDING CODE AND INTERNATIONAL MECHANICAL CODE.
  - ADJUST PIPING AND DUCTWORK SIZES TO PROPERLY CONNECT TO MECHANICAL EQUIPMENT.
  - INSTALL ALL EQUIPMENT IN ACCORDANCE WITH THE RESPECTIVE MANUFACTURER'S WRITTEN INSTALLATION INSTRUCTIONS, AT A LEVEL OF QUALITY AND WORKMANSHIP CONSISTENT WITH THE SPECIFICATIONS.
  - LOCATIONS OF PIPING, DUCTWORK AND EQUIPMENT AS INDICATED ON THE DRAWING, ARE APPROXIMATE AND SUBJECT TO MINOR ADJUSTMENTS IN THE FIELD. WORK SHALL BE COORDINATED WITH ALL OTHER TRADES TO AVOID INTERFERENCE IN THE FIELD. CONSULT ENGINEER IF MANUFACTURER'S MINIMUM CLEARANCE REQUIRED CAN'T BE MAINTAINED.

- TEMPERATURE CONTROL GENERAL NOTES**
- REFER TO SECTION 23 0913 AND 23 0993 FOR TEMPERATURE CONTROL SPECIFICATIONS.
  - INSTALL THE THERMOSTATS AND SENSORS WITH BOTTOM AT 44" AFF UNLESS OTHERWISE NOTED, A MINIMUM OF 8" FROM LIGHT SWITCH. COORDINATE HEIGHT WITH LIGHT SWITCHES. SEE DETAIL FOR ADDITIONAL INFORMATION.
- | # | KEYNOTE DESCRIPTION   |
|---|---|
| 1 | DEMOLISH SUPPLY DUCTWORK UP TO THIS LOCATION. VERIFY EXACT TYPE, SIZE, AND LOCATION ON SITE.  |
| 2 | REMOVE EXISTING RETURN GRILLE FROM THE CEILING GRID. DISPOSE OF OFF SITE. VERIFY EXACT TYPE, SIZE, AND LOCATION ON SITE. COORDINATE REPLACEMENT/REPAIR OF ACT WITH THE G.C.   |
| 3 | EXISTING THERMOSTAT TO BE RELOCATED. SEE 2/M2.1 FOR MORE DETAIL.  |
| 4 | LOCATION OF RELOCATED EXISTING THERMOSTAT. TEMPERATURE CONTROLS CONTRACTOR TO RE-CONNECT TO E-VAV-2.  |
| 5 | LOCATION OF RELOCATED EXISTING THERMOSTAT. TEMPERATURE CONTROLS CONTRACTOR TO RE-CONNECT TO E-VAV-3.  |
| 6 | DEMOLISH EXISTING RETURN AIR GRILLE AND DUCTWORK AS SHOWN. VERIFY EXACT TYPE, SIZE, AND LOCATION ON SITE. PREPARE CONNECTIONS TO NEW DUCTWORK.  |
| 7 | EXISTING ELECTRIC RADIANT HEATER TO REMAIN. VERIFY EXACT TYPE, SIZE, AND LOCATION ON SITE.  |
| 8 | EXISTING ELECTRIC RADIANT HEATER TO BE DEMOLISHED. VERIFY EXACT TYPE, SIZE, AND LOCATION ON SITE. COORDINATE PATCH AND REPAIR OF THE EXISTING WALL WITH THE GENERAL CONTRACTOR. COORDINATE WORK WITH THE ELECTRICAL CONTRACTOR. |

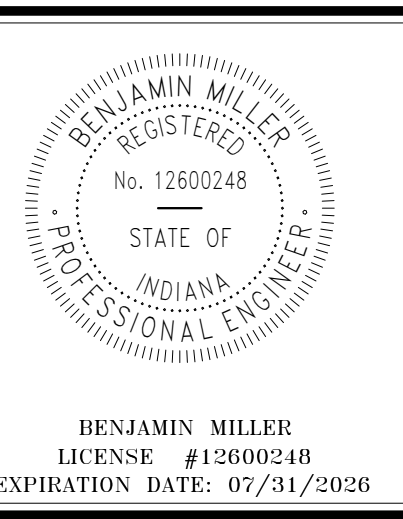


**JENNINGS COUNTY SCHOOL CORPORATION**  
**HAYDEN ELEMENTARY**  
 34 WEST MAIN STREET, NORTH VERNON, INDIANA 47255


ISSUANCES/REVISIONS		
CONSTRUCTION DOCUMENTS	03/28/2025	
1	CONSTRUCTION DOCUMENTS - ADDENDUM 02	04/23/2025

PROJECT NUMBER	DRAWN BY	CHECKED BY
25064.00	DMB	CSM


SHEET TITLE:  
**FIRST FLOOR MECHANICAL PLAN**

SHEET NUMBER:  
**H-M2.1**

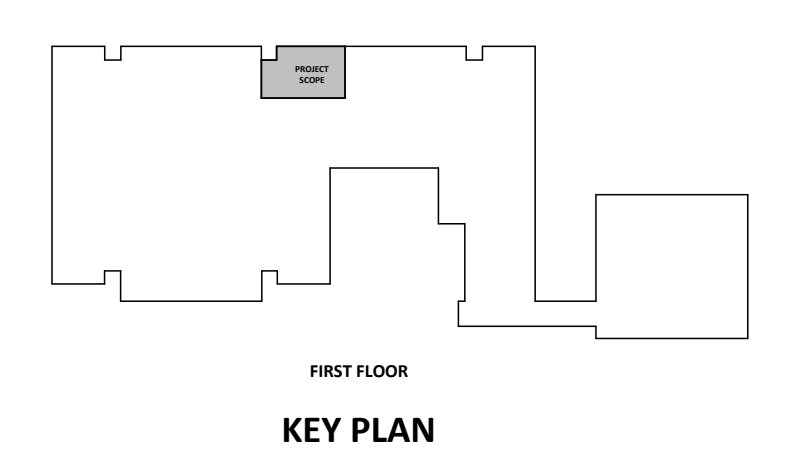

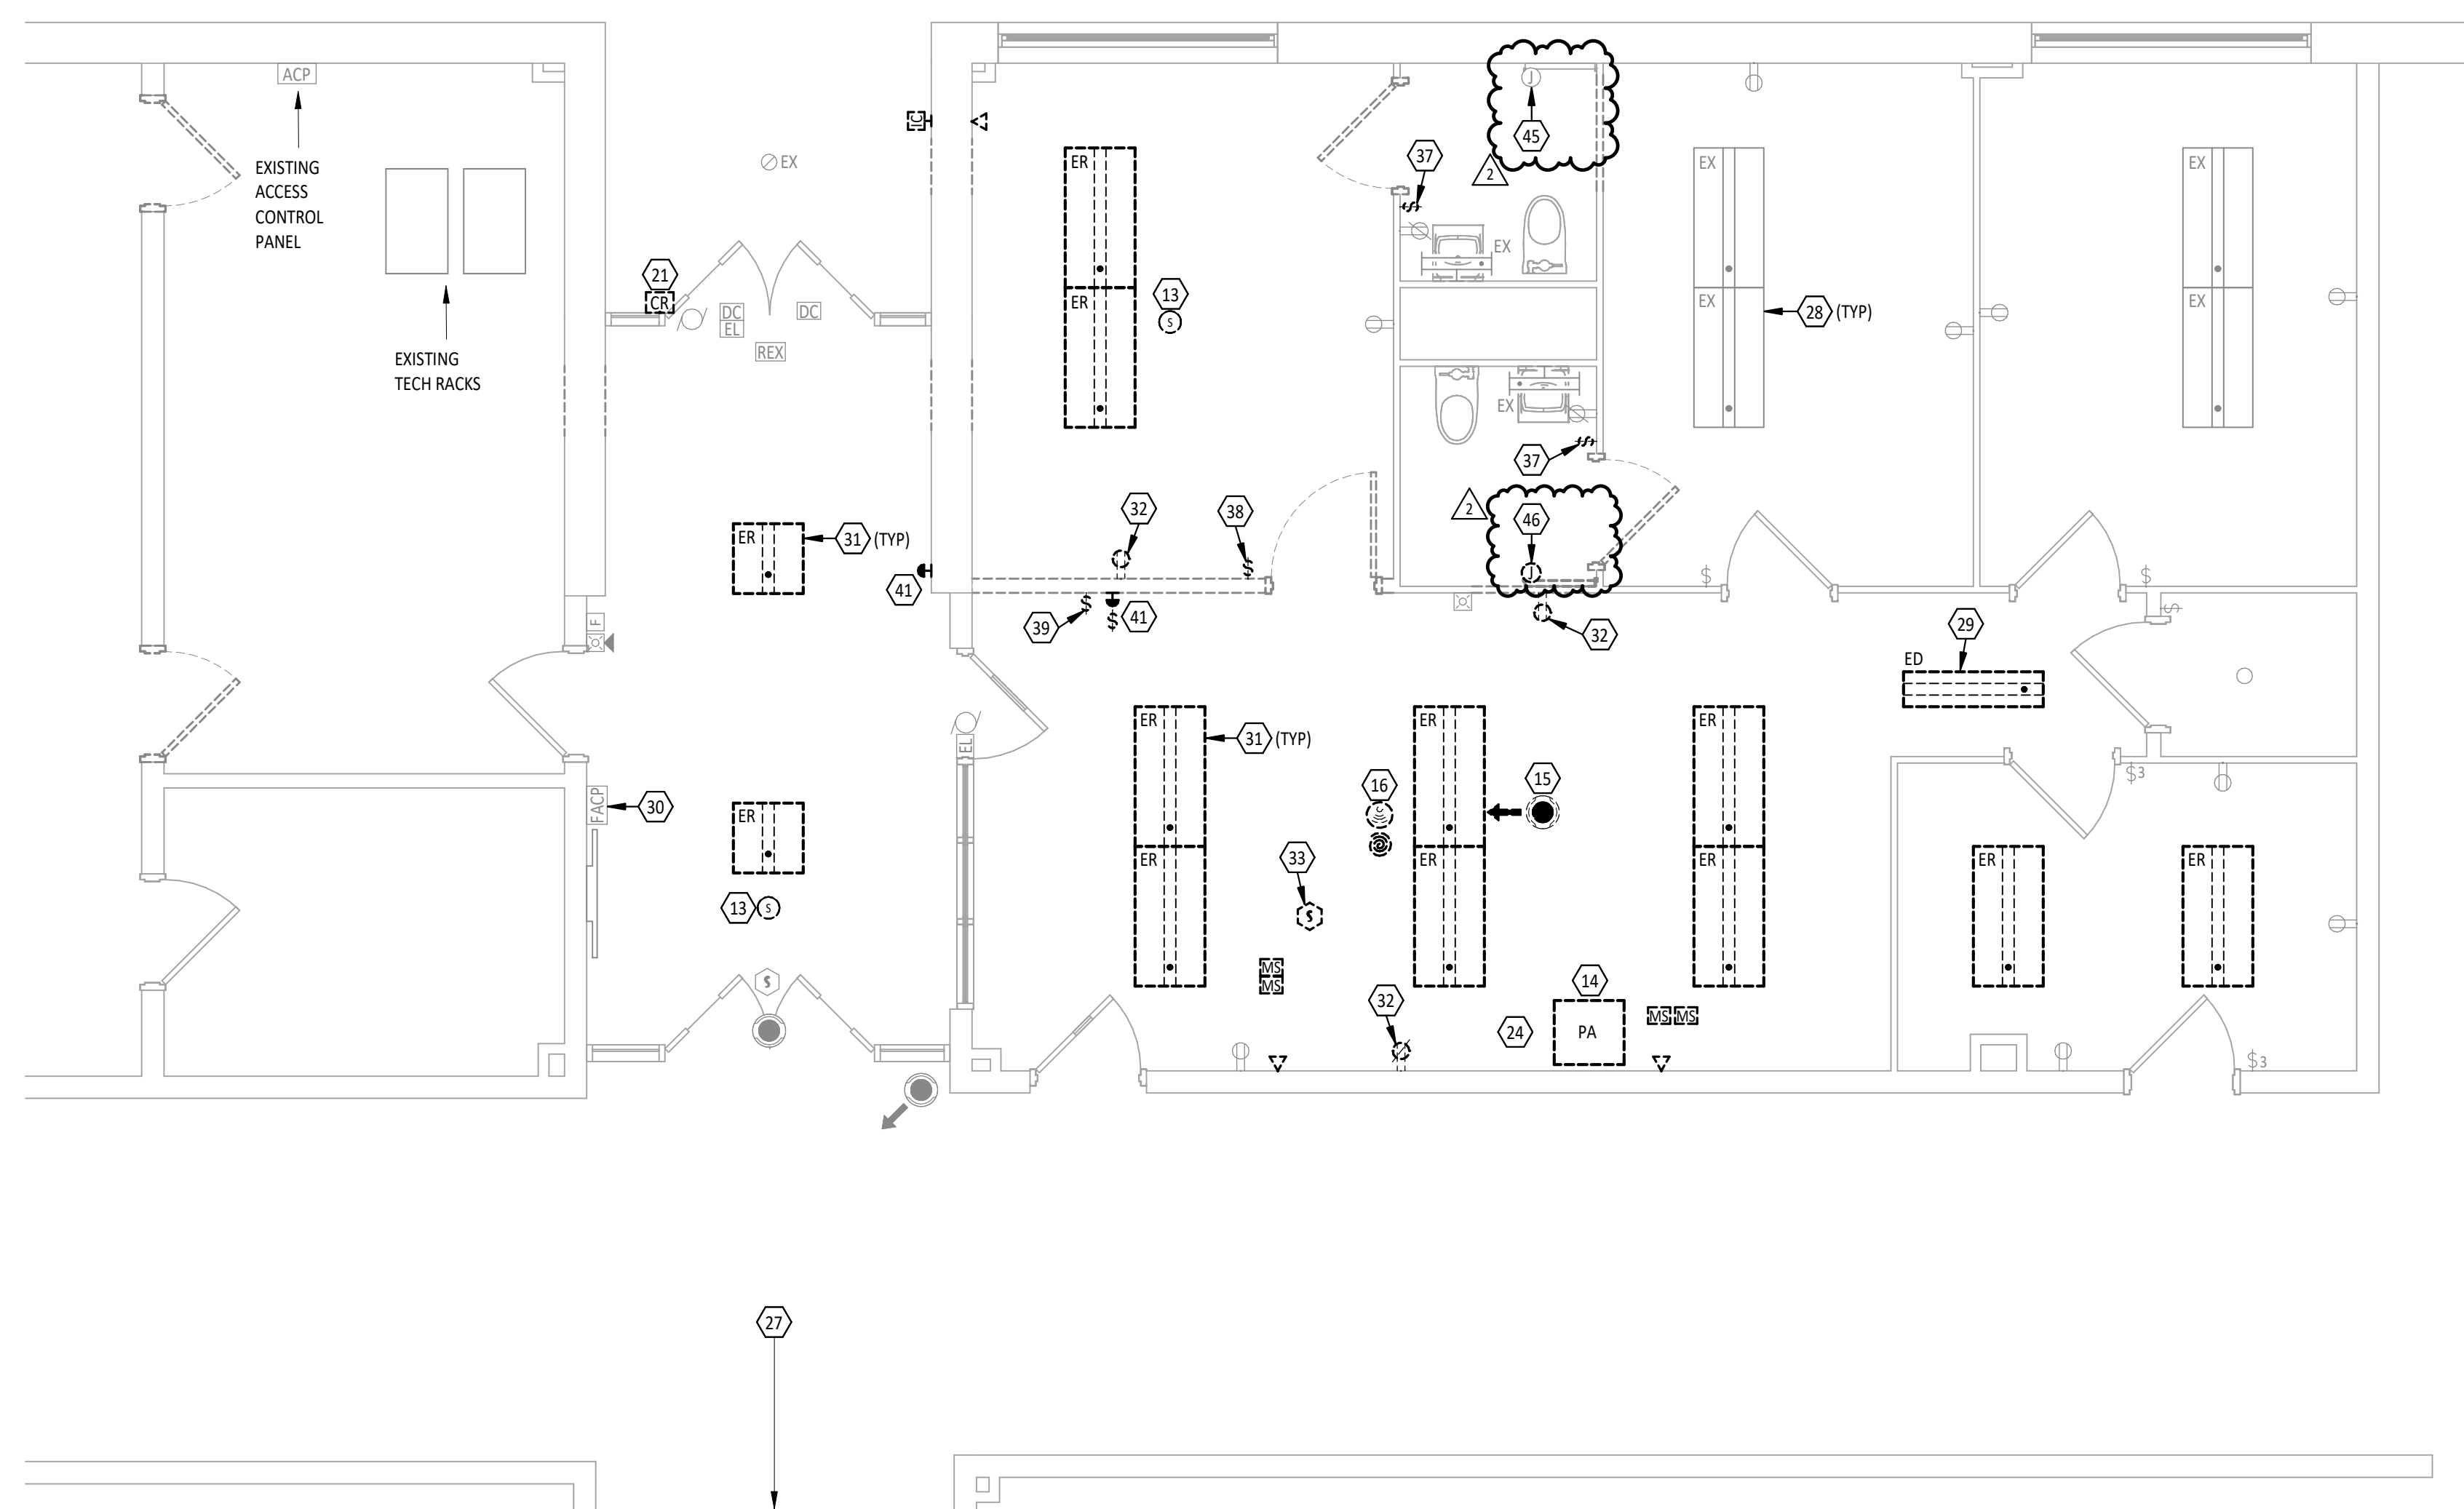


**1 PARTIAL ELECTRICAL AND TECHNOLOGY DEMOLITION PLAN**  
1/4" = 1'-0"

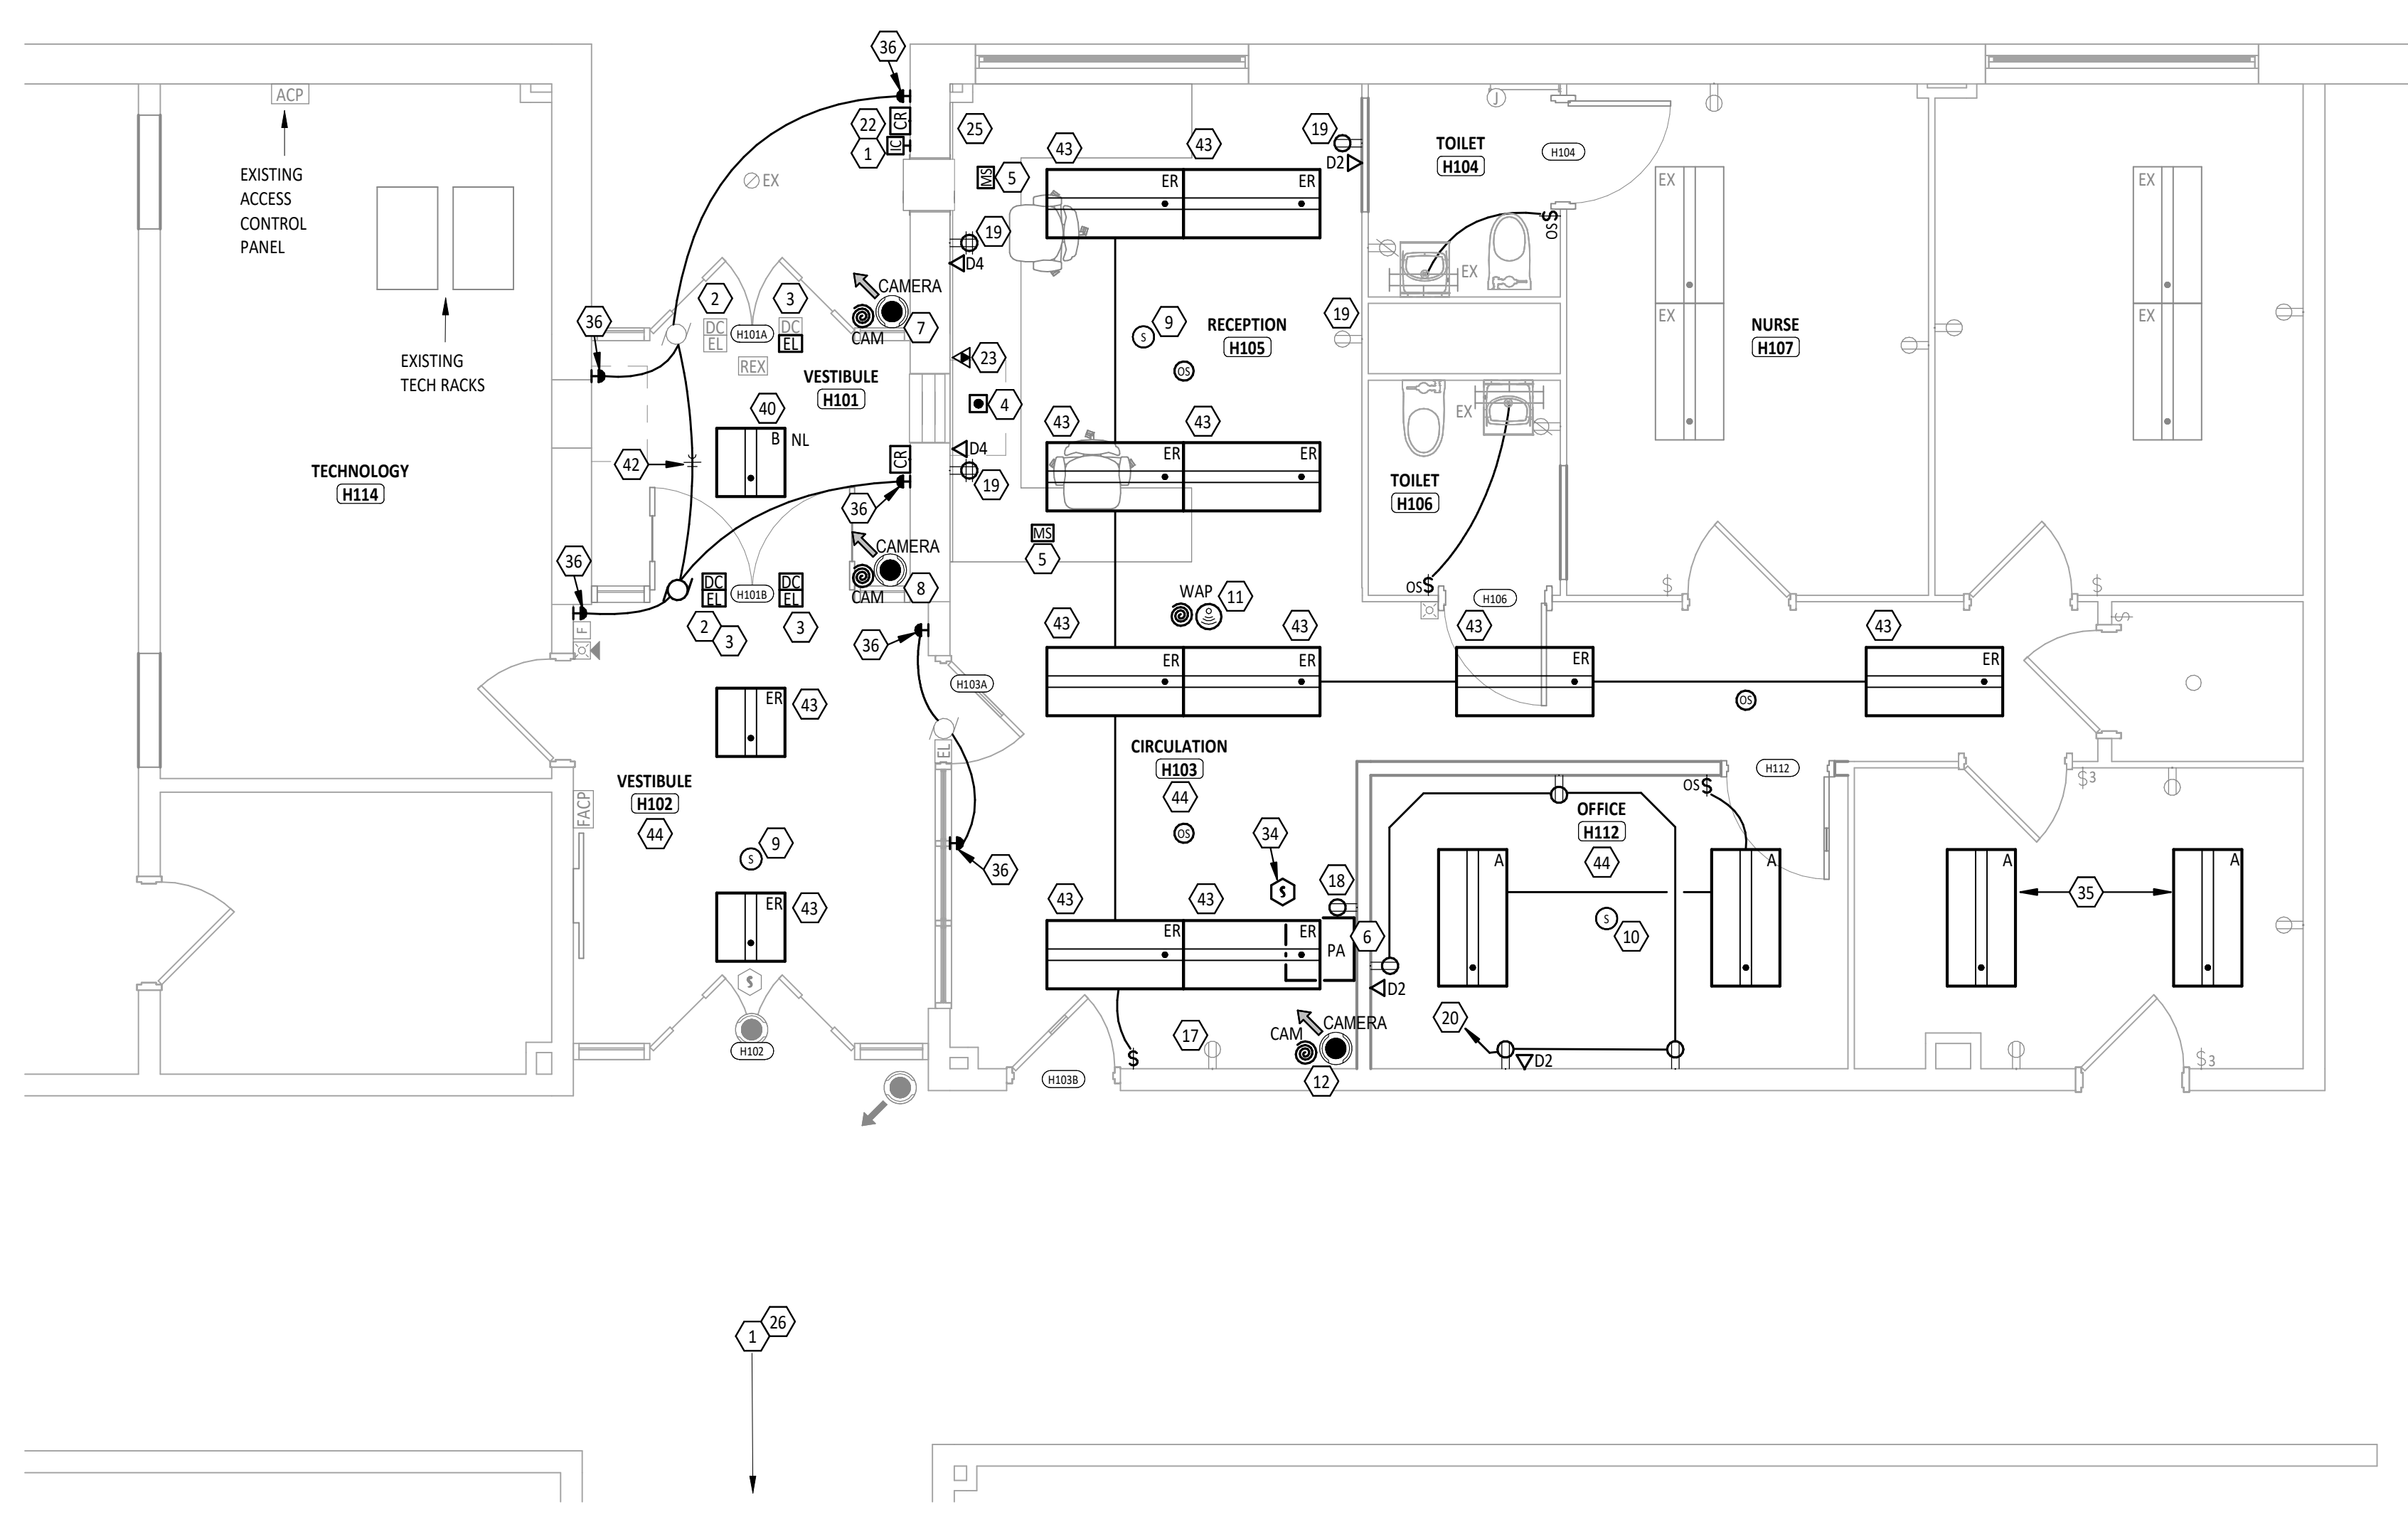


**2 ELECTRICAL AND TECHNOLOGY PLAN**  
1/4" = 1'-0"

FIRST FLOOR PLAN ROOM INDEX		
ROOM NUMBER	ROOM NAME	AREA
109	STR	26 SF
H101	VESTIBULE	71 SF
H102	VESTIBULE	139 SF
H103	CIRCULATION	153 SF
H104	TOILET	35 SF
H105	RECEPTION	178 SF
H106	TOILET	35 SF
H107	NURSE	159 SF
H112	OFFICE	120 SF
H114	TECHNOLOGY	233 SF

- | #  | KEYNOTE DESCRIPTION  |
|----|--|
| 1  | PROVIDE A VIDEO INTERCOM STATION - AIPHONE IX-DV. COORDINATE BACK BOX ROUGH IN AND PATHWAY REQUIREMENTS WITH THE ELECTRICAL CONTRACTOR.  |
| 2  | SECURITY/ACCESS CONTROL CONTRACTOR SHALL INTEGRATE THE HANDICAP DOOR OPERATOR INTO THE ACCESS CONTROL SYSTEM. PROVIDE CABLING AND EQUIPMENT NECESSARY TO ACTIVATE INBOUND HANDICAP PUSH BUTTONS ON A VALID CARD READ AND TO UNLOCK DOOR ON OUTBOUND HANDICAP PUSH BUTTON. COORDINATE WITH THE GENERAL CONTRACTOR.  |
| 3  | DOOR PROVIDED WITH ELECTRIC STRIKE BY DOOR HARDWARE SUPPLIER. DOOR HARDWARE SUPPLIER TO PROVIDE POWER PACK WITH DRY CONTACT FOR ELECTRIC STRIKE. PROVIDE WIRING FROM ELECTRIC STRIKE POWER PACK TO ACCESS CONTROL SYSTEM. COORDINATE WORK WITH HARDWARE SUPPLIER PRIOR TO ROUGH-IN. CONNECT DOOR TO ACCESS CONTROL SYSTEM TO PROVIDE INDIVIDUAL TIMED CONTROL OF THE ELECTRIC STRIKE. DIVISION 26 TO PROVIDE ALL PATHWAYS AND POWER REQUIRED FOR PROPER OPERATION. |
| 4  | PROVIDE A DOOR RELEASE PUSHBUTTON TO RELEASE VESTIBULE DOOR "H101". PROVIDE ANY CABLING AND HARDWARE NEEDED TO INTERFACE WITH ACCESS CONTROL SYSTEM. COORDINATE EXACT LOCATION WITH OWNER BEFORE INSTALLATION.   |
| 5  | PROVIDE A MASTER VIDEO INTERCOM STATION AIPHONE IXX-MK INTERFACE WITH ACCESS CONTROL SYSTEM TO UNLOCK ANY DOOR WITH A VIDEO INTERCOM STATION. COORDINATE EXACT LOCATION WITH OWNER BEFORE INSTALLATION.  |
| 6  | RELOCATE THE PAGING EQUIPMENT FOR THE PUBLIC ADDRESS SYSTEM. EXTEND AND REROUTE CABLING AS NECESSARY. COORDINATE EXACT LOCATION WITH OWNER BEFORE INSTALLATION.  |
| 7  | PROVIDE A CEILING MOUNT EXTERIOR CAMERA MOUNTED ON THE SOFFIT - AVIGLON H6 MINI DOME CAMERA. PROVIDE LICENSING AS REQUIRED AND INTEGRATE INTO EXISTING CCTV SYSTEM.  |
| 8  | PROVIDE A CEILING MOUNT INTERIOR CAMERA - AVIGLON H6 MINI DOME CAMERA. PROVIDE LICENSING AS REQUIRED AND INTEGRATE INTO EXISTING CCTV SYSTEM.  |
| 9  | RELOCATE EXISTING PUBLIC ADDRESS SPEAKER AND CABLING SALVAGED FROM THE DEMOLITION PHASE.   |
| 10 | PROVIDE NEW PUBLIC ADDRESS SPEAKER AND CABLING. CONNECT TO EXISTING PAGING SYSTEM - SPEAKER: BOGEN S88172SPBU, CEILING TIE BRIDGE: BOGEN TBS, AND CEILING SPEAKER ENCLOSURE: BOGEN R84, OR EQUIVALENTS.  |
| 11 | RELOCATE EXISTING WIRELESS ACCESS POINT AND CABLING SALVAGED FROM THE DEMOLITION PHASE.  |
| 12 | RELOCATE EXISTING CEILING MOUNT INTERIOR CAMERA SALVAGED FROM THE DEMOLITION PHASE. INTEGRATE INTO EXISTING CCTV SYSTEM.   |
| 13 | SALVAGE PUBLIC ADDRESS SPEAKER AND COIL CABLING ABOVE CEILING FOR REUSE.   |
| 14 | SALVAGE WALL MOUNT PAGING SYSTEM RACK FOR REINSTALLATION.  |
| 15 | SALVAGE CEILING MOUNT INTERIOR CAMERA AND COIL CABLING ABOVE CEILING FOR REUSE.  |
| 16 | SALVAGE WIRELESS ACCESS POINT AND COIL CABLING ABOVE CEILING FOR REUSE.  |
| 17 | EXTEND EXISTING CIRCUIT C-6 TO NEW LOCATION.   |
| 18 | RECEPTACLE FOR PA SYSTEM. PROVIDE NEW DEDICATED CIRCUIT FROM NEAREST BREAKER PANEL. COORDINATE WITH TECHNOLOGY CONTRACTOR FOR EXACT LOCATION OF RECEPTACLE.  |
| 19 | EXTEND EXISTING CIRCUIT C-4 TO NEW LOCATION.   |
| 20 | PROVIDE NEW CIRCUIT FROM NEAREST BREAKER PANEL FOR RECEPTACLE.   |
| 21 | SALVAGE CARD READER FOR RELOCATION.  |
| 22 | RELOCATE EXISTING CARD READER SALVAGED FROM THE DEMOLITION PHASE.  |
| 23 | RELOCATE THE PAGING CONSOLE AND ASSOCIATED CABLING FOR THE PUBLIC ADDRESS SYSTEM. COORDINATE EXACT LOCATION WITH OWNER BEFORE INSTALLATION.  |
| 24 | SALVAGE EXISTING BUS RADIO FOR RELOCATION.   |
| 25 | RELOCATE EXISTING BUS RADIO. EXTEND AND RE-ROUTE ANTENNA CABLE AS NEEDED. COORDINATE EXACT LOCATION WITH OWNER BEFORE INSTALLATION.  |
| 26 | DOOR H TO ALSO HAVE NEW VIDEO INTERCOM STATION, AND BE CONTROLLED BY MASTER INTERCOM STATIONS AT RECEPTION.  |
| 27 | DOOR H ANALOG VIDEO INTERCOM STATION TO ALSO BE DEMOLISHED.  |
| 28 | EXISTING LIGHTS NOTED "EX" TO REMAIN.  |
| 29 | REMOVE LIGHT FIXTURE AND ASSOCIATED CIRCUITRY TO NEAREST JUNCTION BOX.   |
| 30 | EXISTING FIRE ALARM CONTROL PANEL TO REMAIN.   |
| 31 | EXISTING LIGHT FIXTURE NOTED AS "ER" TO BE REMOVED AND SALVAGED FOR REINSTALLATION AS A PART OF NEW WORK.  |
| 32 | REMOVE RECEPTACLE AND ASSOCIATED CIRCUITRY.  |
| 33 | REMOVE SMOKE DETECTOR AND SALVAGE FOR REINSTALLATION AS PART OF NEW WORK.  |
| 34 | REINSTALL SMOKE DETECTOR, SALVAGED FROM DEMOLITION WORK, AS REQUIRED.  |
| 35 | CONNECT LIGHT FIXTURES TO EXISTING CIRCUIT AND SWITCHING AS BEFORE.  |
| 36 | HANDICAP PUSHBUTTON ADD DOOR OPERATOR FURNISHED BY OTHERS. E.C. TO PROVIDE ALL POWER CONNECTIONS TO MOTOR AND PUSHBUTTONS. COORDINATE WITH DOOR OPERATOR INSTALLER.  |
| 37 | REMOVE LIGHT SWITCH AND PROVIDE BLANK COVERPLATE. MODIFY/EXTEND EXISTING CIRCUIT AS REQUIRED TO NEW SWITCH LOCATION.   |
| 38 | REMOVE LIGHT SWITCH AND ASSOCIATED CIRCUITRY.  |
| 39 | REMOVE LIGHT SWITCH. MODIFY/EXTEND EXISTING CIRCUIT AS REQUIRED TO NEW SWITCH LOCATION.  |
| 40 | CONNECT LIGHT FIXTURE TO EXISTING CIRCUIT FEEDING THIS SPACE. WIRE AS A NIGHT LIGHT.   |
| 41 | REMOVE EXISTING ADD PUSH BUTTON.   |
| 42 | MODIFY/EXTEND EXISTING 120V ADD DOOR OPERATOR CIRCUIT TO NEW DOOR AS REQUIRED.   |
| 43 | REINSTALL LIGHT FIXTURE, SALVAGED FROM DEMOLITION WORK.  |
| 44 | CONNECT LIGHTS TO EXISTING CIRCUIT PREVIOUSLY SERVING AREA. MODIFY/EXTEND EXISTING CIRCUIT AS REQUIRED AS NECESSARY.   |
| 45 | EXISTING ELECTRIC RADIANT HEATER TO REMAIN.  |
| 46 | REMOVE EXISTING ELECTRIC RADIANT HEATER AND ASSOCIATED CIRCUITRY. COORDINATE WITH DIVISION 23.   |

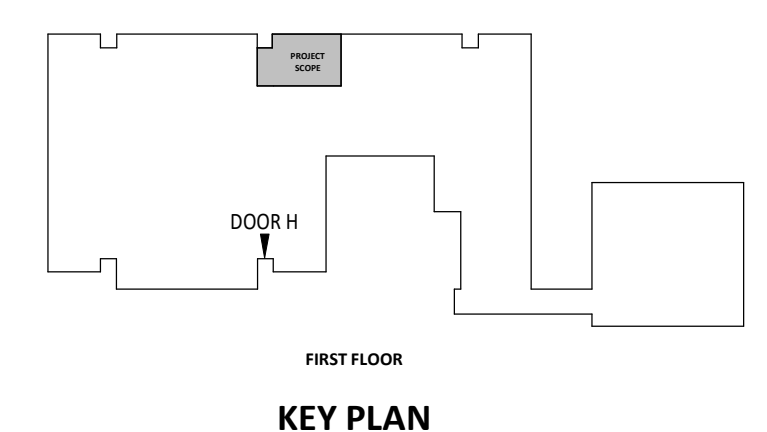

KEY PLAN

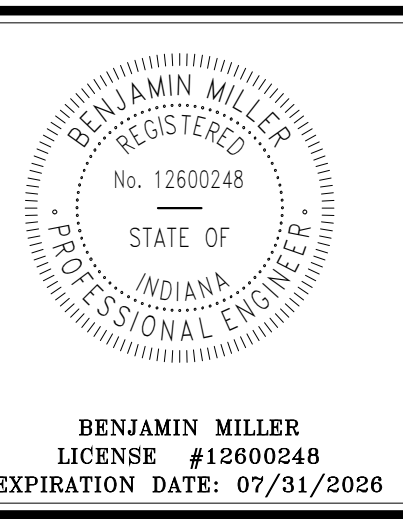



**JENNINGS COUNTY SCHOOL CORPORATION**  
**HAYDEN ELEMENTARY**

ISSUANCES/REVISIONS		
1	CONSTRUCTION DOCUMENTS - ADDENDUM 01	02/26/2025
2	CONSTRUCTION DOCUMENTS - ADDENDUM 02	04/07/2025
		04/13/2025

PROJECT NUMBER:	DRAWN BY:	CHECKED BY:
25064.00	GAW	NDL



**ELECTRICAL AND TECHNOLOGY PLAN**

SHEET NUMBER:  
**H-ET2.1**

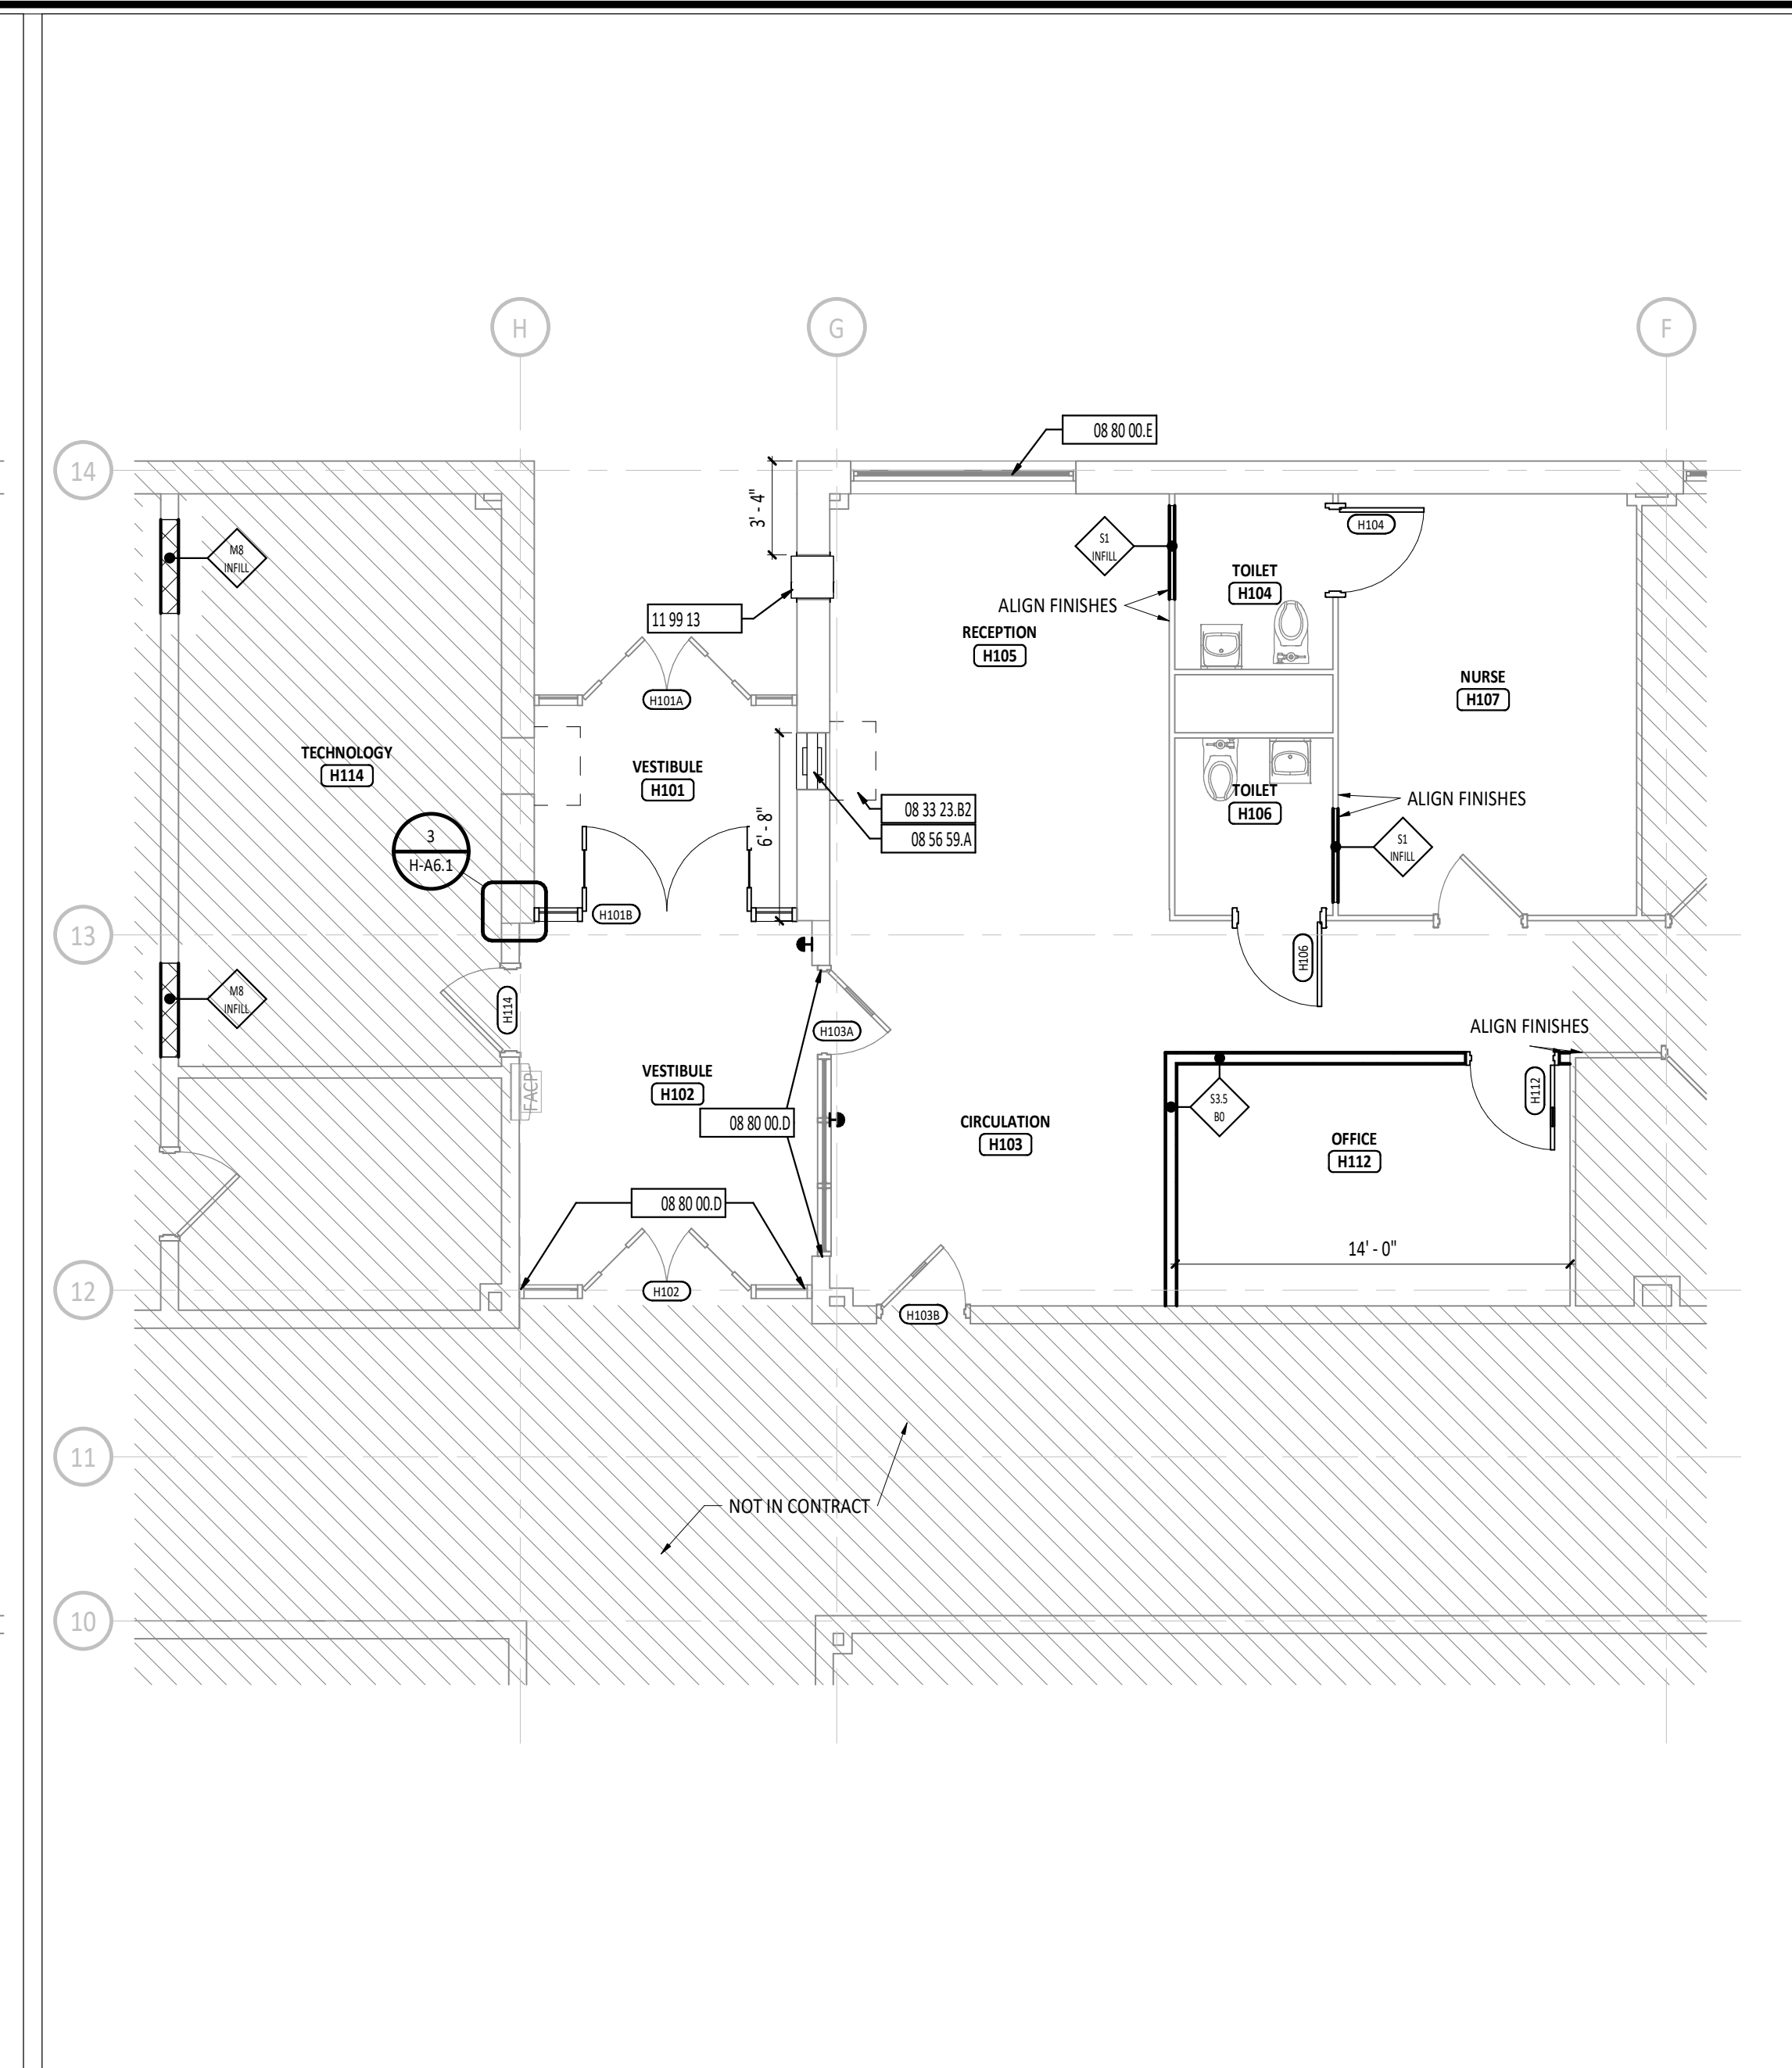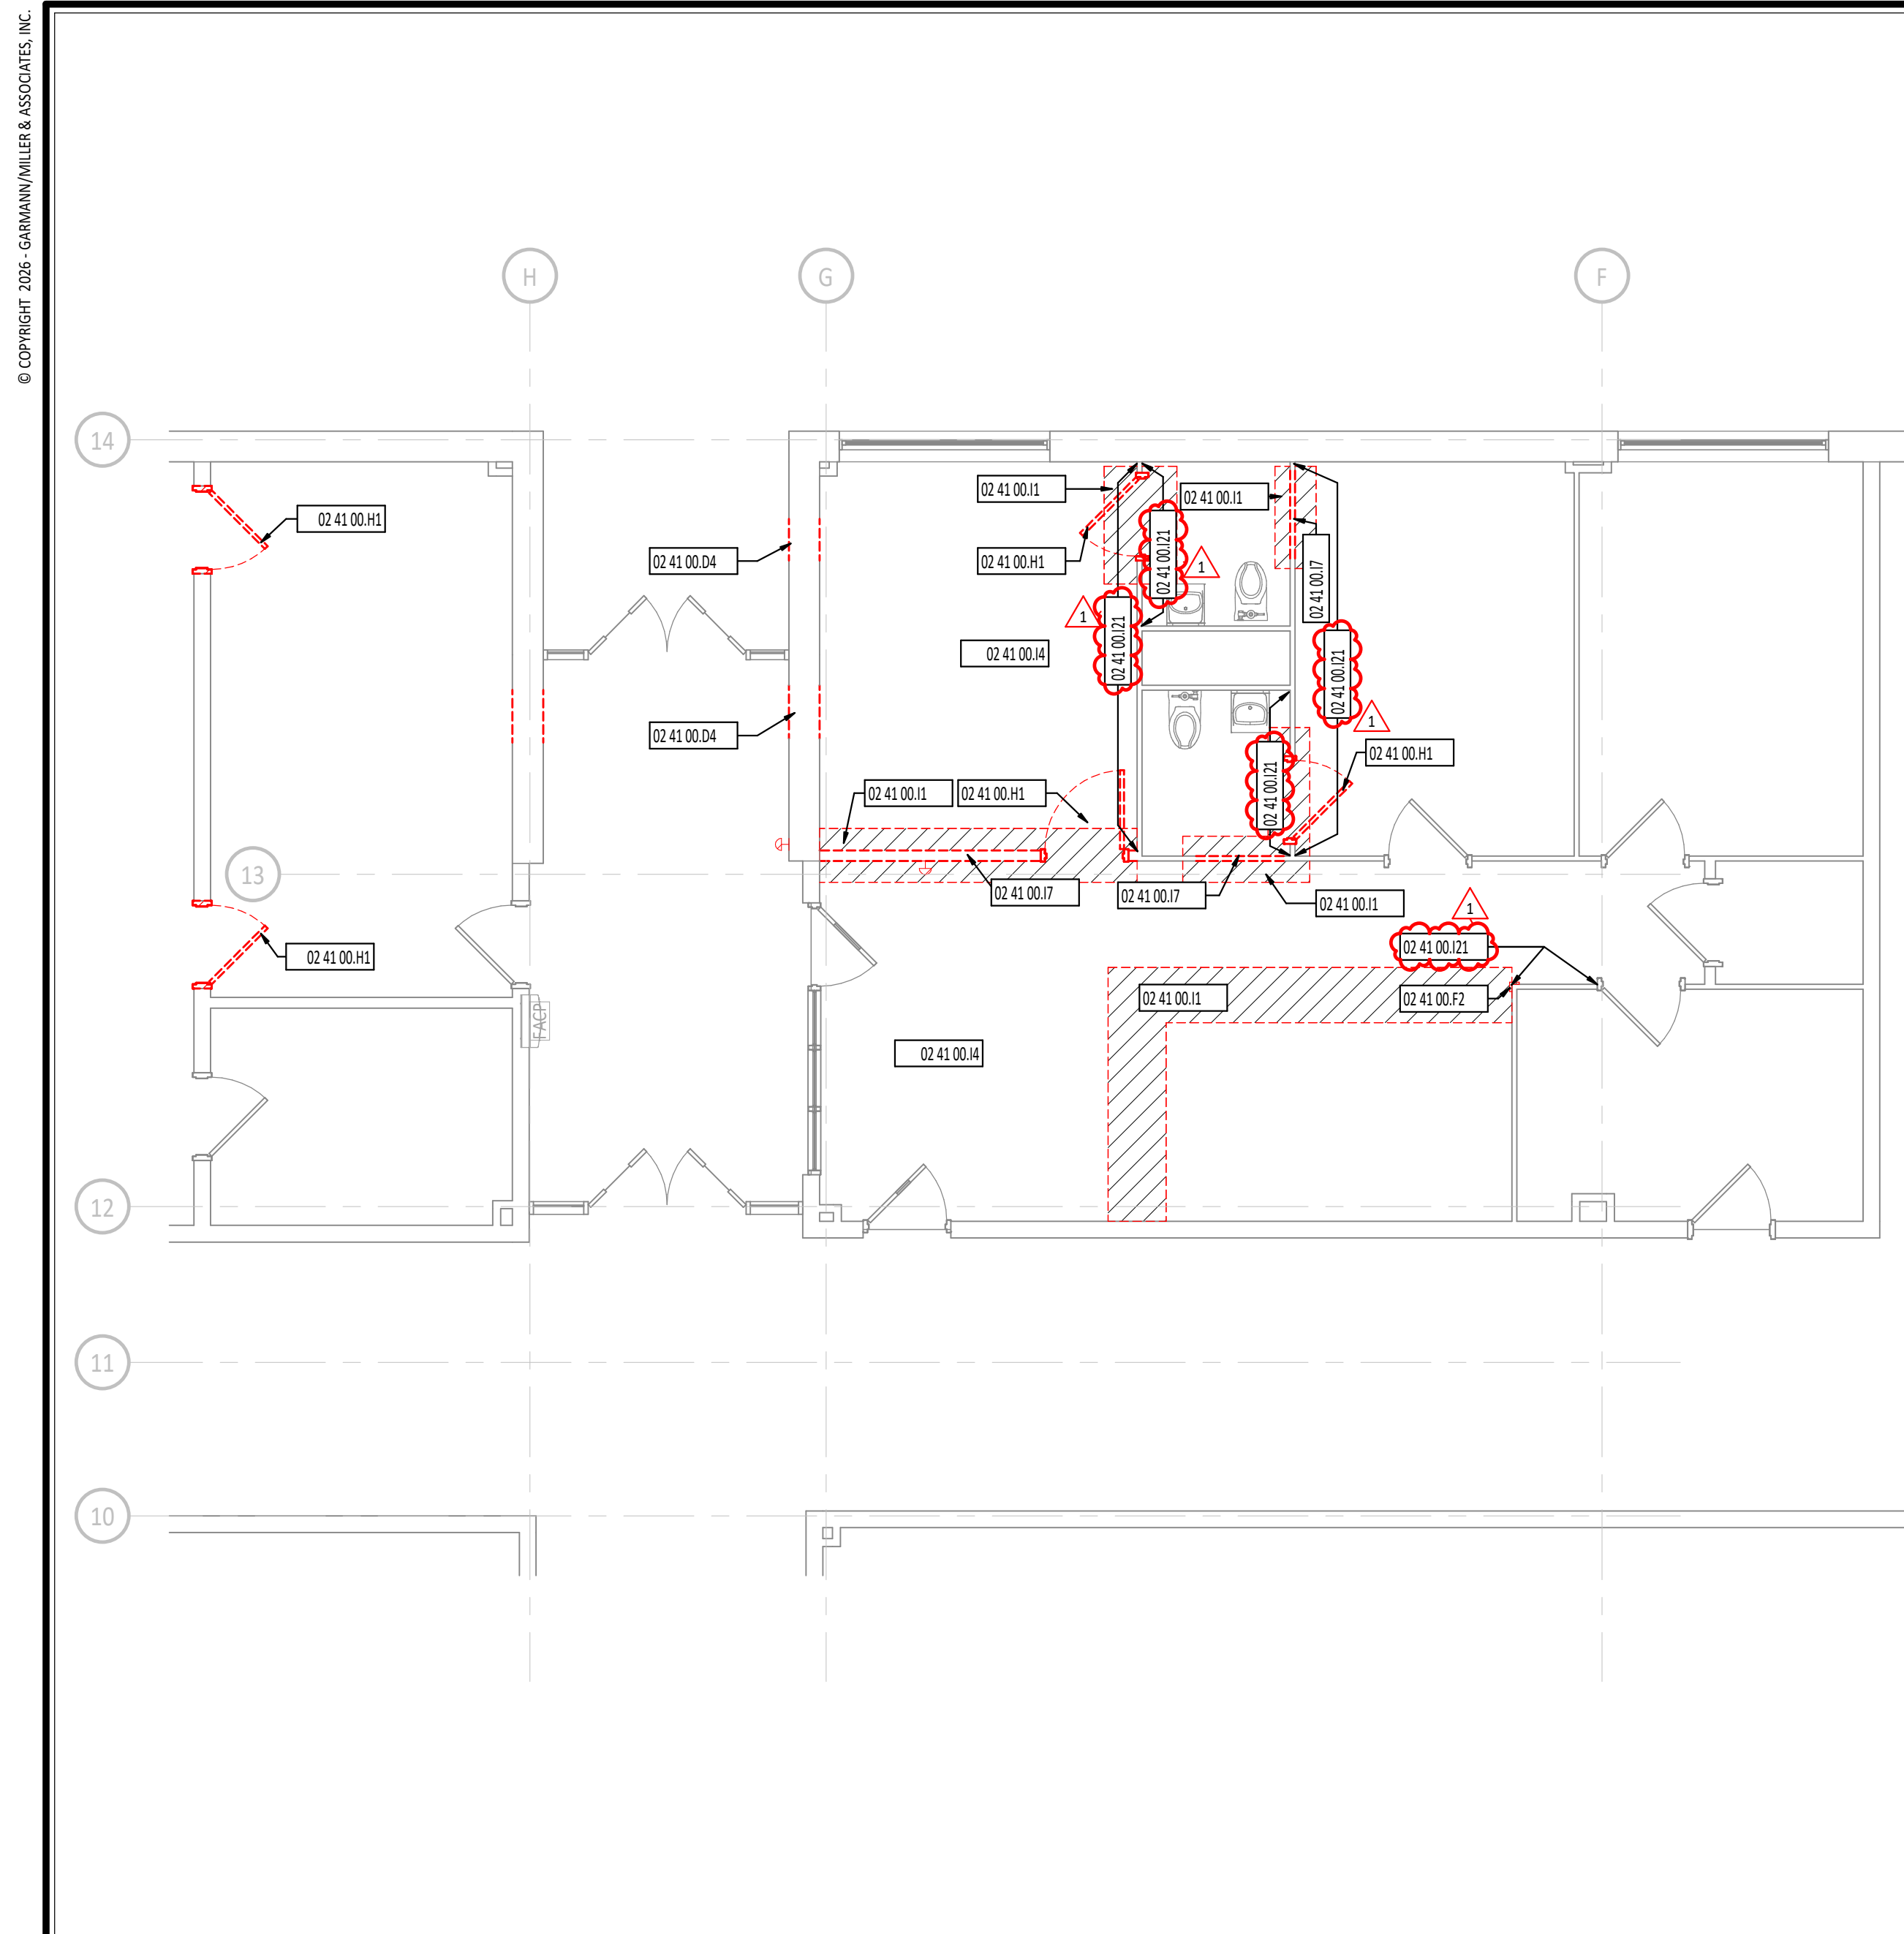


**1 FIRST FLOOR DEMOLITION PLAN**  
3/16" = 1'-0"

**2 FIRST FLOOR PLAN**  
3/16" = 1'-0"

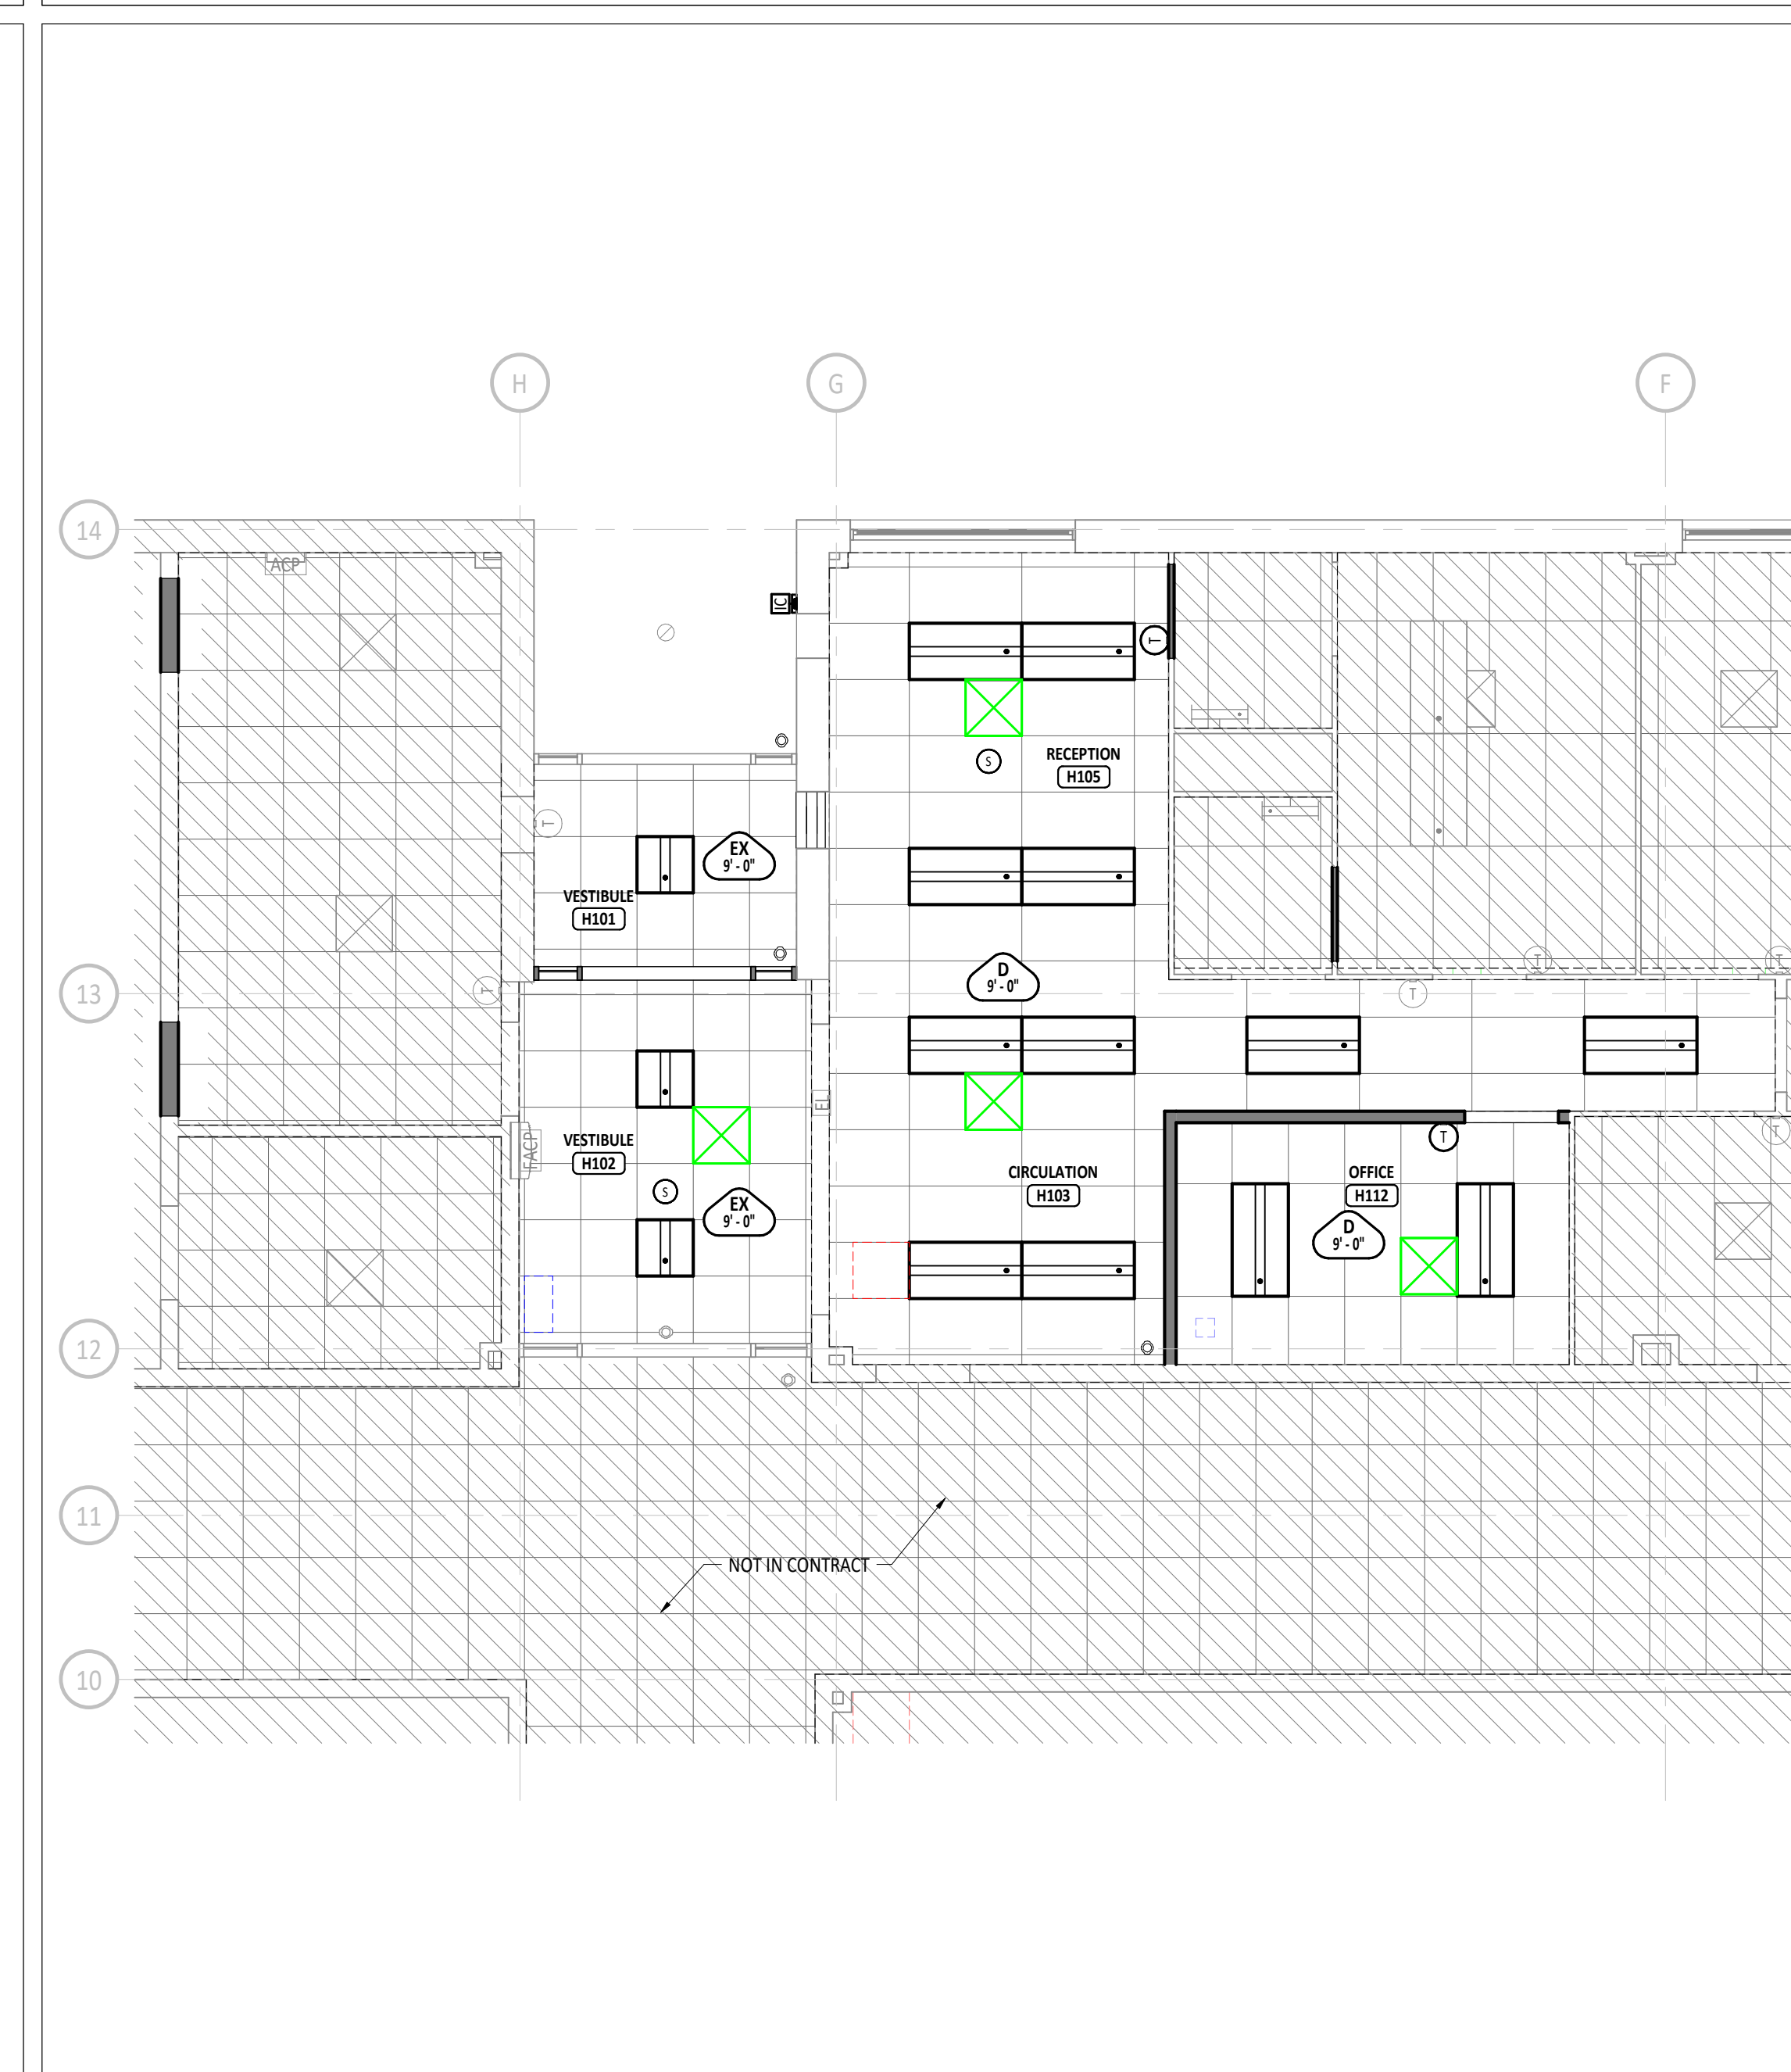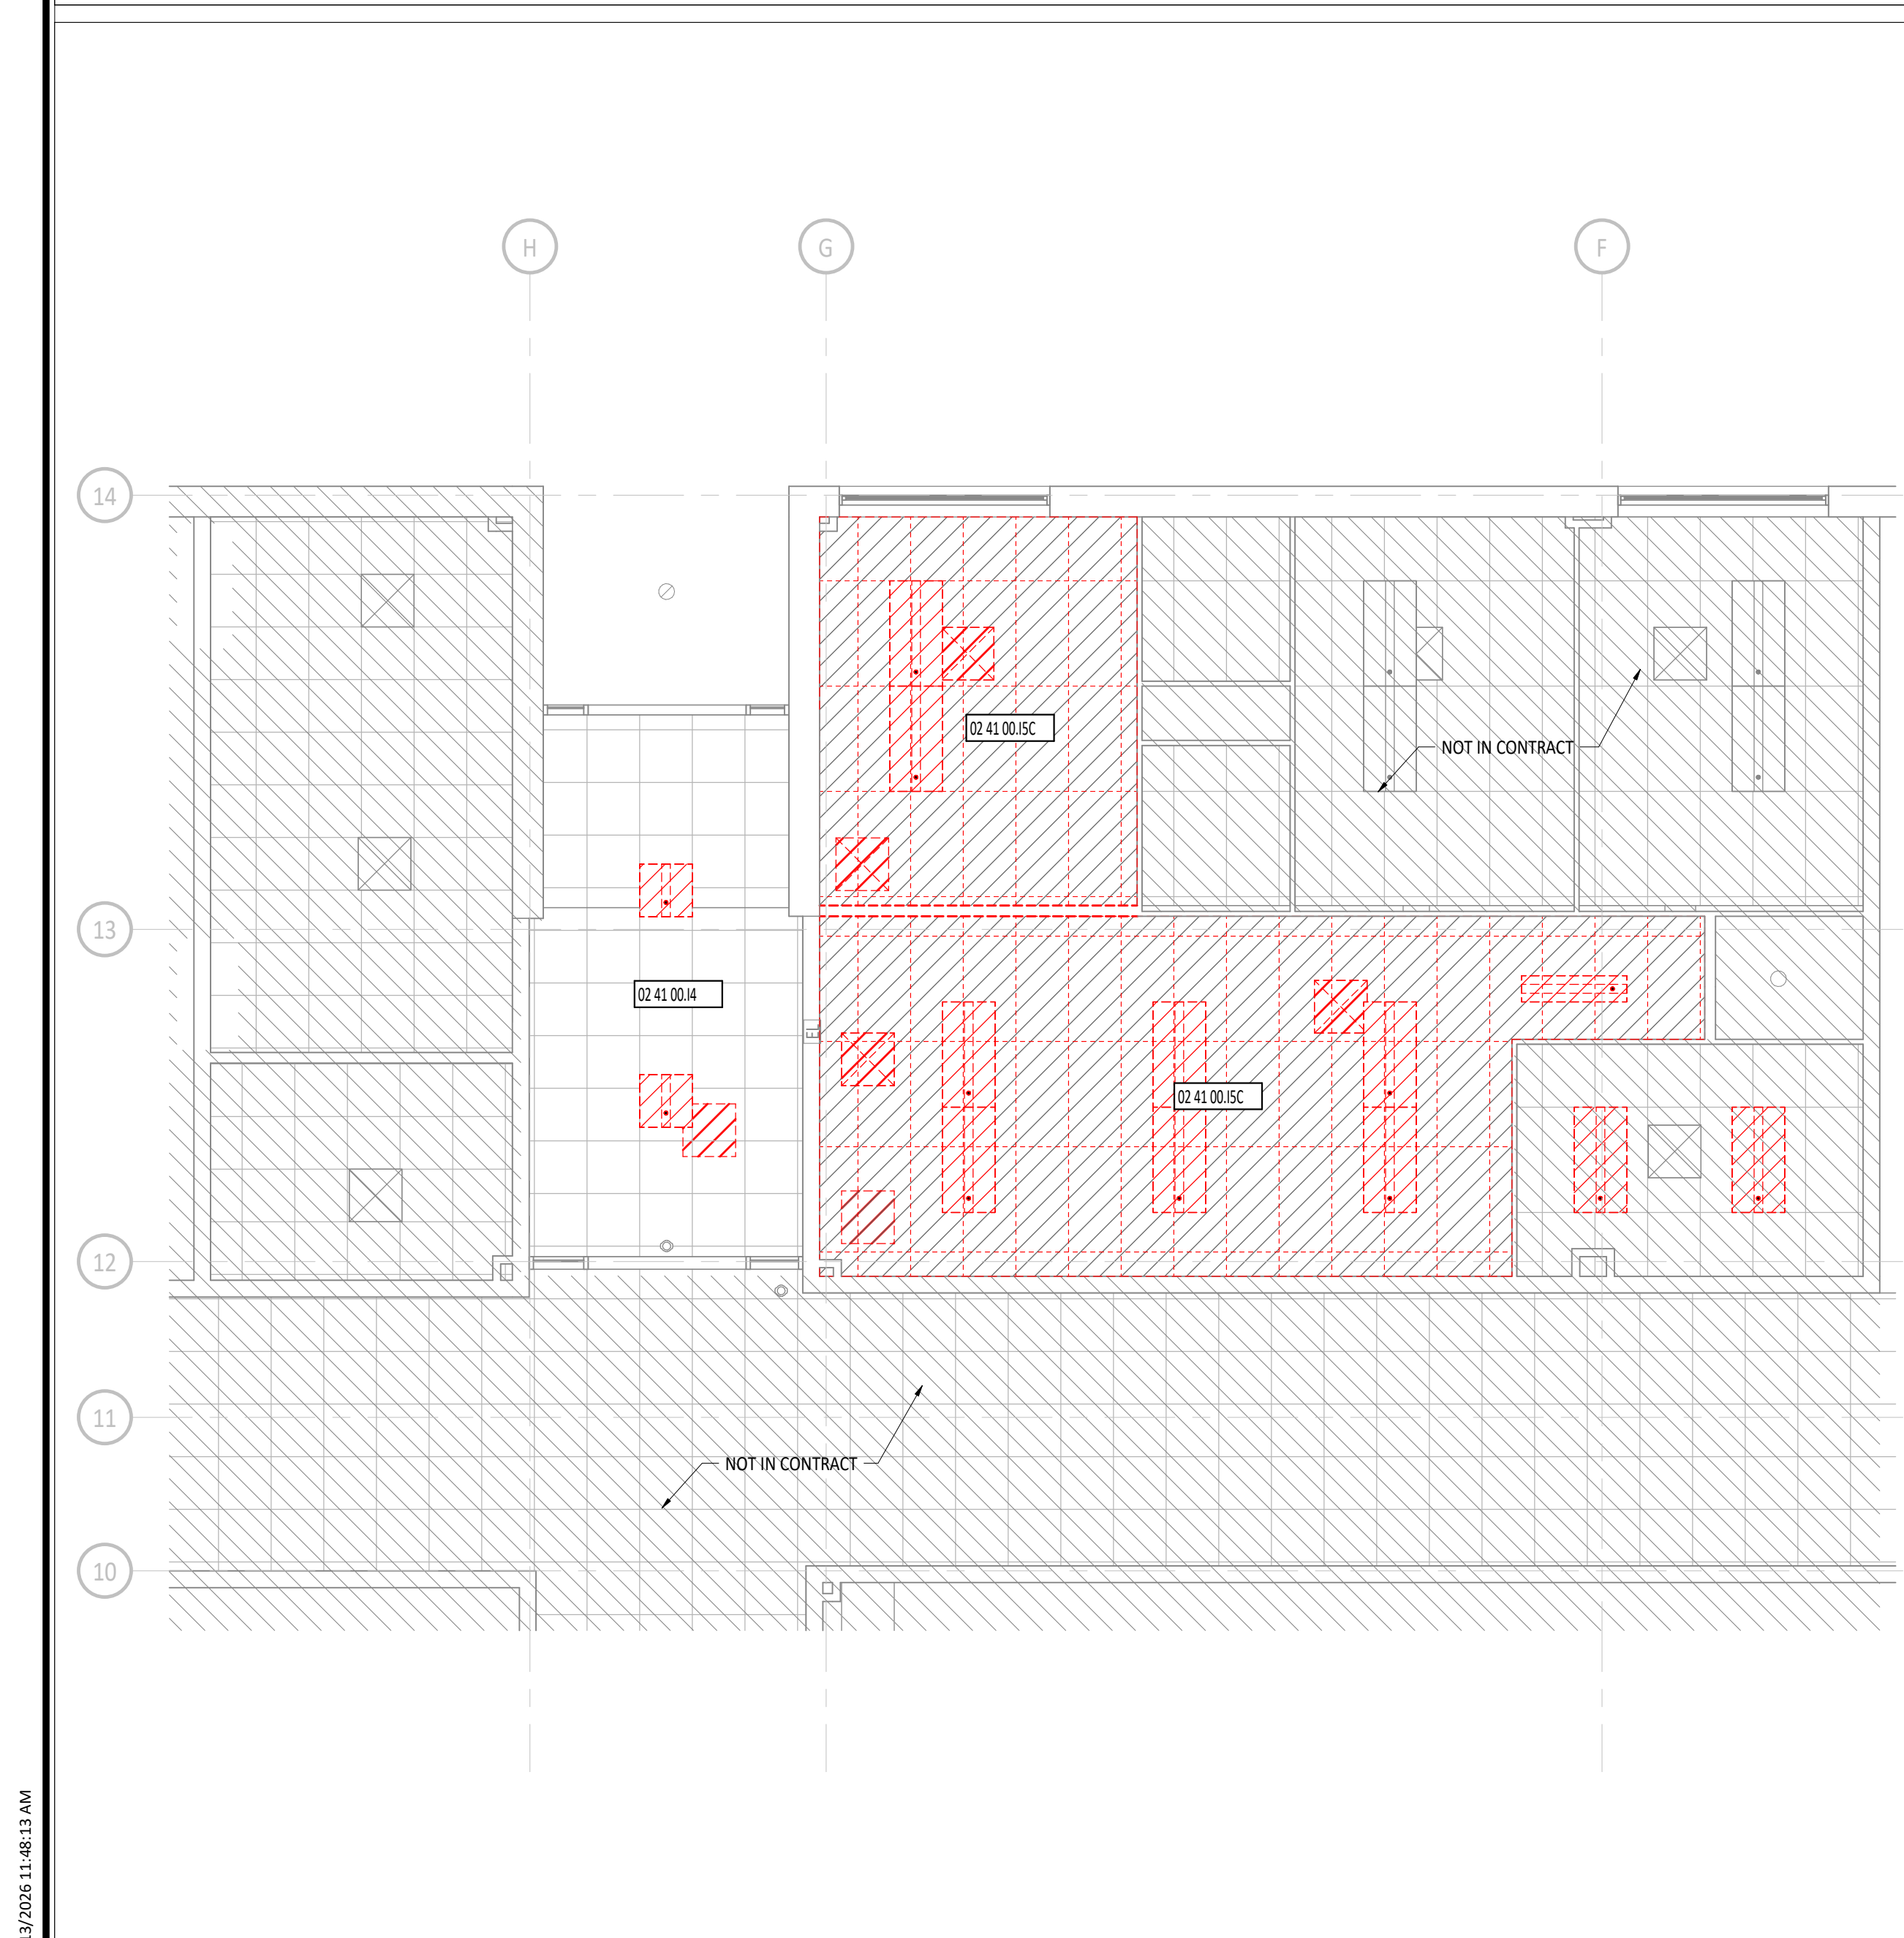


**6 FIRST FLOOR REFLECTED CEILING DEMOLITION PLAN**  
3/16" = 1'-0"

**3 FIRST FLOOR REFLECTED CEILING PLAN**  
3/16" = 1'-0"

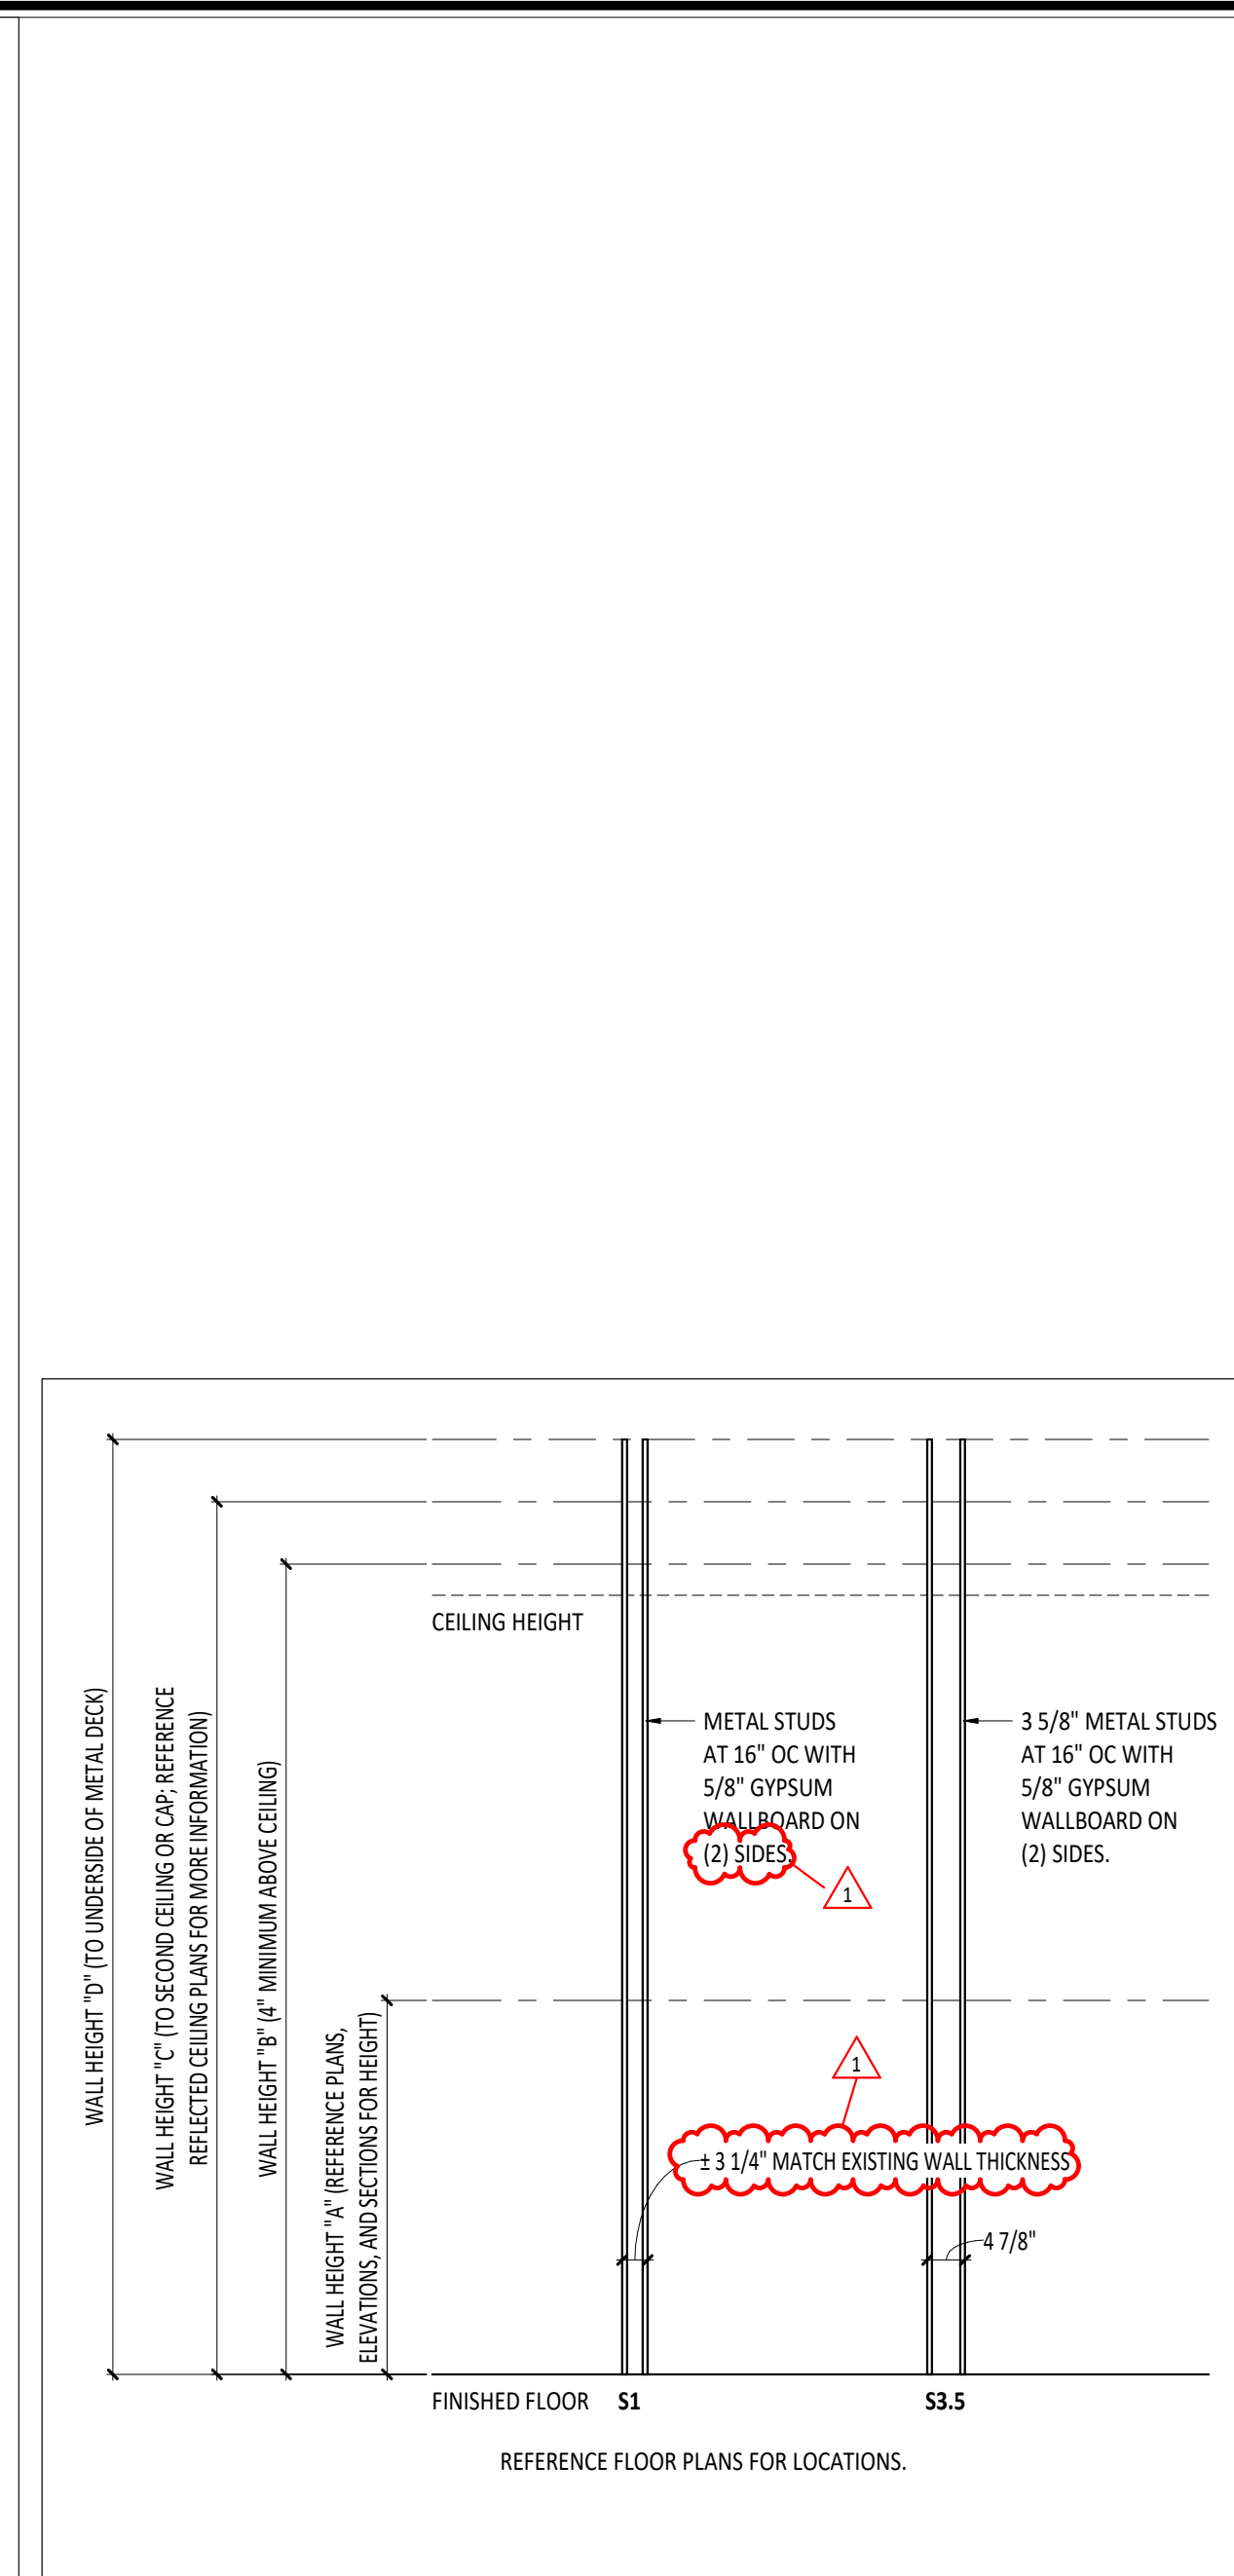

**STUD WALL TYPES (S)**  
NTS

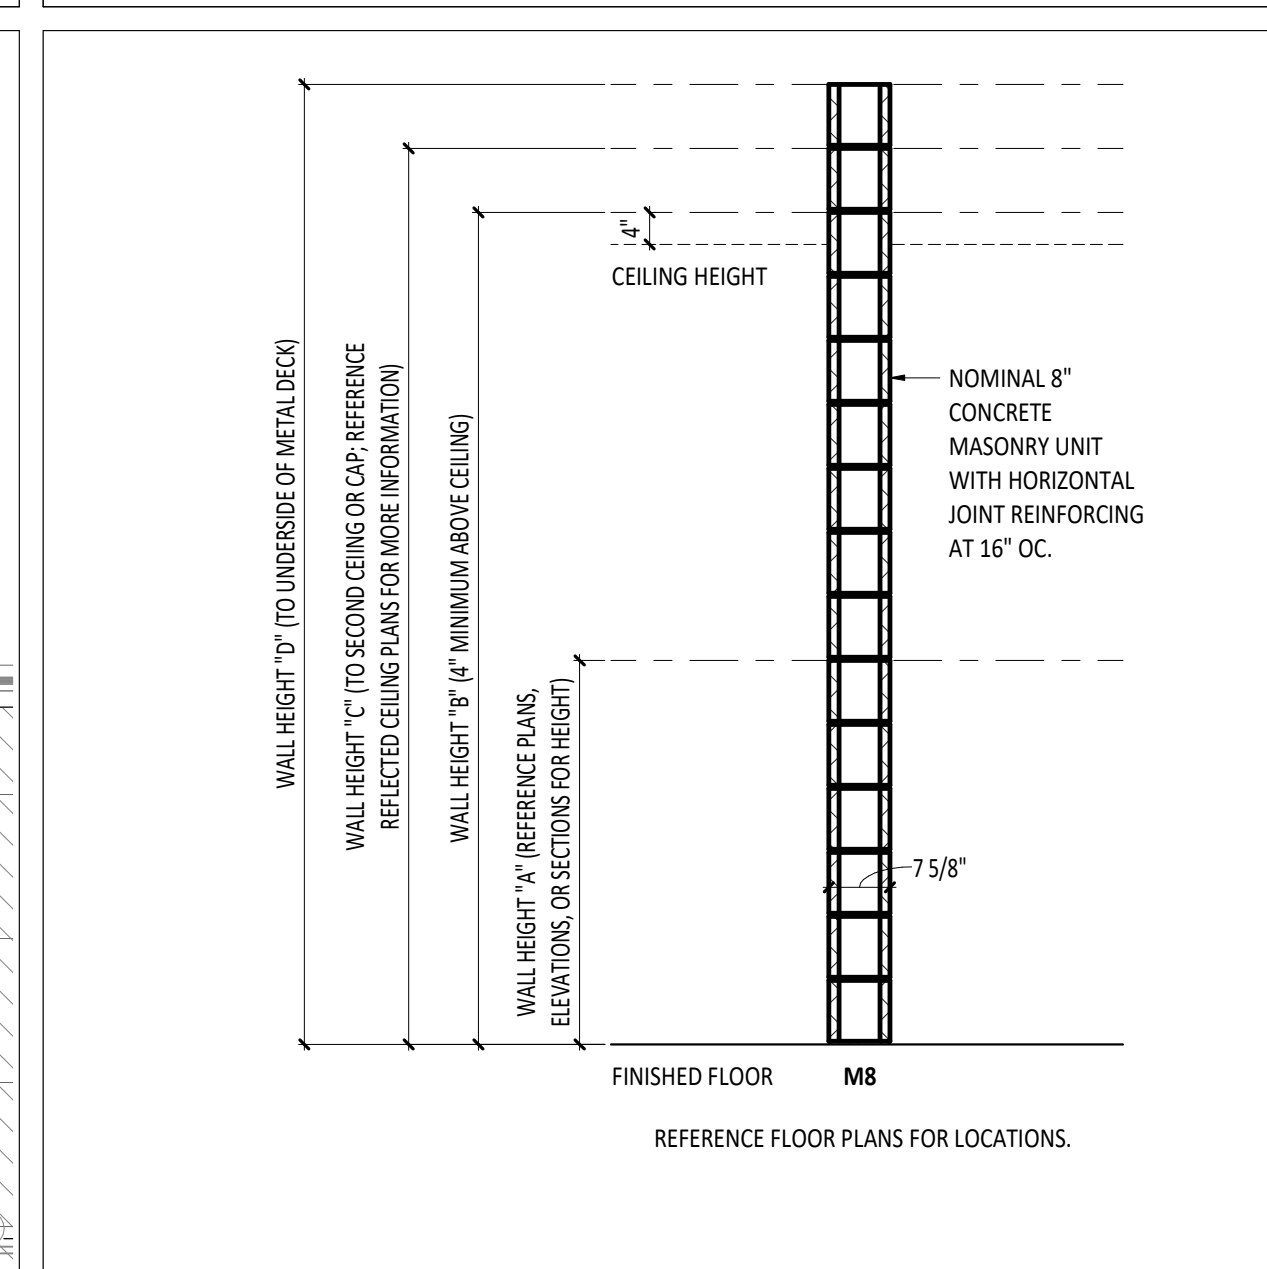

**CONCRETE MASONRY WALL TYPES (M)**  
NTS

CEILING SCHEDULE		
MARK	DESCRIPTION	NOTES
D	SALVAGED 2' x 4' SUSPENDED ACOUSTICAL PANEL CEILING TILES AND GRID REINSTALLED PER NEW LAYOUT. PAINT EXISTING GRID.	REFER TO SPEC SECTION 09 5100
EX	EXISTING CEILING TO REMAIN	

FIRST FLOOR PLAN ROOM INDEX - OVERALL				
ROOM NUMBER	ROOM NAME	ID	AREA	OCCUPANCY
109	STR		26 SF	
H101	VESTIBULE		71 SF	
H102	VESTIBULE		139 SF	
H103	CIRCULATION		153 SF	
H104	TOILET		35 SF	
H105	RECEPTION		178 SF	2
H106	TOILET		35 SF	
H107	NURSE		159 SF	2
H112	OFFICE		120 SF	1
H114	TECHNOLOGY		233 SF	2

- DEMOLITION FLOOR PLAN GENERAL NOTES**
- A THESE NOTES APPLY TO ALL ARCHITECTURAL DRAWINGS. FOR DEMOLITION NOTES AND SYMBOLS APPLICABLE ONLY TO DRAWINGS OF DISCIPLINE OTHER THAN ARCHITECTURAL, REFER TO CONTRACTOR'S START OF WORK IN SPECIFIED AREAS. WHERE PARTIAL OCCUPANCY, CONTRACTOR SHALL COORDINATE SCHEDULE WITH OWNER.
  - B FIELD VERIFY CONDITIONS AND COORDINATE DEMOLITION OR REMOVAL WORK WITH CORRESPONDING NEW CONSTRUCTION WORK AND WITH ALL APPROPRIATE TRADES PRIOR TO STARTING DEMOLITION WORK. IF DISCREPANCIES ARE FOUND BETWEEN CONTRACT DOCUMENTS AND ACTUAL FIELD CONDITIONS, NOTIFY ARCHITECT IMMEDIATELY.
  - C OWNER SHALL REMOVE LOOSE ITEMS, I.E. EQUIPMENT, FURNITURE, ARTWORK, PLACES, ETC., PRIOR TO CONTRACTOR'S START OF WORK IN SPECIFIED AREAS. WHERE PARTIAL OCCUPANCY, CONTRACTOR SHALL COORDINATE SCHEDULE WITH OWNER.
  - D REMOVE ITEMS TO BE DEMOLISHED IN THEIR ENTIRETY UNLESS OTHERWISE NOTED. DESCRIPTION OF PRIMARY ITEMS TO BE REMOVED IS BLOCKING, SUPPORTS, ANCHORS, TRIM, ADHESIVE, PIPING, WIRING, ETC., RELATED TO PRIMARY ITEMS SHALL BE INCLUDED.
  - E PROTECT EXISTING SURFACES TO REMAIN IN AREAS ADJACENT TO DEMOLITION WORK. CONTRACTOR TO REPAIR EXISTING SURFACES TO REMAIN DAMAGED DURING CONSTRUCTION AND DEMOLITION.
  - F PATCH EXISTING FLOOR, WALL, AND CEILING CONSTRUCTION AT ABANDONED PENETRATION LOCATIONS WITH NEW MATERIALS AS REQUIRED TO RECEIVE NEW FINISHES AND TO MAINTAIN ORIGINAL FIRE RATING ASSEMBLY WHERE APPLICABLE.
  - G SELECTIVE DEMOLITION FOR INSTALLATION OF NEW MECHANICAL, PLUMBING, OR ELECTRICAL WORK SHALL BE THE RESPONSIBILITY OF THE CONTRACTOR OR TRADE REQUIRING THE DEMOLITION.
  - H DEMOLISHED MATERIALS ARE THE PROPERTY OF THE CONTRACTOR UNLESS NOTED OTHERWISE AND SHALL BE PROMPTLY DISPOSED OFF SITE IN A LEGAL MANNER.
  - I REPAIR FINISHES AND SURFACES LEFT EXPOSED BY DEMOLITION OR REMOVAL OF EQUIPMENT USING NEW MATERIALS TO MATCH SURROUNDING SURFACES. REPAIR EXISTING FLOOR, BASE, WALL AND CEILING FINISHES TO CORRECT DEFECTS CAUSED OR EXPOSED BY DEMOLITION WORK OR EQUIPMENT REMOVAL. REPAIRED SURFACES SHALL BE SMOOTH AND UNDETECTABLE UNDER FINAL FINISHES. AREAS NOTED ON THE DWGS. TO BE REPAIRED OR PATCHED ARE GIVEN FOR REFERENCE AND SHALL NOT BE INTERPRETED TO LIMIT THE SCOPE OF WORK.
  - J DIMENSIONAL INFORMATION FOR NEW OPENINGS INDICATED ON DEMOLITION DWGS. ARE APPROXIMATE AND REQUIRE FIELD VERIFICATION AND COORDINATION WITH NEW CONSTRUCTION.
  - K PRIOR TO START OF DEMOLITION, DUST AND SOUND BARRIERS SHALL BE CONSTRUCTED.
  - L PROPER EGRESS AND APPROVED BARRIERS MUST BE MAINTAINED THROUGHOUT THE DEMOLITION AREA AT ALL TIMES.
  - M REMOVE DEBRIS DAILY.

- FLOOR PLAN GENERAL NOTES**
- A ALL DIMENSIONS ARE MEASURED TO THE FACE OF MASONRY OR THE FACE OF METAL STUD UNLESS NOTED OTHERWISE.
  - B ALL CMU CORNERS, HORIZONTAL OR VERTICAL, SHALL BE BULLNOSE UNLESS NOTED OR DETAILED OTHERWISE.
  - C INSTALL TREATED WOOD BLOCKING IN WALLS AS REQUIRED TO SECURE ALL EQUIPMENT, ACCESSORIES, HANDRAILS, CASEWORK, ETC. COORDINATE THIS WORK WITH ALL APPROPRIATE CONTRACTORS, SUPPLIERS AND MANUFACTURERS RECOMMENDATIONS.
  - D CAULK AT ALL CMU TO GYPSUM WALLBOARD WALLS.
  - E REFERENCE A0.3 FOR WALL TO DECK TERMINATION DETAILS.
  - F HINGE SIDE OF DOOR JAMB AT INTERSECTING WALLS TO BE LOCATED 4" FROM ADJACENT WALL UNLESS NOTED OTHERWISE - REFERENCE FLOOR PLANS.
  - G IF WALL TYPE IS NOT IDENTIFIED, WALL IS TO RUN FULL HEIGHT TO DECK.
  - H SAFETY GLAZING FILM TO EXTEND FROM FINISH FLOOR TO HEIGHT OF 7'-0" AFF MIN. OR NEAREST MULLION, WHICHEVER IS GREATER.

- REFLECTED CEILING PLAN GENERAL NOTES**
- D REFERENCE ELECTRICAL, MECHANICAL AND TECHNOLOGY DRAWINGS FOR MORE INFORMATION ON ALL CEILING MOUNTED DEVICES.
  - E EXPOSED CEILING / STRUCTURE TO BE PAINTED, UNLESS NOTED OTHERWISE.
  - F TRANSITION TO SQUARE CORNER AT CMU OPENING LOCATIONS WHERE BULKHEAD ALLIGNS WITH WALL.



- WALL TYPE GENERAL NOTES**
- B PROVIDE ACOUSTICAL SEALANT AT ALL JOINTS.
  - C PROVIDE DEFLECTION TRACK WHERE STUDS EXTEND TO THE BOTTOM OF STRUCTURE.
  - D PROVIDE FIRESTOPPING AT RATED WALLS - REFERENCE SPECIFICATION SECTION 07 84 00.

- WALL TYPE INFORMATION**
- WALL TYPE SYMBOL
  - WALL TYPE (REFERENCE PLAN AND TYPE DETAILS)
  - ADDITIONAL INFORMATION; SEE BELOW
  - FIRE/SMOKE RATING: 0,1,2,3, OR S (SMOKE)
  - WALL HEIGHT; REFERENCE WALL TYPE DETAILS

**ADDITIONAL INFORMATION**

- A = ACOUSTICAL BATT INSULATION
- FW = FIRE RATED WALL
- FB = FIRE BARRIER WALL
- G = GROUT WALL FULL

#	KEYNOTE DESCRIPTION
02 41 00.04	REMOVE PORTION OF EXISTING MASONRY UNIT WALL AS REQUIRED FOR NEW CONSTRUCTION. SALVAGE BRICK FOR RE-INSTALLATION.
02 41 00.02	REMOVE WOOD TRIM
02 41 00.01	REMOVE EXISTING DOOR AND FRAME
02 41 00.01	REMOVE EXISTING RESILIENT FLOORING AS REQUIRED FOR WALL DEMO OR NEW WALL CONSTRUCTION. REMOVE IN FULL TILE/PLANKS. PROTECT SURROUNDING FLOORING THAT IS EXISTING TO REMAIN DURING CONSTRUCTION, AND IF DAMAGED DURING CONSTRUCTION REPAIR/REPLACE AS REQUIRED.
02 41 00.04	REMOVE EXISTING ACOUSTICAL CEILING TILE AS REQUIRED FOR OTHER TRADES AND NEW CONSTRUCTION - REINSTALL CEILING
02 41 00.05C	REMOVE EXISTING ACOUSTICAL CEILING TILE AND GRID. SALVAGE TILE FOR RE-USE IN NEW WORK.
02 41 00.07	REMOVE PORTION OF EXISTING METAL STUD WALL
02 41 00.02	REMOVE EXISTING VINYL TEXTURED WALL COVERING AND CLEAN AND PREP SURFACE AS REQUIRED TO RECEIVE NEW FINISH
08 33 23.82	REMOVE EXISTING WINDOW FRAME SHUTTER
08 56 59.A	24" x 36" SERVICE AND TELLER WINDOW
08 80 00.D	SAFETY GLAZING FILM APPLIED TO EXISTING DOOR AND FRAME GLAZING
08 80 00.E	SAFETY GLAZING FILM APPLIED TO EXISTING GLAZING
11 99 13	PASS THRU DRAWER

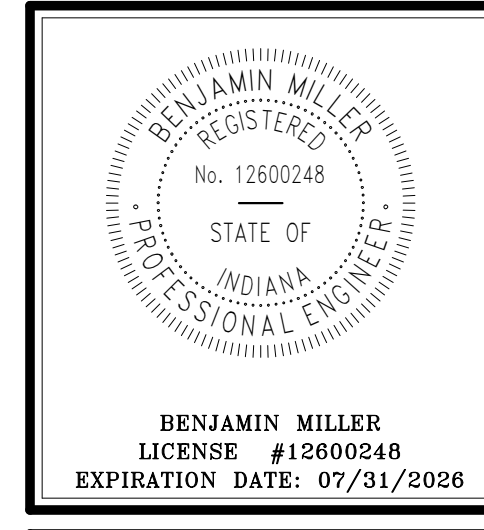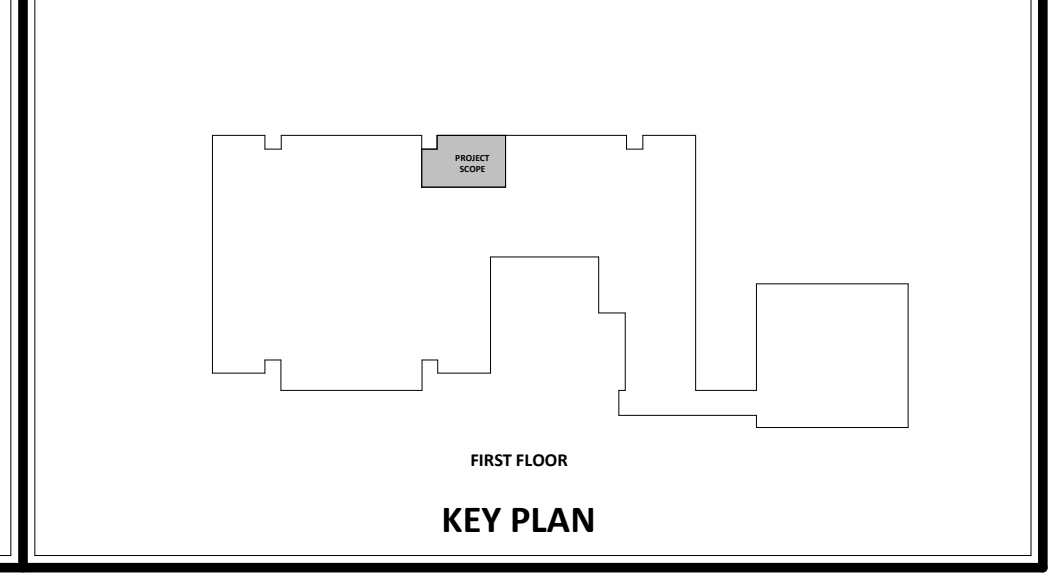


**JENNINGS COUNTY SCHOOL CORPORATION**  
**HAYDEN**  
 5550 86th, JAYTON, INDIANA 47535

ISSUANCES/REVISIONS	
CONSTRUCTION DOCUMENTS	03/26/2026
1 ADDENDUM #02	04/13/2026

PROJECT NUMBER:	DRAWN BY:	CHECKED BY:
25064	SMS	TAL

SHEET TITLE:  
**ARCHITECTURAL PLANS**

SHEET NUMBER:  
**H-A1.1**

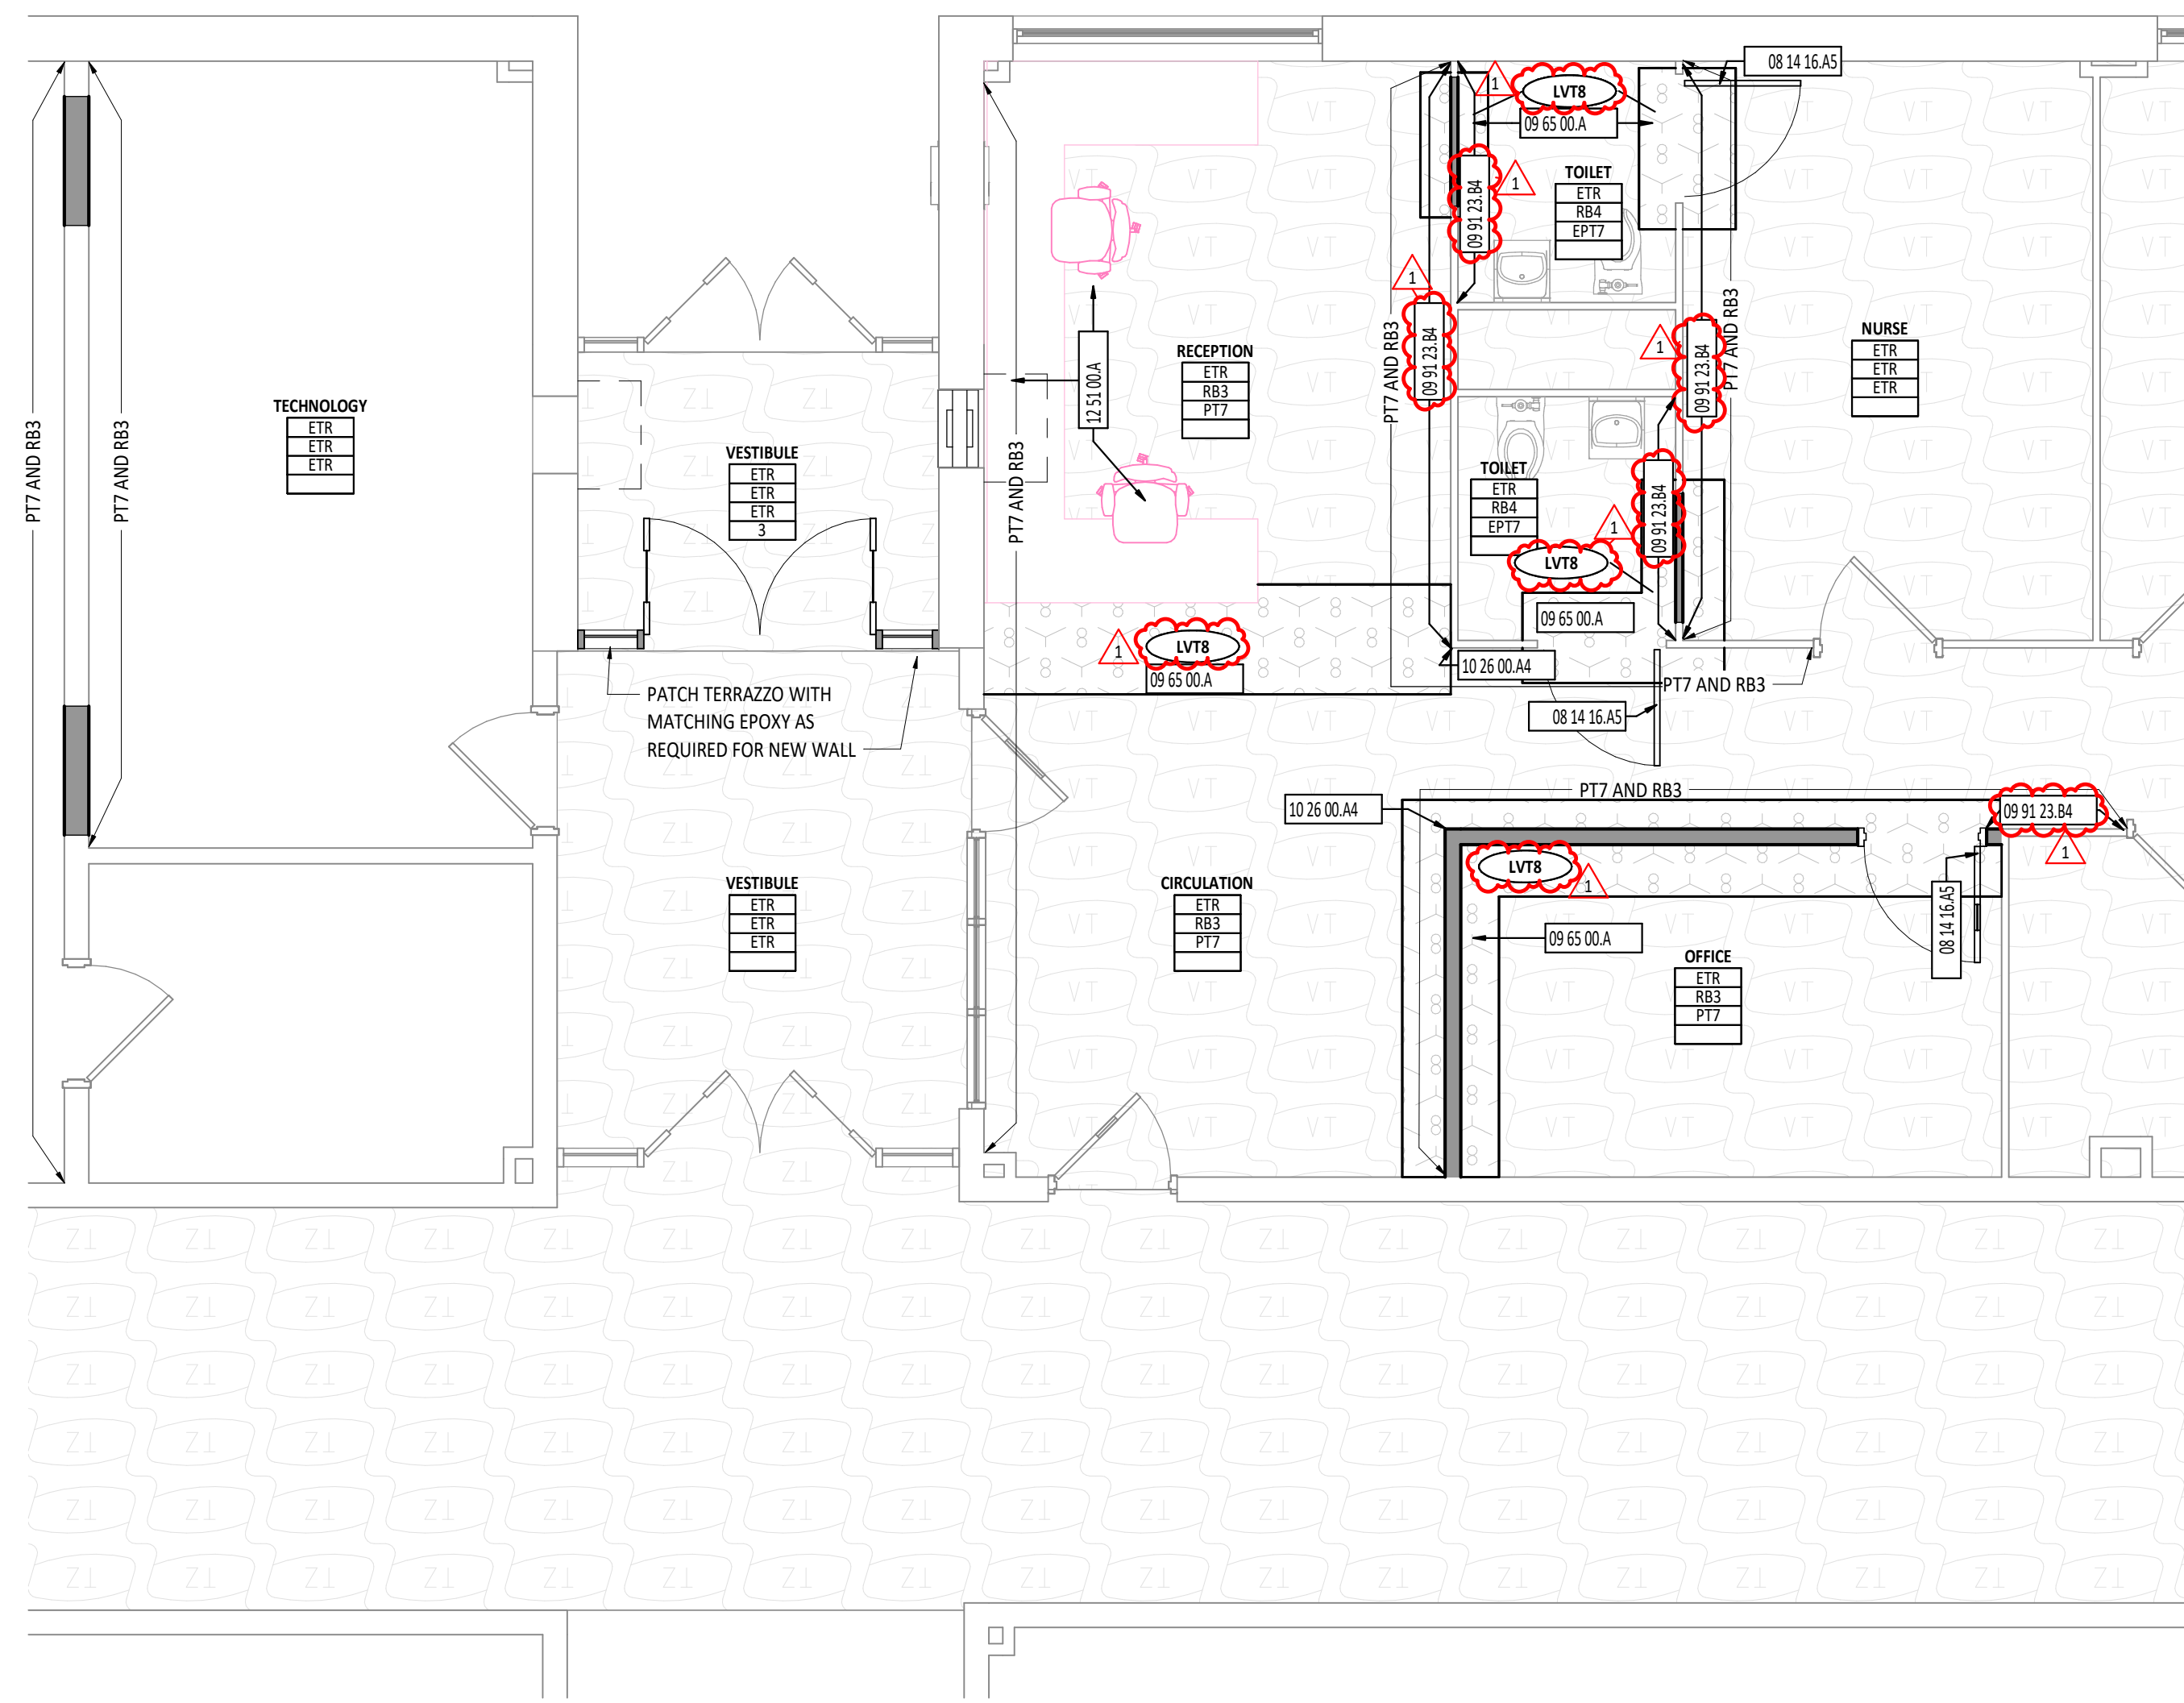

FINISH MATERIAL SCHEDULE						
NAME	MANUFACTURER	STYLE	NUMBER	COLOR	SIZE	COMMENTS
08 14 00 WOOD DOORS	FORTE	PLAIN SLICED RED OAK		DUSTY CANYON		DOORS TO BE STAINED TO MATCH EXISTING. VERIFY COLOR MATCH IN FIELD. ALL WOOD DOORS IN THIS BUILDING TO MATCH W04 UNLESS NOTED OTHERWISE.
09 51 00 ACOUSTICAL CEILINGS - SUSPENSION SYSTEM	ARMSTRONG	PRELUDE XL		WHITE	15/16" WIDE FACE	DOUBLE WEB CONSTRUCTION, CLASS 1 ZINC COATING, 8 GAUGE STEEL.
09 51 00 ACOUSTICAL CEILINGS - TILE					24" X 48"	SALVAGED FROM EXISTING TILES AND REINFILL AS NEEDED FOR NEW LAYOUT. USE WITH SUSPENSION SYSTEM A. CORRESPONDS WITH "TYPE D" ON REFLECTED CEILING PLAN.
09 65 00 RESILIENT FLOORING - LUXURY VINYL TILE	SHAW INDUSTRIES GROUP			TO MATCH EXISTING, VERIFY IN FIELD		LVT FLOORING TO MATCH EXISTING. FIND AND VERIFY MATCH IN FIELD.
09 65 13 RESILIENT BASE AND ACCESSORIES - RUBBER BASE	TARKETT/JOHNSONITE	BASEWORKS RUBBER BASE (TYPE TS)	TAB	WELSH CASTLE	4" COVE TOE	
	TARKETT/JOHNSONITE	BASEWORKS RUBBER BASE (TYPE TS)	TAB	WELSH CASTLE	6" COVE TOE	
09 91 23 PAINTING - EPOXY PAINT	SHERWIN WILLIAMS	REFER TO SPECIFICATIONS	SW 7029	AGREEABLE GRAY		COLOR INTENDED TO MATCH EXISTING. VERIFY COLOR MATCH IN FIELD. REFER TO SHERWIN WILLIAMS FILES FOR EXISTING COLOR.
09 91 23 PAINTING - PAINT	SHERWIN WILLIAMS	REFER TO SPECIFICATIONS	SW 7029	AGREEABLE GRAY		COLOR INTENDED TO MATCH EXISTING. VERIFY COLOR MATCH IN FIELD. REFER TO SHERWIN WILLIAMS FILES FOR EXISTING COLOR.
09 91 23 PAINTING - PAINT	SHERWIN WILLIAMS	REFER TO SPECIFICATIONS	SW7674	PEPPERCORN		PAINT FOR HOLLOW METAL DOOR FRAMES. COLOR INTENDED TO MATCH EXISTING DOOR FRAMES. VERIFY COLOR MATCH IN FIELD. REFER TO SPECIFICATIONS FOR SHEEN INFORMATION.
10 26 00 WALL AND DOOR PROTECTION - CORNER GUARD	ACROWN	SM-20N	927	FOLKSTONE	FULL WALL HEIGHT, 3" WINGS, 90 DEGREES	
12 36 00 COUNTERTOPS - PLASTIC LAMINATE	WILSONART	FIRE RATED LAMINATE, TYPE 605	1595-60	BLACK		MATTE FINISH


FIRST FLOOR PLAN ROOM INDEX - OVERALL				
ROOM NUMBER	ROOM NAME	ID	AREA	OCCUPANCY
109	STR		26 SF	
H101	VESTIBULE		71 SF	
H102	VESTIBULE		139 SF	
H103	CIRCULATION		153 SF	
H104	TOILET		35 SF	
H105	RECEPTION		178 SF	2
H106	TOILET		35 SF	
H107	NURSE		159 SF	2
H112	OFFICE		120 SF	1
H114	TECHNOLOGY		233 SF	2

**FLOOR FINISHES GENERAL NOTES**

- A FLOORING TRANSITIONS AND SEAMS AT DOOR SHALL OCCUR DIRECTLY UNDER THE CENTERLINE OF CLOSED DOOR UNLESS NOTED OTHERWISE.
- B FLOORING TRANSITIONS ARE TO BE EASED TO ACHIEVE A SMOOTH AND UNIFORM TRANSITION.
- C TRANSITION STRIPS ARE REQUIRED IN ALL INSTANCES WHERE A FLOOR MATERIAL TRANSITION OCCURS. REFER TO TYPICAL DETAILS ON SHEET A9.0 FOR ADDITIONAL INFORMATION.
- D FLOOR FINISHES SHALL EXTEND UNDER BUILT-IN COUNTER AND EQUIPMENT.
- E REFERENCE THE FINISH MATERIAL SCHEDULE FOR MANUFACTURERS, TYPES, AND COLOR SELECTIONS.
- F ALL BASE MATERIALS SHALL BE INSTALLED TIGHT TO FLOORING SURFACE.
- G REFER TO DIRECTIONAL ARROW ON FINISH FLOOR PLANS WHERE PROVIDED FOR FLOORING INSTALLATION INSTRUCTIONS.
- H WALL SUPPLY REGISTERS/GRILLES TO BE FIELD PAINTED TO MATCH ADJACENT WALL COLOR. REFERENCE SECTION 23 37 00 AND MECHANICAL DRAWINGS FOR ADDITIONAL INFORMATION.
- I EXPOSED CEILING / STRUCTURE TO BE PAINTED, UNLESS NOTED OTHERWISE.
- J ALL INTERIOR WALL FINISH TRANSITIONS SHOULD OCCUR AT AN INSIDE CORNER, IF A MATERIAL OR COLOR CHANGE OCCURS AT AN OUTSIDE CORNER, CONTRACTOR SHALL BRING THIS TO THE ATTENTION OF THE ARCHITECT FOR CLARIFICATION.
- K PRIOR TO FLOORING INSTALLATION, VERIFY SUBFLOOR CONDITIONS MEET MANUFACTURER'S STANDARD REQUIREMENTS.

#	KEYNOTE DESCRIPTION
08 14 16.A5	ALL NEW WOOD DOORS IN THIS BUILDING TO MATCH W04 FINISH UNLESS NOTED OTHERWISE.
09 65 00.1	PATCH AND INFILL LVT FLOORING AS REQUIRED FROM WALL REWORK. INFILL IN FULL PLANS MATCH EXISTING INSTALLATION PATTERNS AND DIRECTION.
09 91 23.B4	PROVIDE SKIM COAT AS REQUIRED FROM WALL COVERING REMOVAL TO PREP WALL AND PROVIDE SMOOTH, CLEAN FINISH.
10 26 00.A4	CORNER GUARD, CO. REFER TO FINISH MATERIAL SCHEDULE.
12 36 00.A	OWNER PROVIDED LOOSE FURNISHINGS SHOWN IN LIGHT PINK LINE WORK

**FINISH TAG LEGEND**

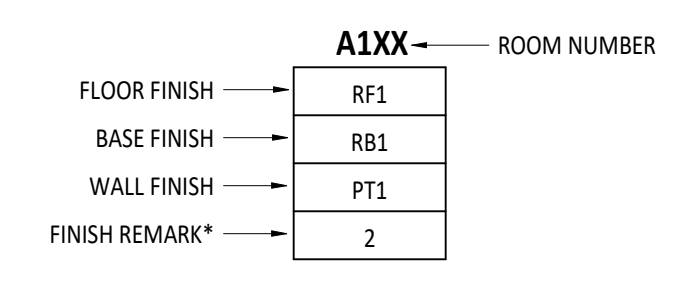


\*REMARKS NUMBERS COORDINATE WITH "INTERIOR FINISH REMARKS" NOTES LEGEND ABOVE  
 MATERIALS NOTED IN FINISH TAG SHOULD BE CONSIDERED THE OVERALL FINISHES IN THE ROOM MARKED UNLESS NOTED OTHERWISE WITH KEYNOTES ON FINISH PLAN OR INTERIOR ELEVATIONS.





**INTERIOR FINISH REMARKS**

1. MULTIPLE WALL FINISHES IN THIS ROOM. REFER TO INFORMATION NOTED ON FINISH PLANS AND INTERIOR ELEVATIONS.
2. MULTIPLE FLOOR FINISHES IN THIS ROOM. REFER TO NOTED INFORMATION ON FINISH PLANS.
3. EXISTING BRICK IN THIS ROOM TO REMAIN UNPAINTED.

**FLOOR FINISH MATERIAL LEGEND**

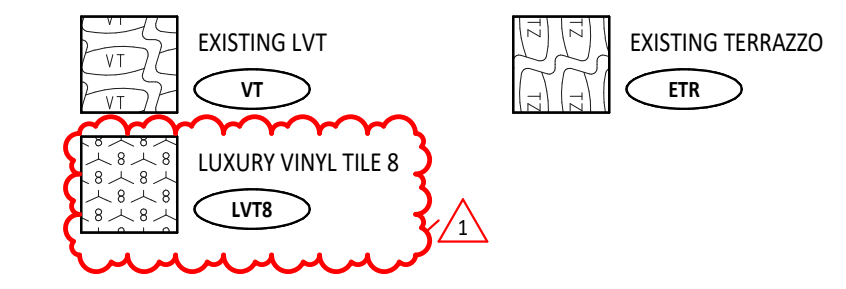

**1**  
 H-A9.1  
**FIRST FLOOR FINISH PLAN**  
 1/4" = 1'-0"

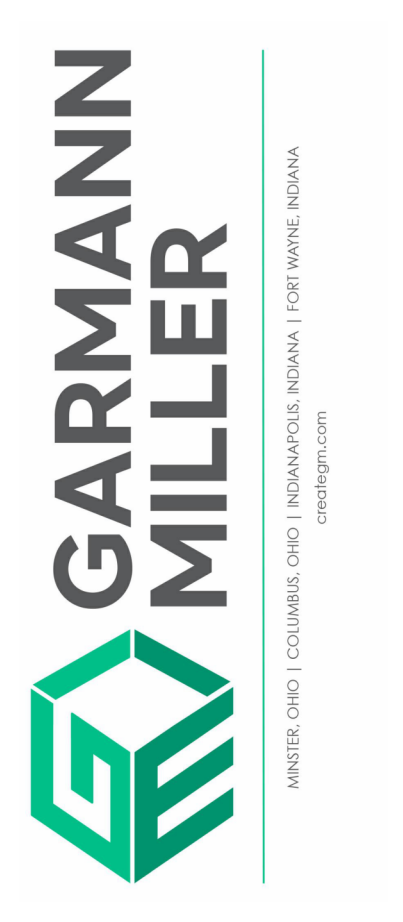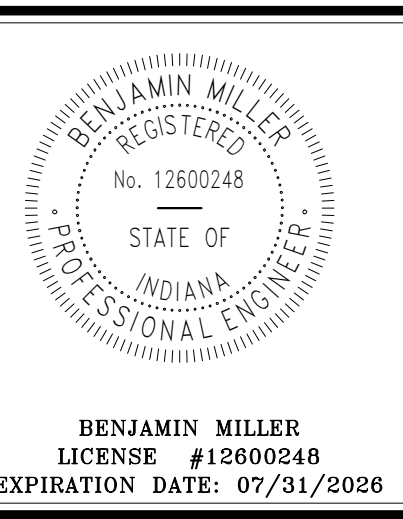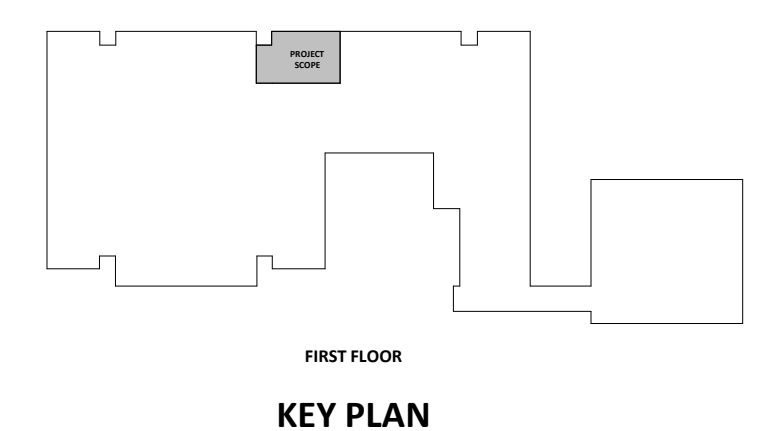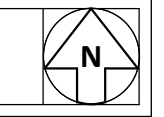


**JENNINGS COUNTY SCHOOL CORPORATION**  
**HAYDEN**

ISSUANCES/REVISIONS	
CONSTRUCTION DOCUMENTS	03/26/2026
1 ADDENDUM #02	04/13/2026


PROJECT NUMBER:	DRAWN BY:	CHECKED BY:
25064	CEO	HEF

SHEET TITLE:  
**FIRST FLOOR FINISHES PLAN**

SHEET NUMBER:  
**H-A9.1**

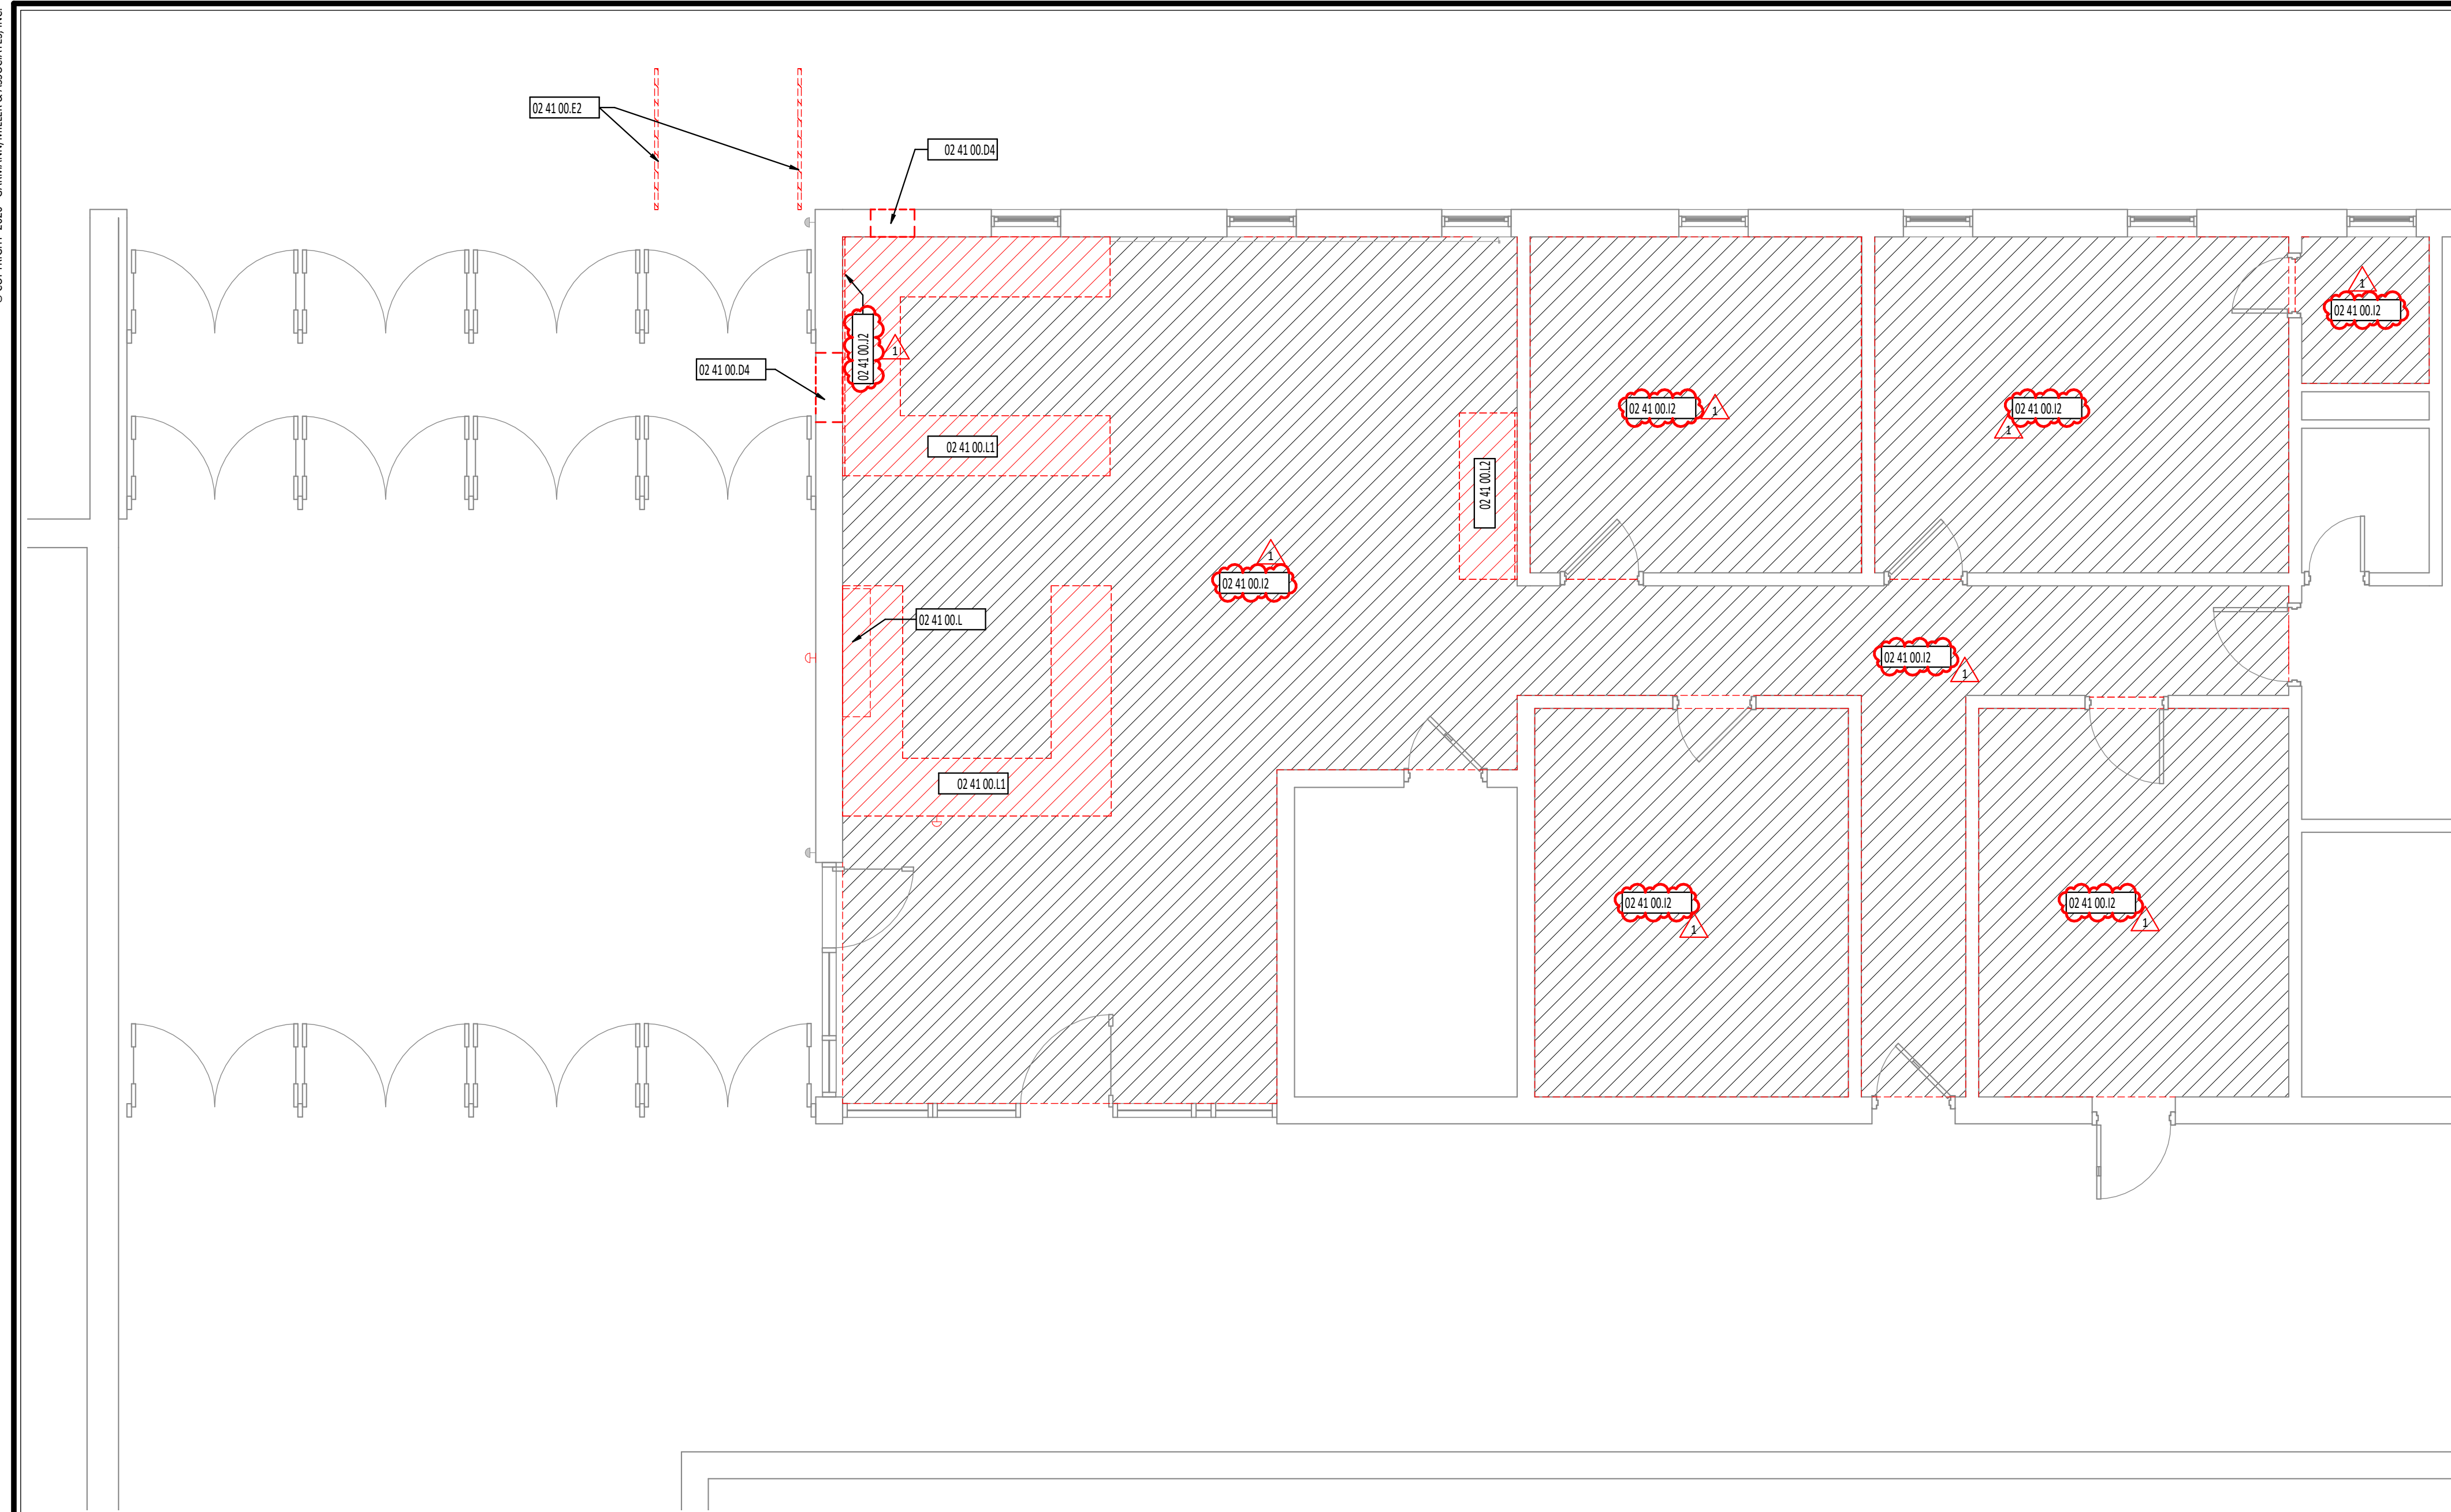

**1 FIRST FLOOR DEMOLITION PLAN**  
1/4" = 1'-0"

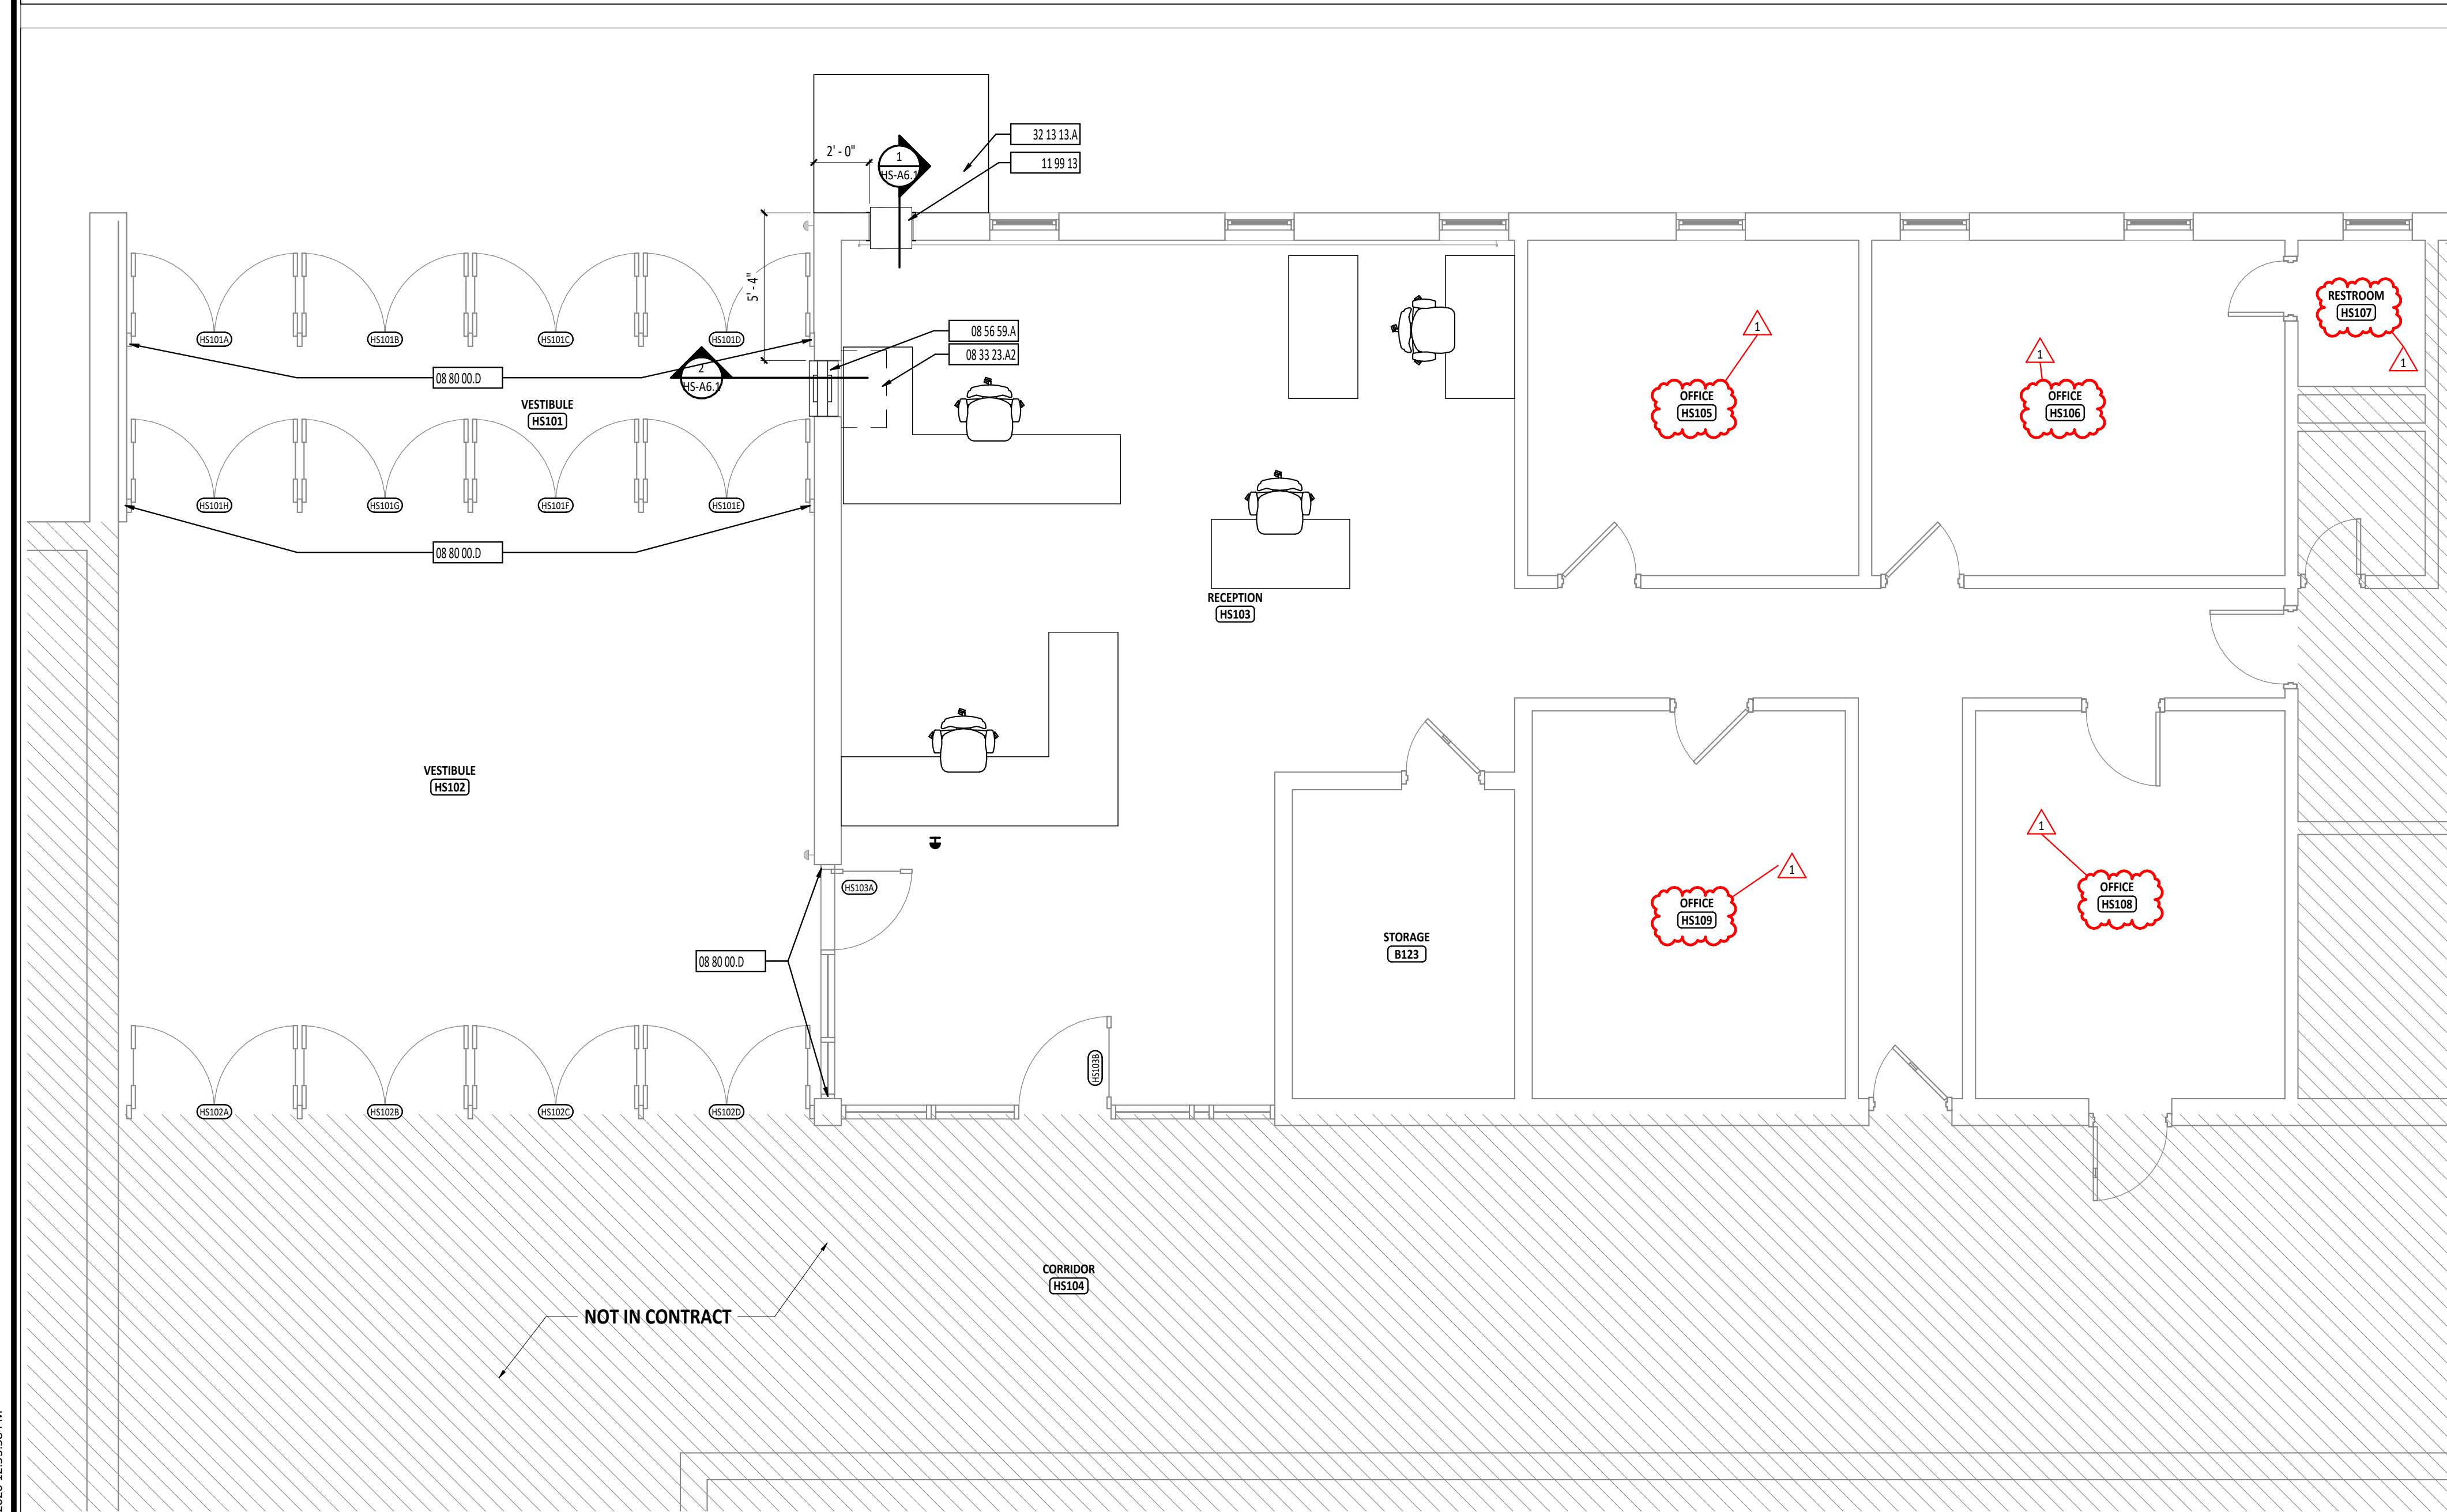

**2 FIRST FLOOR PLAN**  
1/4" = 1'-0"

FIRST FLOOR PLAN ROOM INDEX - OVERALL				
ROOM NUMBER	ROOM NAME	ID	AREA	OCCUPANCY
B123	STORAGE		90 SF	0
B129	WAITING		189 SF	2
B132	HEALTH		497 SF	5
HS101	VESTIBULE		149 SF	
HS102	VESTIBULE		551 SF	
HS103	RECEPTION		817 SF	8
HS104	CORRIDOR		1,348 SF	
HS105	OFFICE		145 SF	
HS106	OFFICE		181 SF	
HS107	RESTROOM		24 SF	
HS108	OFFICE		157 SF	
HS109	OFFICE		159 SF	

- DEMOLITION FLOOR PLAN GENERAL NOTES**
- A THESE NOTES APPLY TO ALL ARCHITECTURAL DRAWINGS. FOR DEMOLITION NOTES AND SYMBOLS APPLICABLE ONLY TO DRAWINGS OF DISCIPLINE OTHER THAN ARCHITECTURAL, REFER TO SPECIFIC DRAWINGS OF THAT GENERAL DEMOLITION NOTES DISCIPLINE.
  - B FIELD VERIFY CONDITIONS AND COORDINATE DEMOLITION OR REMOVAL WORK WITH CORRESPONDING NEW CONSTRUCTION WORK AND WITH ALL APPROPRIATE TRADES PRIOR TO STARTING DEMOLITION WORK. IF DISCREPANCIES ARE FOUND BETWEEN CONTRACT DOCUMENTS AND ACTUAL FIELD CONDITIONS, NOTIFY ARCHITECT IMMEDIATELY.
  - C OWNER SHALL REMOVE LOOSE ITEMS, I.E. EQUIPMENT, FURNITURE, ARTWORK, PLACES, ETC. PRIOR TO CONTRACTOR'S START OF WORK IN SPECIFIED AREAS. WHERE PARTIAL OCCUPANCY, CONTRACTOR SHALL COORDINATE SCHEDULE WITH OWNER.
  - D REMOVE ITEMS TO BE DEMOLISHED IN THEIR ENTIRETY UNLESS OTHERWISE NOTED. DESCRIPTION OF PRIMARY ITEMS TO BE REMOVED IS GENERAL IN NATURE, AND REMOVAL OF SECONDARY COMPONENTS SUCH AS BLOCKING, SUPPORTS, ANCHORS, TRIM, ADHESIVE, PIPING, WIRING, ETC., RELATED TO PRIMARY ITEMS SHALL BE INCLUDED.
  - E PROTECT EXISTING SURFACES TO REMAIN IN AREAS ADJACENT TO DEMOLITION WORK. CONTRACTOR TO REPAIR EXISTING SURFACES TO REMAIN DAMAGED DURING CONSTRUCTION AND DEMOLITION.
  - F PATCH EXISTING FLOOR, WALL, AND CEILING CONSTRUCTION AT ABANDONED PENETRATION LOCATIONS WITH NEW MATERIALS AS REQUIRED TO RECEIVE NEW FINISHES AND TO MAINTAIN ORIGINAL FIRE RATING ASSEMBLY WHERE APPLICABLE.
  - G SELECTIVE DEMOLITION FOR INSTALLATION OF NEW MECHANICAL, PLUMBING, OR ELECTRICAL WORK SHALL BE THE RESPONSIBILITY OF THE CONTRACTOR OR TRADE REQUIRING THE DEMOLITION.
  - H DEMOLISHED MATERIALS ARE THE PROPERTY OF THE CONTRACTOR UNLESS NOTED OTHERWISE AND SHALL BE PROMPTLY DISPOSED OFF SITE IN A LEGAL MANNER.
  - I REPAIR FINISHES AND SURFACES LEFT EXPOSED BY DEMOLITION OR REMOVAL OF EQUIPMENT USING NEW MATERIALS TO MATCH SURROUNDING SURFACES. REPAIR EXISTING FLOOR, BASE, WALL AND CEILING FINISHES TO CORRECT DEFECTS CAUSED OR EXPOSED BY DEMOLITION WORK OR EQUIPMENT REMOVAL. REPAIRED SURFACES SHALL BE SMOOTH AND UNDETECTABLE UNDER FINAL FINISHES. AREAS NOTED ON THE DWGS. TO BE REPAIRED OR PATCHED ARE GIVEN FOR REFERENCE AND SHALL NOT BE INTERPRETED TO LIMIT THE SCOPE OF WORK.
  - J DIMENSIONAL INFORMATION FOR NEW OPENINGS INDICATED ON DEMOLITION DWGS. ARE APPROXIMATE AND REQUIRE FIELD VERIFICATION AND COORDINATION WITH NEW CONSTRUCTION.
  - K PRIOR TO START OF DEMOLITION, DUST AND SOUND BARRIERS SHALL BE CONSTRUCTED.
  - L PROPER EGRESS AND APPROVED BARRIERS MUST BE MAINTAINED THROUGHOUT THE DEMOLITION AREA AT ALL TIMES.
  - M REMOVE DEBRIS DAILY.

- FLOOR PLAN GENERAL NOTES**
- A ALL DIMENSIONS ARE MEASURED TO THE FACE OF MASONRY OR THE FACE OF METAL STUD UNLESS NOTED OTHERWISE.
  - B ALL CMU CORNERS, HORIZONTAL OR VERTICAL, SHALL BE BULLNOSE UNLESS NOTED OR DETAILED OTHERWISE.
  - C INSTALL TREATED WOOD BLOCKING IN WALLS AS REQUIRED TO SECURE ALL EQUIPMENT, ACCESSORIES, HANDRAILS, CASEWORK, ETC. COORDINATE THIS WORK WITH ALL APPROPRIATE CONTRACTORS, SUPPLIERS AND MANUFACTURERS RECOMMENDATIONS.
  - D CAULK AT ALL CMU TO GYPSUM WALLBOARD WALLS.
  - E REFERENCE A0.3 FOR WALL TO DECK TERMINATION DETAILS.
  - F HINGE SIDE OF DOOR JAMB AT INTERSECTING WALLS TO BE LOCATED 4" FROM ADJACENT WALL UNLESS NOTED OTHERWISE - REFERENCE FLOOR PLANS.
  - G IF WALL TYPE IS NOT IDENTIFIED, WALL IS TO RUN FULL HEIGHT TO DECK.
  - H SAFETY GLAZING FILM TO EXTEND FROM FINISH FLOOR TO HEIGHT OF 7'-0" AFF MIN. OR NEAREST MULLION, WHICHEVER IS GREATER.

- REFLECTED CEILING PLAN GENERAL NOTES**
- D REFERENCE ELECTRICAL, MECHANICAL AND TECHNOLOGY DRAWINGS FOR MORE INFORMATION ON ALL CEILING MOUNTED DEVICES.
  - E EXPOSED CEILING / STRUCTURE TO BE PAINTED, UNLESS NOTED OTHERWISE.
  - F TRANSITION TO SQUARE CORNER AT CMU OPENING LOCATIONS WHERE BULKHEAD ALLIGNS WITH WALL.

CEILING SCHEDULE		
MARK	DESCRIPTION	NOTES
	2' x 4' SUSPENDED ACOUSTICAL PANEL CEILING	REFER TO SPEC. SECTION 09 5100

#	KEYNOTE DESCRIPTION
02 41 00.04	REMOVE PORTION OF EXISTING MASONRY UNIT WALL AS REQUIRED FOR NEW CONSTRUCTION. SALVAGE BRICK FOR RE-INSTALLATION.
02 41 00.07	REMOVE EXISTING HANDRAIL.
02 41 00.12	REMOVE EXISTING RESILIENT FLOORING AND BASE
02 41 00.12	REMOVE EXISTING TACKBOARD. RETURN TO OWNER. CLEAN AND PREP WALL AS REQUIRED TO RECEIVE NEW FINISH.
02 41 00.1	Division 12 - Demolition
02 41 00.11	REMOVE EXISTING RECEPTION DESK AND CASEWORK
02 41 00.12	REMOVE EXISTING COUNTERTOP AND ALL SUPPORTS AND ACCESSORIES. PATCH WALL AS REQUIRED.
08 33 23.A2	FIRE-RATED OVERHEAD COILING DOOR WITH HOUSING
08 56 59.A	1/4" x 3/8" SERVICE AND TELLER WINDOW
08 80 00.D	SAFETY GLAZING FILM APPLIED TO EXISTING DOOR AND FRAME GLAZING
11 99 13	PASS THRU DRAWER
32 13 13.A	EXTERIOR CONCRETE SLAB-ON-GRADE - REFERENCE CIVIL/LANDSCAPE DRAWINGS.

**ISSUANCES/REVISIONS**


CONSTRUCTION DOCUMENTS	DATE
1	03/26/2026
1	04/13/2026

PROJECT NUMBER: 25064 | DRAWN BY: SRS | CHECKED BY: TAL

SHEET TITLE: ARCHITECTURAL PLANS

SHEET NUMBER: HS-A1.1

KEY PLAN

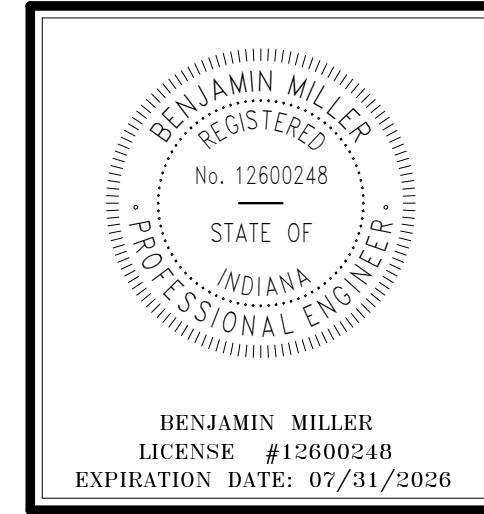


**JENNINGS COUNTY SCHOOL CORPORATIONS**  
**HIGH SCHOOL**  
 800 W WALNUT STREET, INDIANAPOLIS, INDIANA 46205


PROJECT NUMBER: 25064 | DRAWN BY: SRS | CHECKED BY: TAL

SHEET TITLE: ARCHITECTURAL PLANS

SHEET NUMBER: HS-A1.1

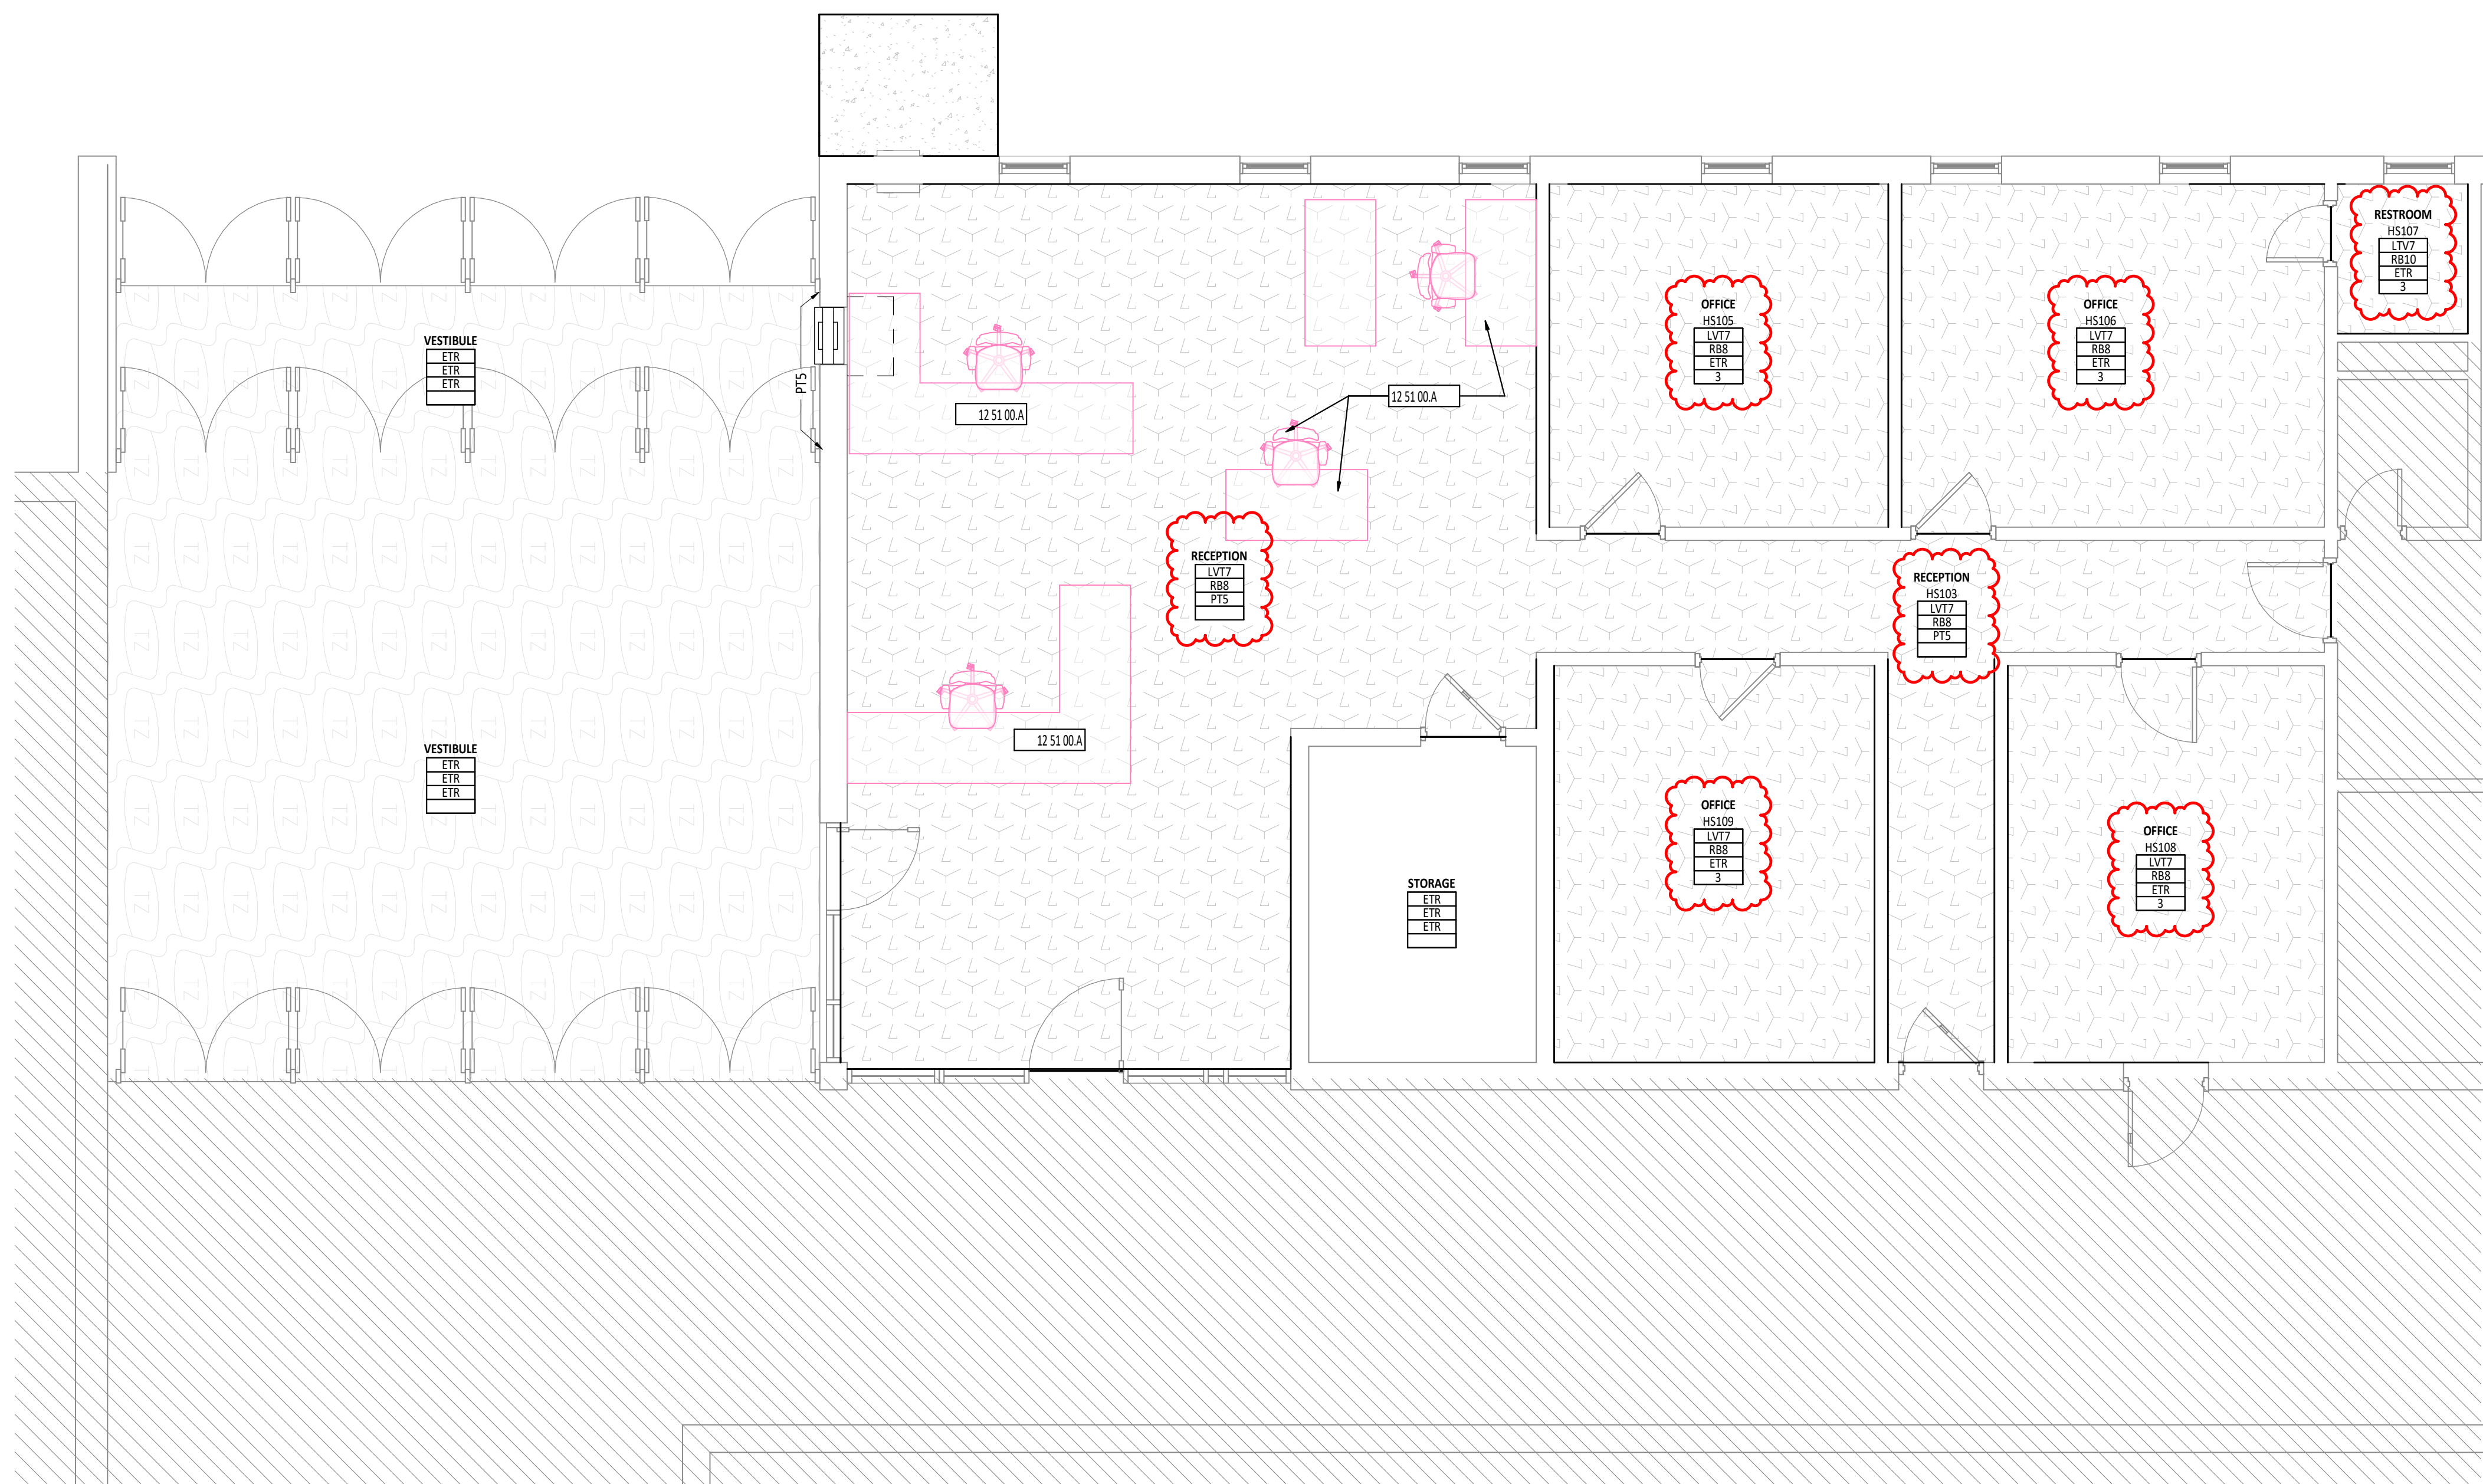

FINISH MATERIAL SCHEDULE						
NAME	MANUFACTURER	STYLE	NUMBER	COLOR	SIZE	COMMENTS
09 65 00 RESILIENT FLOORING - LUXURY VINYL TILE						
LV7	PATCRAFT	TIMBER GROVE II 20 MIL	1421V-07003	PERGOLA		
09 65 13 RESILIENT BASE AND ACCESSORIES - RUBBER BASE						
RB8	TARKETT/JOHNSONITE	BASEWORKS TYPE T5	80	FAWN	1" COVE TCE	
RB10	TARKETT/JOHNSONITE	BASEWORKS TYPE T5	80	FAWN	6" COVE TCE	
09 91 23 PAINTING - PAINT						
P15	SHERWIN WILLIAMS	REFER TO SPECIFICATIONS	SW757	HIGH REFLECTIVE WHITE		COLOR TO MATCH EXISTING. VERIFY COLOR MATCH IN FIELD. REFER TO SHERWIN WILLIAMS FILES FOR EXISTING COLOR INFORMATION. REFER TO SPECIFICATIONS FOR SHEEN INFORMATION.
12 36 00 COUNTER TOPS - PLASTIC LAMINATE						
L73	WILSONART	FIRE RATED LAMINATE TYPE 605	1595-60	BLACK		MATTE FINISH

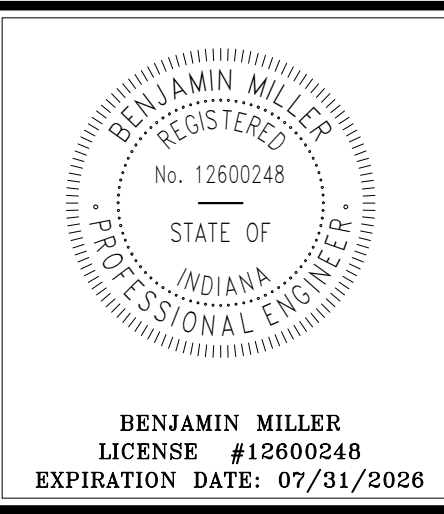

#	KEYNOTE DESCRIPTION
10 73	FIXED METAL AWNING
13.13.A	
12.51.00.A	OWNER PROVIDED LOOSE FURNISHINGS SHOWN IN LIGHT PINK LINE WORK

FIRST FLOOR PLAN ROOM INDEX - OVERALL				
ROOM NUMBER	ROOM NAME	ID	AREA	OCCUPANCY
B123	STORAGE		90 SF	0
B129	WAITING		189 SF	2
B132	HEALTH		497 SF	5
HS101	VESTIBULE		149 SF	
HS102	VESTIBULE		551 SF	
HS103	RECEPTION		817 SF	8
HS104	CORRIDOR		1,349 SF	
HS105	OFFICE		145 SF	
HS106	OFFICE		181 SF	
HS107	RESTROOM		24 SF	
HS108	OFFICE		157 SF	
HS109	OFFICE		199 SF	

- FLOOR FINISHES GENERAL NOTES**
- A FLOORING TRANSITIONS AND SEAMS AT DOOR SHALL OCCUR DIRECTLY UNDER THE CENTERLINE OF CLOSED DOOR UNLESS NOTED OTHERWISE.
  - B FLOORING TRANSITIONS ARE TO BE EASED TO ACHIEVE A SMOOTH AND UNIFORM TRANSITION.
  - C TRANSITION STRIPS ARE REQUIRED IN ALL INSTANCES WHERE A FLOOR MATERIAL TRANSITION OCCURS. REFER TO TYPICAL DETAILS ON SHEET A9.0 FOR ADDITIONAL INFORMATION.
  - D FLOOR FINISHES SHALL EXTEND UNDER BUILT-IN COUNTER AND EQUIPMENT.
  - E REFERENCE THE FINISH MATERIAL SCHEDULE FOR MANUFACTURERS, TYPES, AND COLOR SELECTIONS.
  - F ALL BASE MATERIALS SHALL BE INSTALLED TIGHT TO FLOORING SURFACE.
  - G REFER TO DIRECTIONAL ARROW ON FINISH FLOOR PLANS WHERE PROVIDED FOR FLOORING INSTALLATION INSTRUCTIONS.
  - H WALL SUPPLY REGISTERS/GRILLES TO BE FIELD PAINTED TO MATCH ADJACENT WALL COLOR. REFERENCE SECTION 23 37 00 AND MECHANICAL DRAWINGS FOR ADDITIONAL INFORMATION.
  - I EXPOSED CEILING / STRUCTURE TO BE PAINTED, UNLESS NOTED OTHERWISE.
  - J ALL INTERIOR WALL FINISH TRANSITIONS SHOULD OCCUR AT AN INSIDE CORNER. IF A MATERIAL OR COLOR CHANGE OCCURS AT AN OUTSIDE CORNER, CONTRACTOR SHALL BRING THIS TO THE ATTENTION OF THE ARCHITECT FOR CLARIFICATION.
  - K PRIOR TO FLOORING INSTALLATION, VERIFY SUBFLOOR CONDITIONS MEET MANUFACTURER'S STANDARD REQUIREMENTS.

**FINISH TAG LEGEND**


FLOOR FINISH	A1XX - ROOM NUMBER
REF1	
RB1	
PF1	
FINISH REMARK*	2

\*REMARKS NUMBERS COORDINATE WITH "INTERIOR FINISH REMARKS" NOTES LEGEND ABOVE. MATERIALS NOTED IN FINISH TAG SHOULD BE CONSIDERED THE OVERALL FINISHES IN THE ROOM MARKED UNLESS NOTED OTHERWISE WITH KEYNOTES ON FINISH PLAN OR INTERIOR ELEVATIONS.


- INTERIOR FINISH REMARKS**
- MULTIPLE WALL FINISHES IN THIS ROOM. REFER TO INFORMATION NOTED ON FINISH PLANS AND INTERIOR ELEVATIONS.
  - MULTIPLE FLOOR FINISHES IN THIS ROOM. REFER TO NOTED INFORMATION ON FINISH PLANS.
  - TOUCH UP PAINT AS REQUIRED FROM WALL BASE REMOVAL AND NEW INSTALLATION.

**FLOOR FINISH MATERIAL LEGEND**

EXISTING LVT	EXISTING TERRAZZO
ETR	ETR
LUXURY VINYL TILE 7	
LV7	

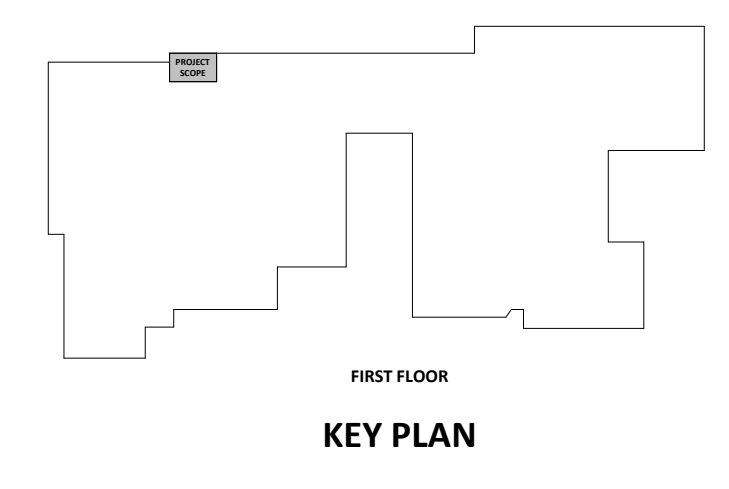

1 FIRST FLOOR FINISH PLAN  
1/4" = 1'-0"

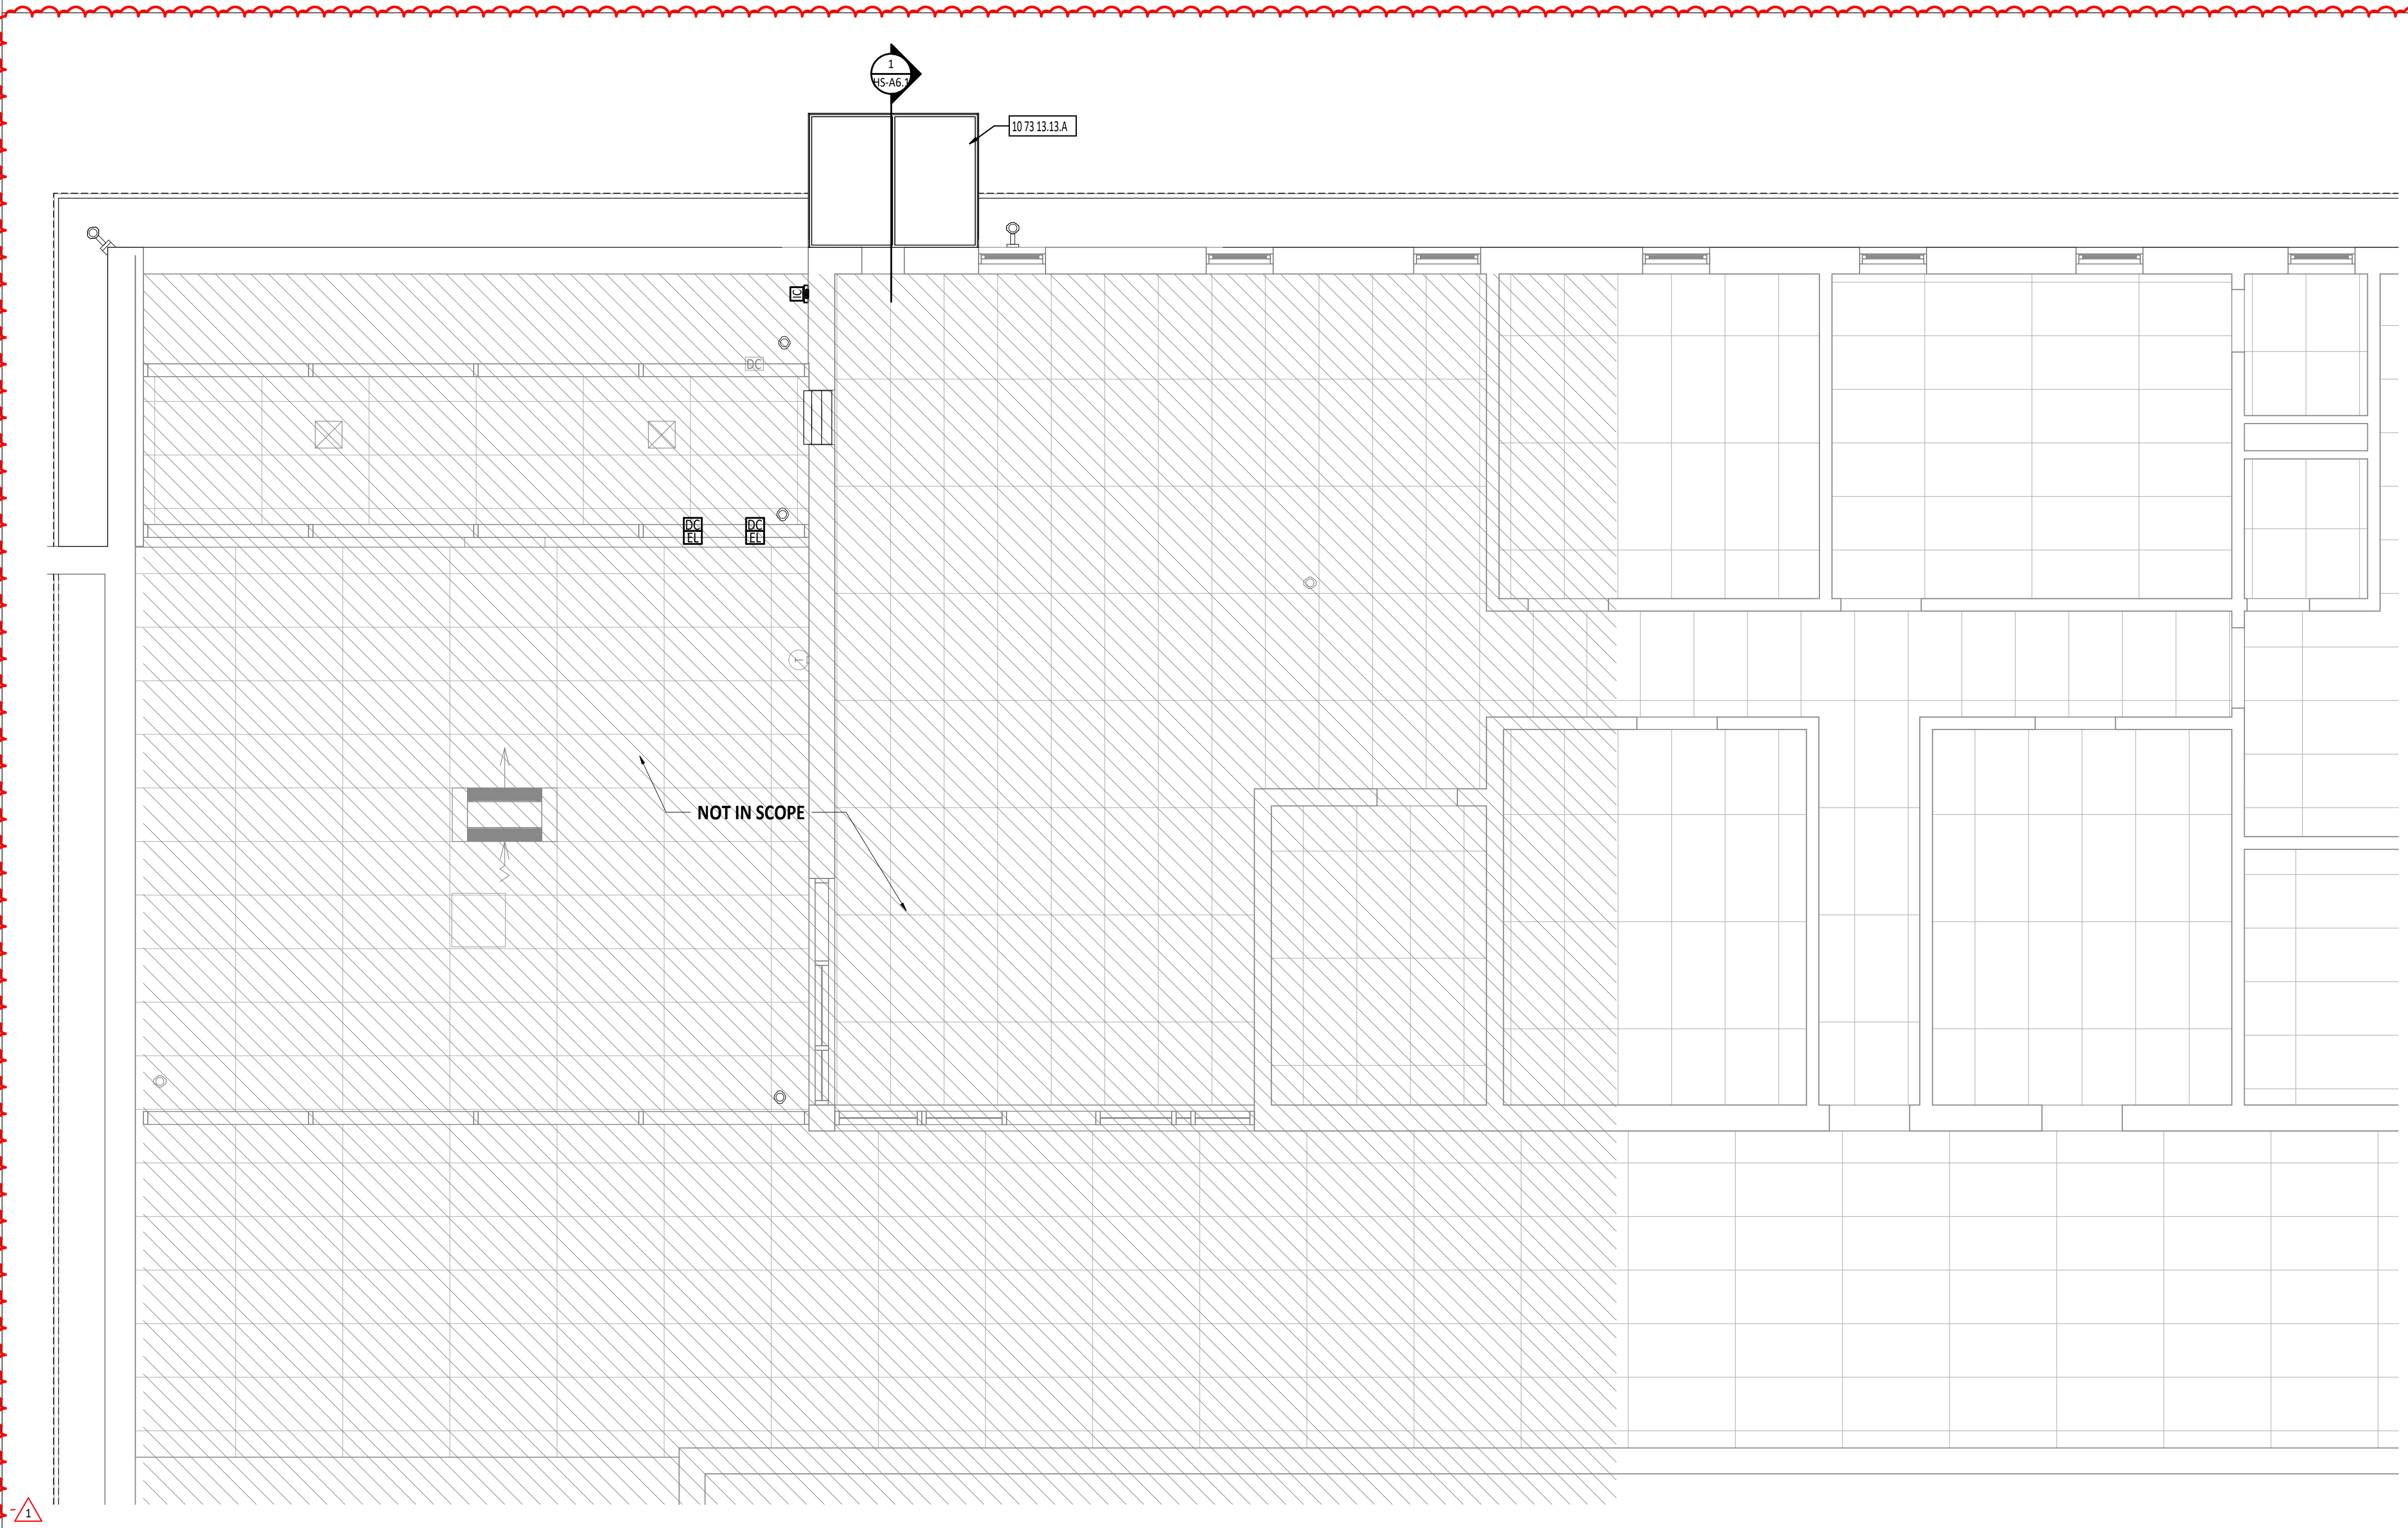

2 FIRST FLOOR REFLECTED CEILING PLAN  
1/4" = 1'-0"

JENNINGS COUNTY SCHOOL CORPORATIONS  
HIGH SCHOOL


**ISSUANCES/REVISIONS**

CONSTRUCTION DOCUMENTS	DATE
1 ADDENDUM #02	04/13/2025

**PROJECT NUMBER: 25064**    **DRAWN BY: CEO**    **CHECKED BY: BAB**


SHEET TITLE:  
**FIRST FLOOR FINISHES PLAN**

SHEET NUMBER:  
**HS-A9.1**

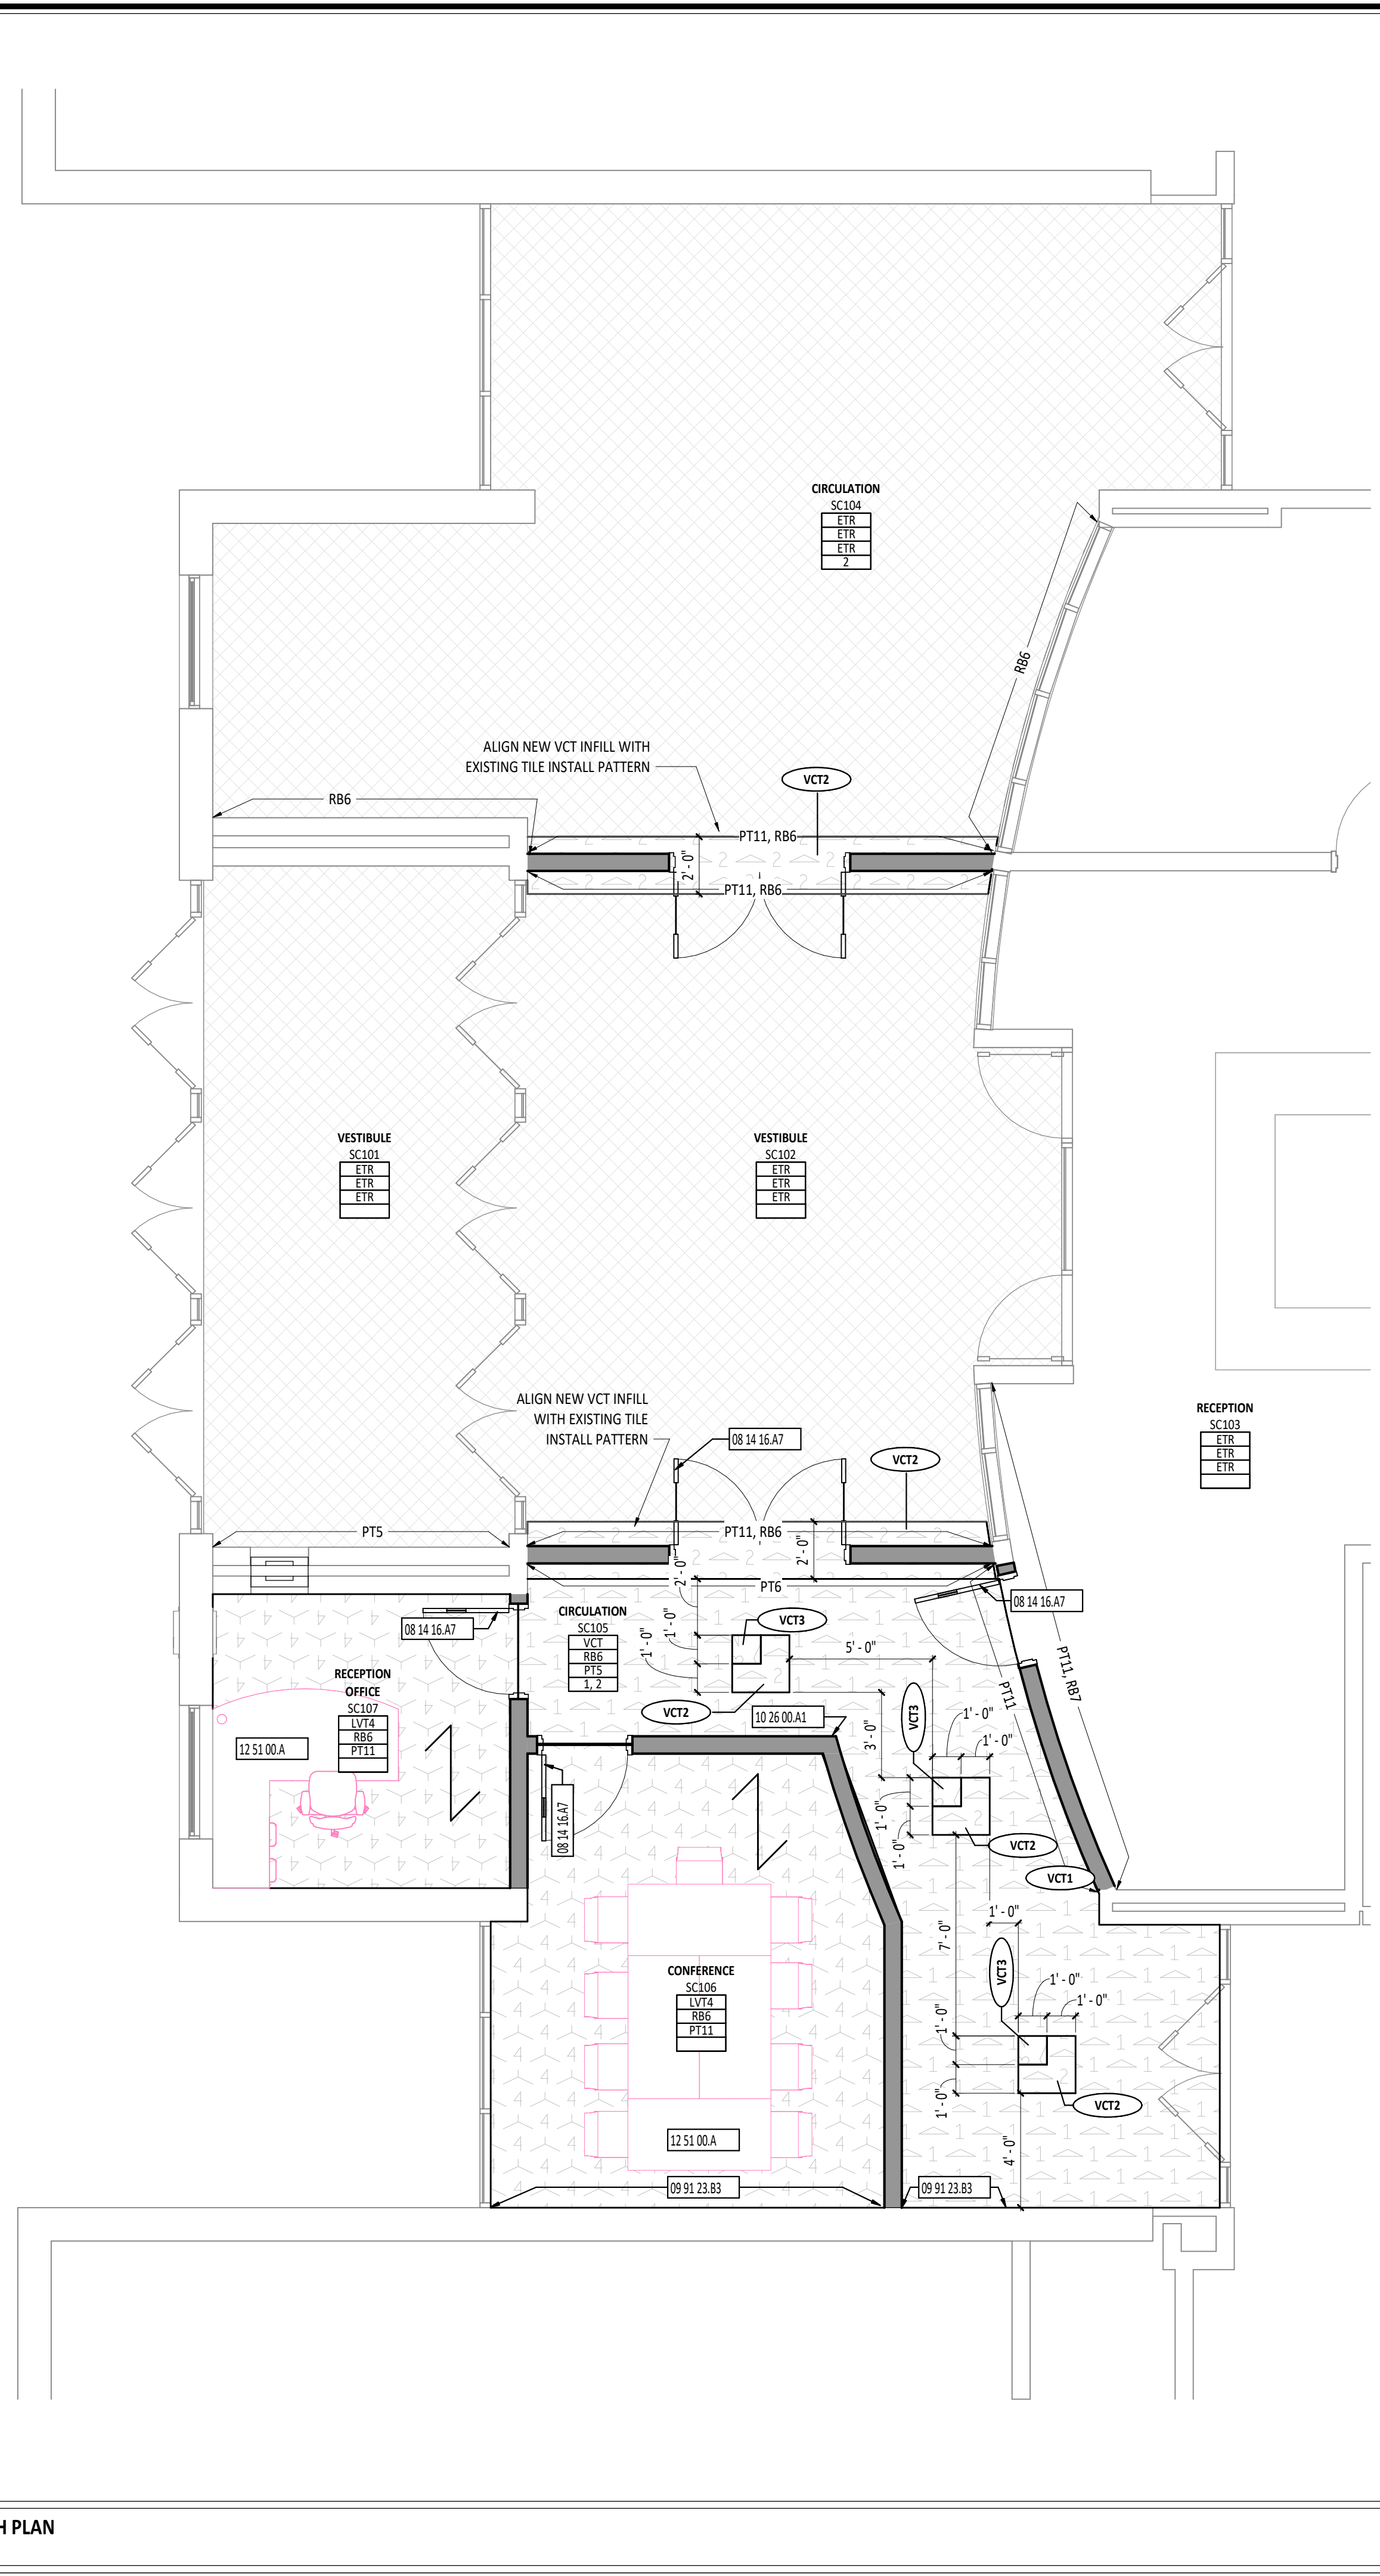

**1**  
SC-A9.1  
FIRST FLOOR FINISH PLAN  
1/4" = 1'-0"

FINISH MATERIAL SCHEDULE						
NAME	MANUFACTURER	STYLE	NUMBER	COLOR	SIZE	COMMENTS
08 14 00 WOOD DOORS		RED OAK		STAIN TO MATCH EXISTING		
09 51 00 ACOUSTICAL CEILINGS - SUSPENSION SYSTEM						
TYPE A	ARMSTRONG	PRELUDE XL		WHITE	15/16" WIDE FACE	DOUBLE WEB CONSTRUCTION, CLASS 1 ZINC COATING, 8 GAUGE STEEL.
09 51 00 ACOUSTICAL CEILINGS - TILE						
TYPE G	ARMSTRONG	SCHOOL ZONE FINE FISSURED	1713	WHITE	2' X 2', 3/4" THICK	SQUARE EDGE, 81% LIGHT REFLECTANCE, .70 MINIMUM NRC, SAG RESISTANT, ANTI-MICROBIAL. USE WITH SUSPENSION SYSTEM TYPE A. CORRESPONDS WITH CEILING "TYPE G" ON REFLECTED CEILING PLAN.
09 65 00 RESILIENT FLOORING - LUXURY VINYL TILE						
LV14	PATCRAFT	HIGHLAND FOREST 6"	1800V-0291	BAMBOO GOLDEN	6' X 48"	
09 65 00 RESILIENT FLOORING - VINYL COMPOSITION TILE						
VCT1	ARMSTRONG	STANDARD EXCELRON IMPERIAL	51811	ANTIQUE WHITE	12" X 12"	
VCT2	ARMSTRONG	STANDARD EXCELRON IMPERIAL	51821	CARIBBEAN BLUE	12" X 12"	
VCT3	ARMSTRONG	STANDARD EXCELRON IMPERIAL	51878	GOLDEN	12" X 12"	
09 65 13 RESILIENT BASE AND ACCESSORIES - FLOOR TRANSITIONS						
FLTS	POWERHOLD	2.5MM TO 3MM LVT NO-LIP JOINER		MILL FINISH		
09 65 13 RESILIENT BASE AND ACCESSORIES - RUBBER BASE						
RB6	TARKETT/JOHNSONITE	BASEWORKS RUBBER BASE (TYPE TS)	TH2	BLUE INTENSITY	6" H COVE TOE	
RB7	TARKETT/JOHNSONITE	BASEWORKS RUBBER BASE (TYPE TS)	283	TOAST	6" H COVE TOE	
09 91 23 PAINTING - PAINT						
PT5	SHERWIN WILLIAMS	REFER TO SPECIFICATIONS	SW 7757	HIGH REFLECTIVE WHITE		COLOR TO MATCH EXISTING, VERIFY COLOR MATCH IN FIELD. REFER TO SPECIFICATIONS FOR SHEEN INFORMATION.
PT11	SHERWIN WILLIAMS	REFER TO SPECIFICATIONS		LIGHT GRAY, TO MATCH EXISTING		COLOR TO MATCH EXISTING, VERIFY COLOR MATCH IN FIELD. REFER TO SHERWIN WILLIAMS RECORD FOR COLOR. REFER TO SPECIFICATIONS FOR SHEEN INFORMATION.
PT18	SHERWIN WILLIAMS	REFER TO SPECIFICATIONS	SW 6783	AMALFI		COLOR TO PAINT NEW HOLLOW METAL DOOR FRAMES. COLOR TO MATCH EXISTING. REFER TO SHERWIN WILLIAMS RECORDS FOR COLOR INFORMATION. REFER TO SPECIFICATIONS FOR SHEEN INFORMATION.
PT21	SHERWIN WILLIAMS	REFER TO SPECIFICATIONS		NAVY, TO MATCH EXISTING		COLOR TO MATCH EXISTING NAVY ACCENT IN SCHOOL CORRIDORS, VERIFY COLOR MATCH IN FIELD. REFER TO SHERWIN WILLIAMS RECORD FOR COLOR. REFER TO SPECIFICATIONS FOR SHEEN INFORMATION.
10 26 00 DOOR AND WALL PROTECTION - CORNER GUARD						
CG1	ACROVYN	SM-20MN	260	MISTY GRAY	4" TALL, 3" WINGS, 110 DEGREES	
CG2	ACROVYN	SM-20MN	260	MISTY GRAY	4" TALL, 3" WINGS, 160 DEGREES	
12 36 00 COUNTERTOPS - PLASTIC LAMINATE						
LTZ	WILSONART	STANDARD HPL	0503-60	CEMENT		MATTE FINISH

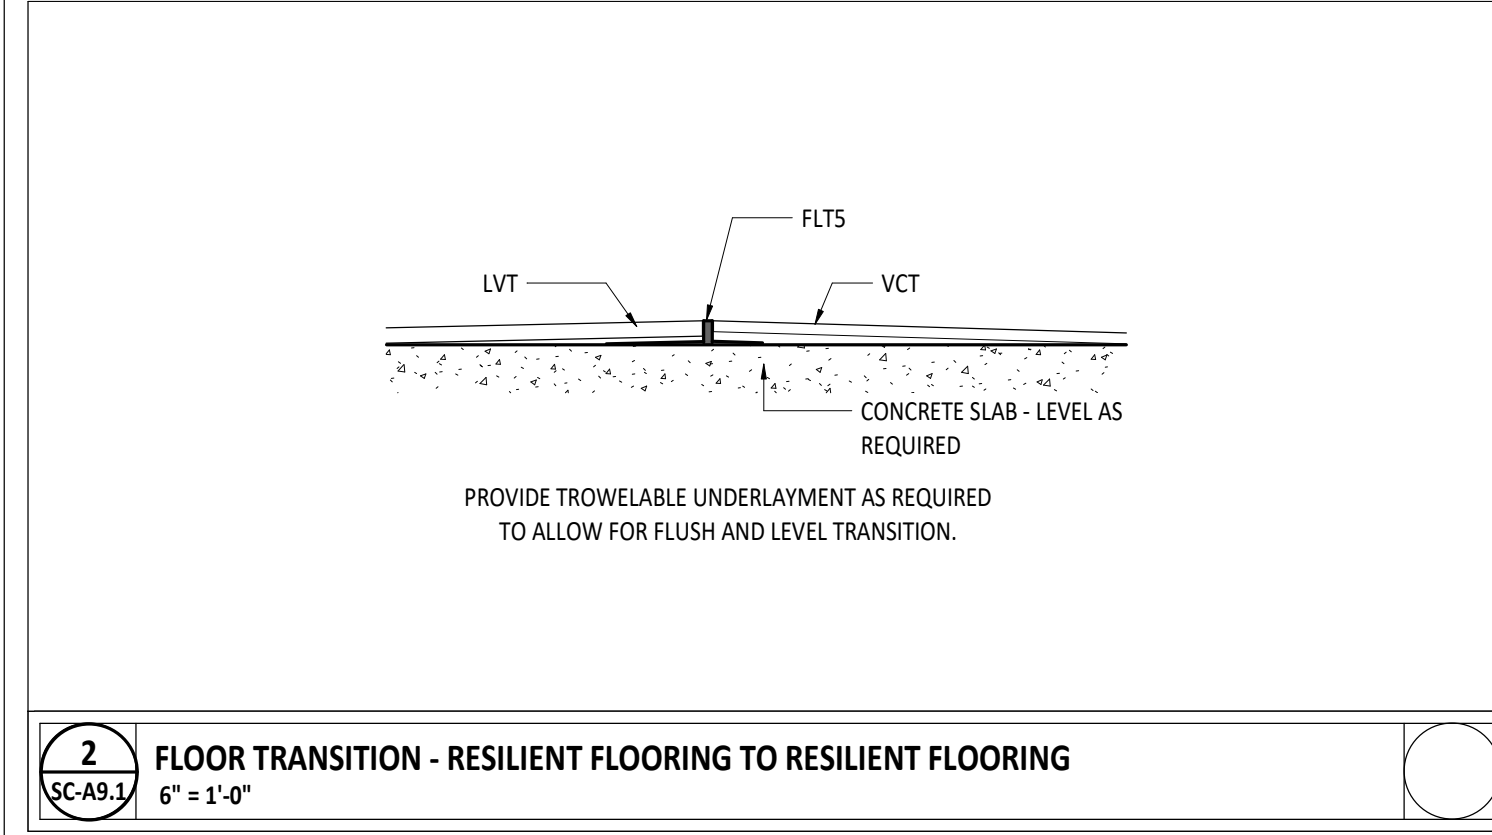

**2**  
SC-A9.1  
FLOOR TRANSITION - RESILIENT FLOORING TO RESILIENT FLOORING  
6" = 1'-0"

FIRST FLOOR PLAN ROOM INDEX - OVERALL				
ROOM NUMBER	ROOM NAME	ID	AREA	OCCUPANCY
SC101	VESTIBULE		247 SF	
SC102	VESTIBULE		409 SF	
SC103	RECEPTION		687 SF	7
SC104	CIRCULATION		591 SF	
SC105	CIRCULATION		262 SF	
SC106	CONFERENCE		196 SF	10
SC107	RECEPTION OFFICE		101 SF	
SC108	SRO OFFICE		150 SF	

- FLOOR FINISHES GENERAL NOTES**
- A FLOORING TRANSITIONS AND SEAMS AT DOOR SHALL OCCUR DIRECTLY UNDER THE CENTERLINE OF CLOSED DOOR UNLESS NOTED OTHERWISE.
  - B FLOORING TRANSITIONS ARE TO BE EASED TO ACHIEVE A SMOOTH AND UNIFORM TRANSITION.
  - C TRANSITION STRIPS ARE REQUIRED IN ALL INSTANCES WHERE A FLOOR MATERIAL TRANSITION OCCURS. REFER TO TYPICAL DETAILS ON SHEET A9.D FOR ADDITIONAL INFORMATION.
  - D FLOOR FINISHES SHALL EXTEND UNDER BUILT-IN COUNTER AND EQUIPMENT.
  - E REFERENCE THE FINISH MATERIAL SCHEDULE FOR MANUFACTURERS, TYPES, AND COLOR SELECTIONS.
  - G ALL BASE MATERIALS SHALL BE INSTALLED TIGHT TO FLOORING SURFACE.
  - I REFER TO DIRECTIONAL ARROW ON FINISH FLOOR PLANS WHERE PROVIDED FOR FLOORING INSTALLATION INSTRUCTIONS.
  - K WALL SUPPLY REGISTERS/GRILLES TO BE FIELD PAINTED TO MATCH ADJACENT WALL COLOR. REFERENCE SECTION 23 37 00 AND MECHANICAL DRAWINGS FOR ADDITIONAL INFORMATION.
  - M EXPOSED CEILING / STRUCTURE TO BE PAINTED, UNLESS NOTED OTHERWISE.
  - N ALL INTERIOR WALL FINISH TRANSITIONS SHOULD OCCUR AT AN INSIDE CORNER, IF A MATERIAL OR COLOR CHANGE OCCURS AT AN OUTSIDE CORNER, CONTRACTOR SHALL BRING THIS TO THE ATTENTION OF THE ARCHITECT FOR CLARIFICATION.
  - O PRIOR TO FLOORING INSTALLATION, VERIFY SUBFLOOR CONDITIONS MEET MANUFACTURER'S STANDARD REQUIREMENTS.

#	KEYNOTE DESCRIPTION
08 14 16.47	ALL NEW WOOD DOORS IN THIS BUILDING TO MATCH WDG FINISH UNLESS NOTED OTHERWISE.
09 91 23.B3	ACCENT PAINT PT21 FROM 40" AFF UP TO 56" AFF. PROVIDE SKIM COAT TO SMOOTH WALL AS REQUIRED FROM DISPLAY RAIL REMOVAL.
10 26 00.A1	CORNER GUARD, CG1, REFER TO FINISH MATERIAL SCHEDULE.
12 51 00.A	OWNER PROVIDED LOOSE FURNISHINGS SHOWN IN LIGHT PINK LINE WORK

**FINISH TAG LEGEND**

FINISH	ROOM NUMBER
FLOOR FINISH	RF1
BASE FINISH	RB1
WALL FINISH	PT1
FINISH REMARK*	2



\*REMARKS NUMBERS COORDINATE WITH "INTERIOR FINISH REMARKS" NOTES LEGEND ABOVE

MATERIALS NOTED IN FINISH TAG SHOULD BE CONSIDERED THE OVERALL FINISHES IN THE ROOM MARKED UNLESS NOTED OTHERWISE WITH KEYNOTES ON FINISH PLAN OR INTERIOR ELEVATIONS.

- INTERIOR FINISH REMARKS**
- MULTIPLE WALL FINISHES IN THIS ROOM. REFER TO INFORMATION NOTED ON FINISH PLANS AND INTERIOR ELEVATIONS.
  - MULTIPLE FLOOR FINISHES IN THIS ROOM. REFER TO NOTED INFORMATION ON FINISH PLANS.

**FLOOR FINISH MATERIAL LEGEND**

	EXISTING VCT		VCT3
	VCT1		LUXURY VINYL TILE 4
	VCT2		LVT4
	VCT2		FLOORING INSTALLATION DIRECTION INDICATOR

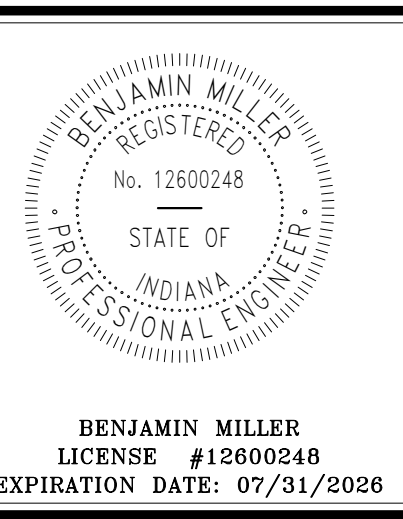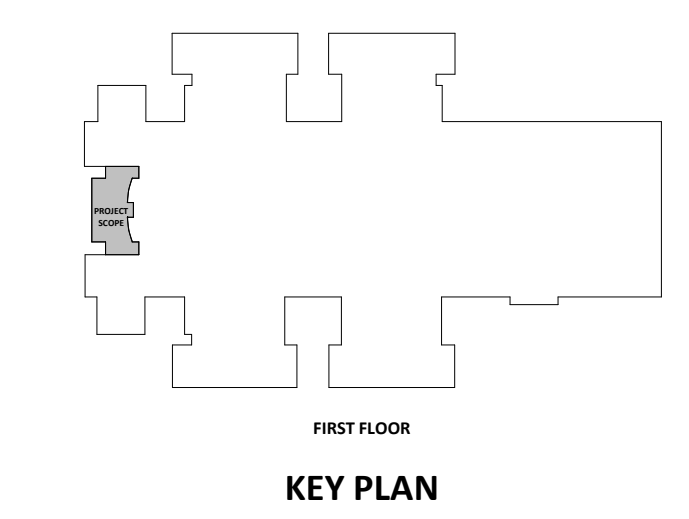

**JENNINGS COUNTY SCHOOL CORPORATIONS**  
**SAND CREEK**

**ISSUANCES/REVISIONS**

CONSTRUCTION DOCUMENTS	DATE
1 ADDENDUM #02	04/13/2026

PROJECT NUMBER:	DRAWN BY:	CHECKED BY:
25064	CEO	BAB

SHEET TITLE:  
**FIRST FLOOR FINISHES PLAN**

SHEET NUMBER:  
**SC-A9.1**